


3/28/2017 8:26:27 AM
R:\Roadway\Proj\670189_r.dgn
jor+66165

TIP PROJECT: 17BP.7.R.98

CONTRACT:

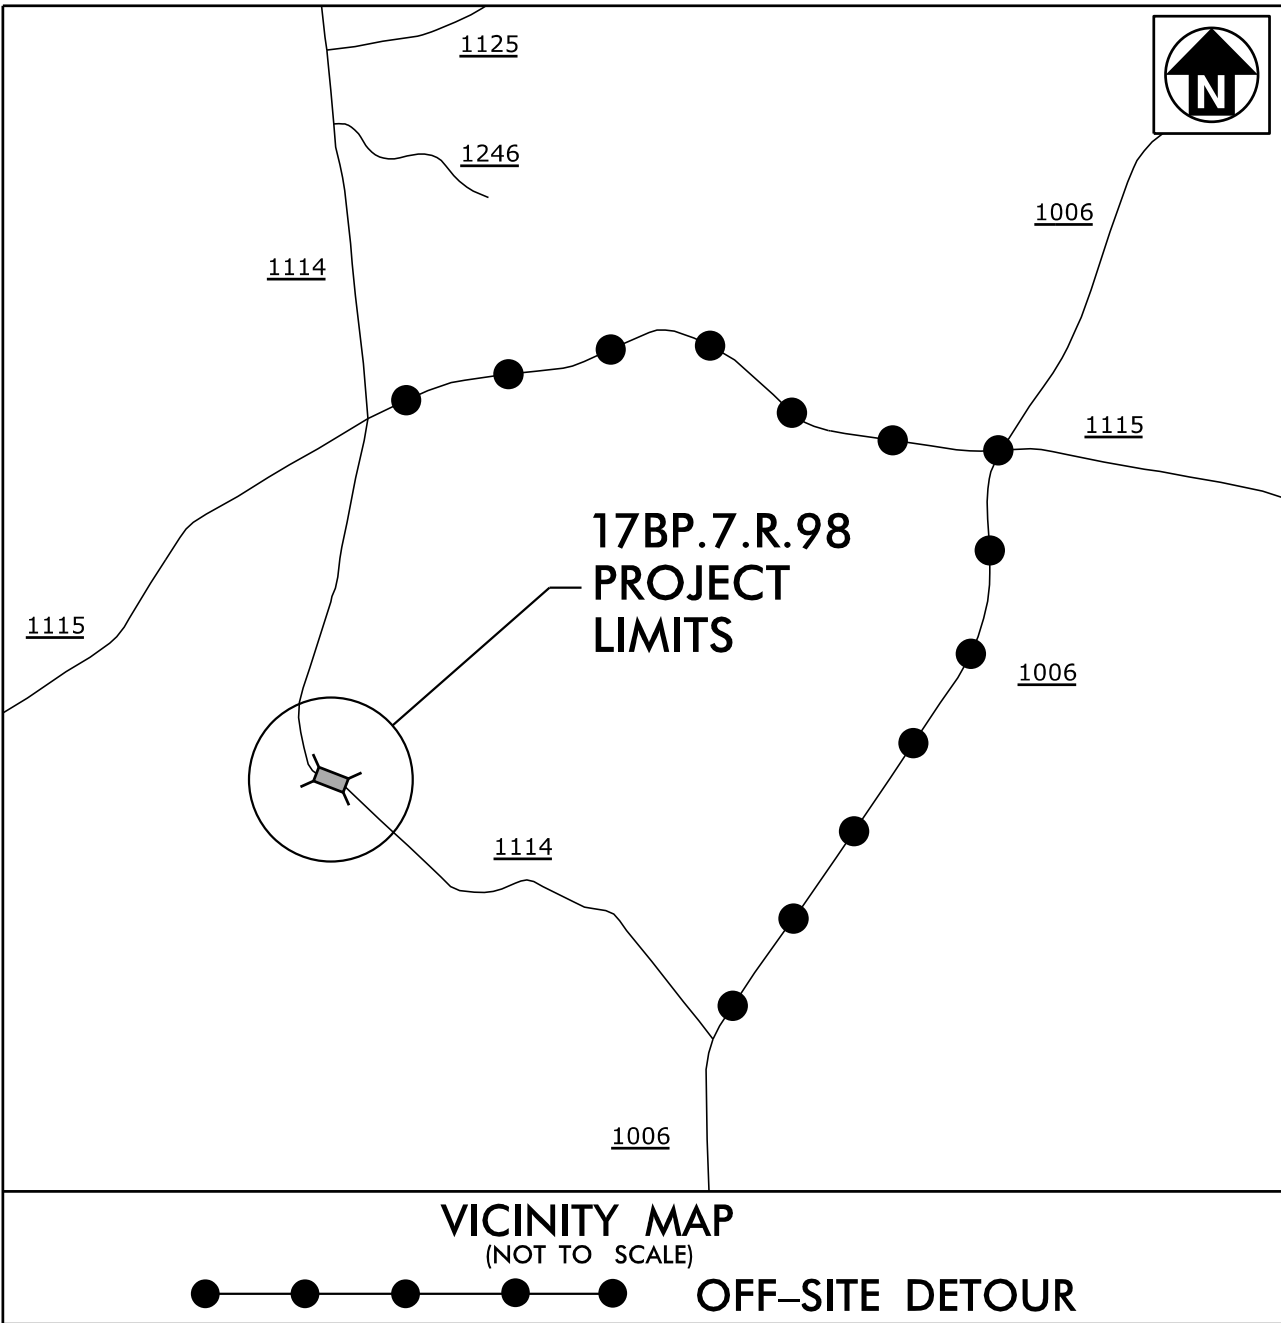


STATE OF NORTH CAROLINA
DIVISION OF HIGHWAYS
ORANGE COUNTY

LOCATION: BRIDGE NO. 189 OVER CANE CREEK ON SR 1114 (BUCKHORN ROAD)


TYPE OF WORK: GRADING, PAVING, DRAINAGE AND STRUCTURE

STATE	STATE PROJECT REFERENCE NO.	SHEET NO.	TOTAL SHEETS
N.C.	17BP.7.R.98	1	
STATE PROJECT NO.	F.A. PROJ. NO.	DESCRIPTION	

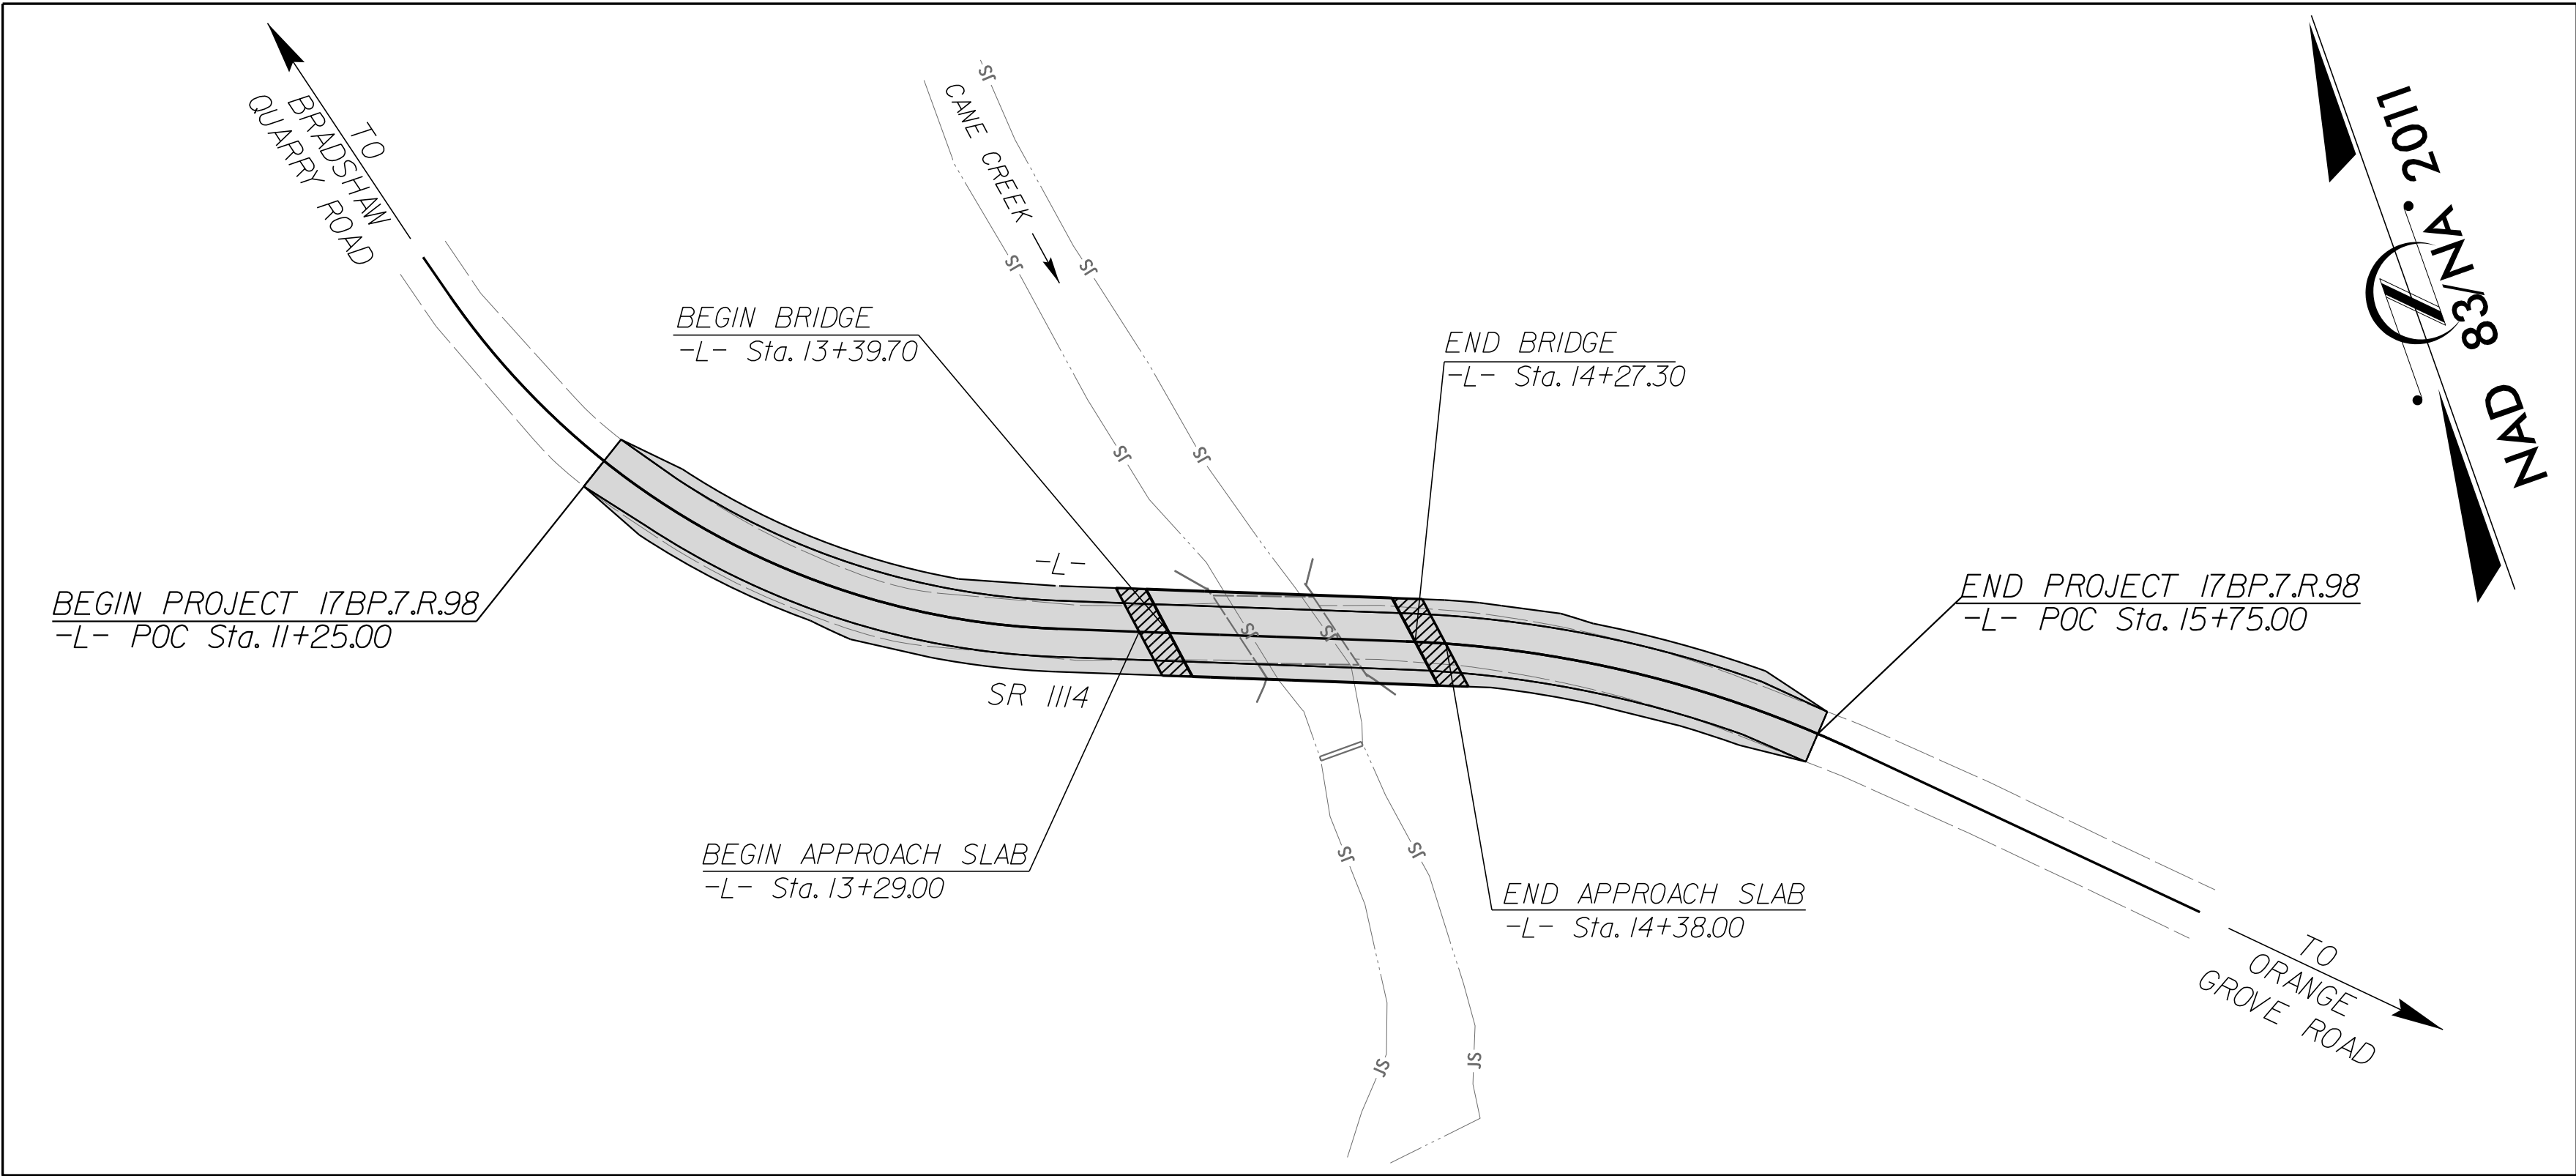

*DESIGN EXCEPTION:
MIN. HORIZONTAL CURVE RADIUS
SAG VERTICAL CURVE K
HORIZONTAL SSD
VERTICAL SSD
SUPERELEVATION

DOCUMENT NOT CONSIDERED FINAL
UNLESS ALL SIGNATURES COMPLETED

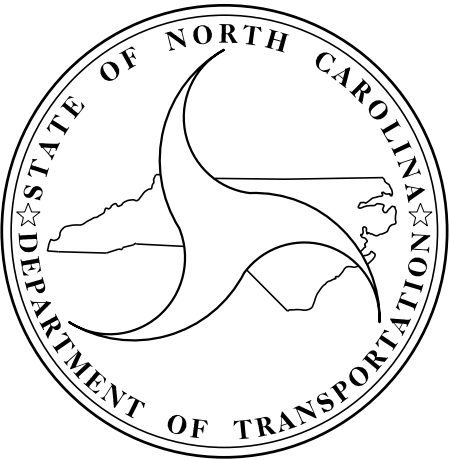

DESIGN DATA

ADT 2011 = 770

ADT 2025 = 1540

V = 55 MPH

SUB REGIONAL TIER
LOCAL

PROJECT LENGTH

LENGTH ROADWAY TIP PROJECT = 0.068 MILES

LENGTH STRUCTURE TIP PROJECT = 0.017 MILES

TOTAL LENGTH TIP PROJECT = 0.085 MILES

Prepared In the Office of Hatch Mott MacDonald for

DIVISION 7

NORTH CAROLINA DEPARTMENT OF TRANSPORTATION

2012 STANDARD SPECIFICATIONS

LETTING DATE:


TIM JORDAN, PE
PROJECT ENGINEER

DAVID FUH, PE
HYDRAULICS ENGINEER

NCDOT CONTACT:

TIM POWERS, PE
DIVISION BRIDGE
PROGRAM MANAGER


ROADWAY DESIGN ENGINEER

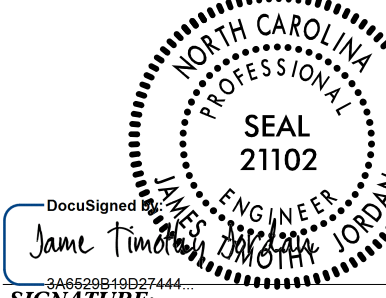

3/28/2017

P.E.

HYDRAULICS ENGINEER

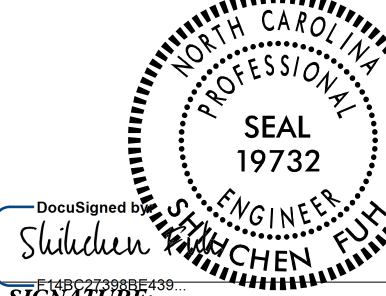

3/28/2017


P.E.

PLANS PREPARED BY:

M
MOTT
MACDONALD

PO Box 700
Fuquay-Varina, NC 27526
(919) 552-2253
(919) 552-2254 (Fax)
www.mottmac.com

LICENSE NO. F-0669

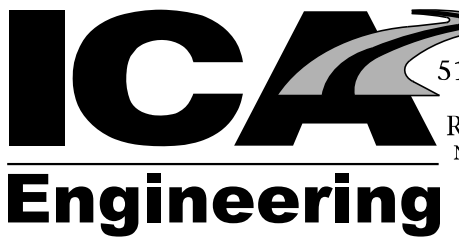

5121 Kingdom Way,
Suite 100
Raleigh, NC 27607
NC License No. F-0258

GENERAL NOTES:

2012 SPECIFICATIONS
EFFECTIVE: 01-17-2012
REVISED: 01-24-2017

GRADE LINE:
GRADING AND SURFACING:

THE GRADE LINES SHOWN DENOTE THE FINISHED ELEVATION OF THE PROPOSED SURFACING AT GRADE POINTS SHOWN ON THE TYPICAL SECTIONS. GRADE LINES MAY BE ADJUSTED AT THEIR BEGINNING AND ENDING AND AT STRUCTURES AS DIRECTED BY THE ENGINEER IN ORDER TO SECURE A PROPER TIE-IN.

CLEARING:

CLEARING ON THIS PROJECT SHALL BE PERFORMED TO THE LIMITS ESTABLISHED BY METHOD II.

SUPERELEVATION:

ALL CURVES ON THIS PROJECT SHALL BE SUPERELEVATED IN ACCORDANCE WITH STD. NO. 225.04 USING THE RATE OF SUPERELEVATION AND RUNOFF SHOWN ON THE PLANS. SUPERELEVATION IS TO BE REVOLVED ABOUT THE GRADE POINTS SHOWN ON THE TYPICAL SECTIONS.

SHOULDER CONSTRUCTION:

ASPHALT, EARTH, AND CONCRETE SHOULDER CONSTRUCTION ON THE HIGH SIDE OF SUPERELEVATED CURVES SHALL BE IN ACCORDANCE WITH STD. NO. 560.01

GUARDRAIL:

THE GUARDRAIL LOCATIONS SHOWN ON THE PLANS MAY BE ADJUSTED DURING CONSTRUCTION AS DIRECTED BY THE ENGINEER. THE CONTRACTOR SHOULD CONSULT WITH THE ENGINEER PRIOR TO ORDERING GUARDRAIL MATERIAL.

SUBSURFACE PLANS:

NO SUBSURFACE PLANS ARE AVAILABLE ON THIS PROJECT. THE CONTRACTOR SHOULD MAKE HIS OWN INVESTIGATION AS TO THE SUBSURFACE CONDITIONS.

END BENTS:

THE ENGINEER SHALL CHECK THE STRUCTURE END BENT PLANS, DETAILS, AND CROSS-SECTION PRIOR TO SETTING OF THE SLOPE STAKES FOR THE EMBANKMENT OR EXCAVATION APPROACHING A BRIDGE.

UTILITIES:

UTILITY OWNERS ON THIS PROJECT ARE DUKE ENERGY, AND PIEDMONT ELECTRIC MEMBERSHIP CORPORATION.

ANY RELOCATION OF EXISTING UTILITIES WILL BE ACCOMPLISHED BY OTHERS.

INDEX OF SHEETS

SHEET NUMBER

DESCRIPTION

1

TITLE SHEET

1-A

INDEX OF SHEETS, GENERAL NOTES, AND LIST OF STANDARD DRAWINGS

1-B

CONVENTIONAL SYMBOLS

2

PAVEMENT SCHEDULE AND TYPICAL SECTIONS

2-A

DETAIL FOR STRUCTURE ANCHOR UNITS

3

GUARDRAIL, DRAINAGE & EARTHWORK SUMMARY

4

PLAN SHEET AND PROFILE SHEET

TMP-1 THRU TMP-3

TRAFFIC MANAGEMENT PLANS

EC-1 THRU EC-5

EROSION CONTROL PLANS

RF-1

REFORESTATION PLAN

UO-1

UTILITIES BY OTHERS PLAN

X-1 THRU X-6

CROSS-SECTIONS

S-1 THRU S-19

STRUCTURE PLANS

SN

STRUCTURE NOTES

EFF. 01-17-2012
REV. 02-29-2016

2012 ROADWAY ENGLISH STANDARD DRAWINGS

The following Roadway Standards as appear in "Roadway Standard Drawings" Highway Design Branch - N. C. Department of Transportation - Raleigh, N. C., Dated January, 2012 are applicable to this project and by reference hereby are considered a part of these plans:

STD.NO.

TITLE

DIVISION 2 - EARTHWORK

200.03 Method of Clearing - Method III
225.02 Guide for Grading Subgrade - Secondary and Local
225.04 Method of Obtaining Superelevation - Two Lane Pavement

DIVISION 3 - PIPE CULVERTS

300.01 Method of Pipe Installation

DIVISION 4 - MAJOR STRUCTURES



422.11 Reinforced Bridge Approach Fills - Sub Regional Tier

DIVISION 5 - SUBGRADE, BASES AND SHOULDERS

560.01 Method of Shoulder Construction - High Side of Superelevated Curve - Method I

DIVISION 8 - INCIDENTALS

840.00 Concrete Base Pad for Drainage Structures
840.18 Concrete Grated Drop Inlet Type 'B' - 12" thru 36" Pipe
840.25 Anchorage for Frames - Brick or Concrete or Precast
840.27 Brick Grated Drop Inlet Type 'B' - 12" thru 36" Pipe
840.29 Frames and Narrow Slot Flat Grates
840.66 Drainage Structure Steps
846.01 Concrete Curb, Gutter and Curb & Gutter
846.04 Drop Inlet Installation in Shoulder Berm Gutter
862.01 Guardrail Placement
862.02 Guardrail Installation
876.02 Guide for Rip Rap at Pipe Outlets

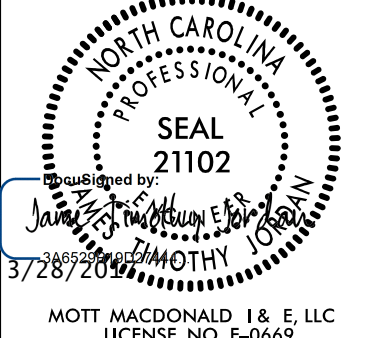PROJECT REFERENCE		SHEET NO.	
17BP.7.R.98 - ORANGE 189		1-A	
ROADWAY DESIGN ENGINEER			
MOTT MACDONALD 1 & E, LLC LICENSE NO. E-0669			
DOCUMENT NOT CONSIDERED FINAL UNLESS ALL SIGNATURES COMPLETED			
Prepared in the Office of:		 MOTT MACDONALD	
		PO Box 700 Fuquay-Varina, NC 27526 www.mottmac.com	

Note: Not to Scale

**S.U.E. = Subsurface Utility Engineering*

STATE OF NORTH CAROLINA
DIVISION OF HIGHWAYS

PROJECT REFERENCE	SHEET NO.
17BP.7.R.98 - ORANGE 189	1-B

CONVENTIONAL PLAN SHEET SYMBOLS

BOUNDARIES AND PROPERTY:

State Line	
County Line	
Township Line	
City Line	
Reservation Line	
Property Line	
Existing Iron Pin	
Property Corner	
Property Monument	
Parcel/Sequence Number	
Existing Fence Line	
Proposed Woven Wire Fence	
Proposed Chain Link Fence	
Proposed Barbed Wire Fence	
Existing Wetland Boundary	
Proposed Wetland Boundary	
Existing Endangered Animal Boundary	
Existing Endangered Plant Boundary	
Known Soil Contamination: Area or Site	
Potential Soil Contamination: Area or Site	

BUILDINGS AND OTHER CULTURE:

Gas Pump Vent or U/G Tank Cap	
Sign	
Well	
Small Mine	
Foundation	
Area Outline	
Cemetery	
Building	
School	
Church	
Dam	

HYDROLOGY:

Stream or Body of Water	
Hydro, Pool or Reservoir	
Jurisdictional Stream	
Buffer Zone 1	
Buffer Zone 2	
Flow Arrow	
Disappearing Stream	
Spring	
Wetland	
Proposed Lateral, Tail, Head Ditch	
False Sump	

RAILROADS:

Standard Gauge	
RR Signal Milepost	
Switch	
RR Abandoned	
RR Dismantled	

RIGHT OF WAY:

Baseline Control Point	
Existing Right of Way Marker	
Existing Right of Way Line	
Proposed Right of Way Line	
Proposed Right of Way Line with Iron Pin and Cap Marker	
Proposed Right of Way Line with Concrete or Granite R/W Marker	
Proposed Control of Access Line with Concrete C/A Marker	
Existing Control of Access	
Proposed Control of Access	
Existing Easement Line	
Proposed Temporary Construction Easement	
Proposed Temporary Drainage Easement	
Proposed Permanent Drainage Easement	
Proposed Permanent Drainage /Utility Easement	
Proposed Permanent Utility Easement	
Proposed Temporary Utility Easement	
Proposed Aerial Utility Easement	

Proposed Permanent Easement with Iron Pin and Cap Marker

ROADS AND RELATED FEATURES:

Existing Edge of Pavement	
Existing Curb	
Proposed Slope Stakes Cut	
Proposed Slope Stakes Fill	
Proposed Curb Ramp	
Existing Metal Guardrail	
Proposed Guardrail	
Existing Cable Guiderail	
Proposed Cable Guiderail	

Equality Symbol	
Pavement Removal	
Single Tree	
Single Shrub	
Hedge	
Woods Line	

VEGETATION:

Orchard	
Vineyard	

EXISTING STRUCTURES:

MAJOR: Bridge, Tunnel or Box Culvert	
Bridge Wing Wall, Head Wall and End Wall	
MINOR: Head and End Wall	
Pipe Culvert	
Footbridge	
Drainage Box: Catch Basin, DI or JB	
Paved Ditch Gutter	
Storm Sewer Manhole	
Storm Sewer	

UTILITIES:

POWER: Existing Power Pole	
Proposed Power Pole	
Existing Joint Use Pole	
Proposed Joint Use Pole	
Power Manhole	
Power Line Tower	
Power Transformer	
U/G Power Cable Hand Hole	
H-Frame Pole	
Recorded U/G Power Line	
Designated U/G Power Line (S.U.E.*)	

TELEPHONE:

Existing Telephone Pole	
Proposed Telephone Pole	
Telephone Manhole	
Telephone Booth	
Telephone Pedestal	
Telephone Cell Tower	
U/G Telephone Cable Hand Hole	
Recorded U/G Telephone Cable	
Designated U/G Telephone Cable (S.U.E.*)	
Recorded U/G Telephone Conduit	
Designated U/G Telephone Conduit (S.U.E.*)	
Recorded U/G Fiber Optics Cable	
Designated U/G Fiber Optics Cable (S.U.E.*)	

WATER:

Water Manhole	
Water Meter	
Water Valve	
Water Hydrant	
Recorded U/G Water Line	
Designated U/G Water Line (S.U.E.*)	
Above Ground Water Line	

TV:

TV Satellite Dish	
TV Pedestal	
TV Tower	
U/G TV Cable Hand Hole	
Recorded U/G TV Cable	
Designated U/G TV Cable (S.U.E.*)	
Recorded U/G Fiber Optic Cable	
Designated U/G Fiber Optic Cable (S.U.E.*)	

GAS:

Gas Valve	
Gas Meter	
Recorded U/G Gas Line	
Designated U/G Gas Line (S.U.E.*)	
Above Ground Gas Line	

SANITARY SEWER:

Sanitary Sewer Manhole	
Sanitary Sewer Cleanout	
U/G Sanitary Sewer Line	
Above Ground Sanitary Sewer	
Recorded SS Forced Main Line	
Designated SS Forced Main Line (S.U.E.*)	

MISCELLANEOUS:

Utility Pole	
Utility Pole with Base	
Utility Located Object	
Utility Traffic Signal Box	
Utility Unknown U/G Line	
U/G Tank; Water, Gas, Oil	
Underground Storage Tank, Approx. Loc.	
A/G Tank; Water, Gas, Oil	
Geoenvironmental Boring	
U/G Test Hole (S.U.E.*)	
Abandoned According to Utility Records	
End of Information	



-L- STA 11+25.00 TO 11+50.00

-L- STA 14+27.30 (END BRIDGE) TO 15+50.00

-L- STA 15+50.00 TO 15+75.00



-L- STA 13+39.70 (BEGIN BRIDGE) TO 14+27.30 (END BRIDGE)


NOTE: SEE STRUCTURE PLANS FOR PAVEMENT DEPTHS ON STRUCTURE

PAVEMENT SCHEDULE	
C1	PROP. APPROX. 3" ASPHALT CONCRETE SURFACE COURSE, TYPE S9.5B, AT AN AVERAGE RATE OF 168 LBS. PER SQ. YD. IN EACH OF TWO LAYERS.
C2	PROP. VAR. DEPTH ASPHALT CONCRETE SURFACE COURSE, TYPE S9.5B, AT AN AVERAGE RATE OF 112 LBS. PER SQ. YD. PER 1" DEPTH. TO BE PLACED IN LAYERS NOT LESS THAN 1½" IN DEPTH OR GREATER THAN 2" IN DEPTH.
D1	PROP. APPROX. 2½" ASPHALT CONCRETE INTERMEDIATE COURSE, TYPE I19.0B, AT AN AVERAGE RATE OF 285 LBS. PER SQ. YD.
E1	PROP. APPROX. 4" ASPHALT CONCRETE BASE COURSE, TYPE B25.0B, AT AN AVERAGE RATE OF 456 LBS. PER SQ. YD.
T	EARTH MATERIAL.

NOTE: PAVEMENT EDGE SLOPES ARE 1:1 UNLESS SHOWN OTHERWISE.

STATE OF
NORTH CAROLINA
DEPT. OF TRANSPORTATION
DIVISION OF HIGHWAYS
RALEIGH, N.C.

ENGLISH DETAIL DRAWING FOR
STRUCTURE ANCHOR UNITS
GUARDRAIL ANCHOR UNIT, TYPE III

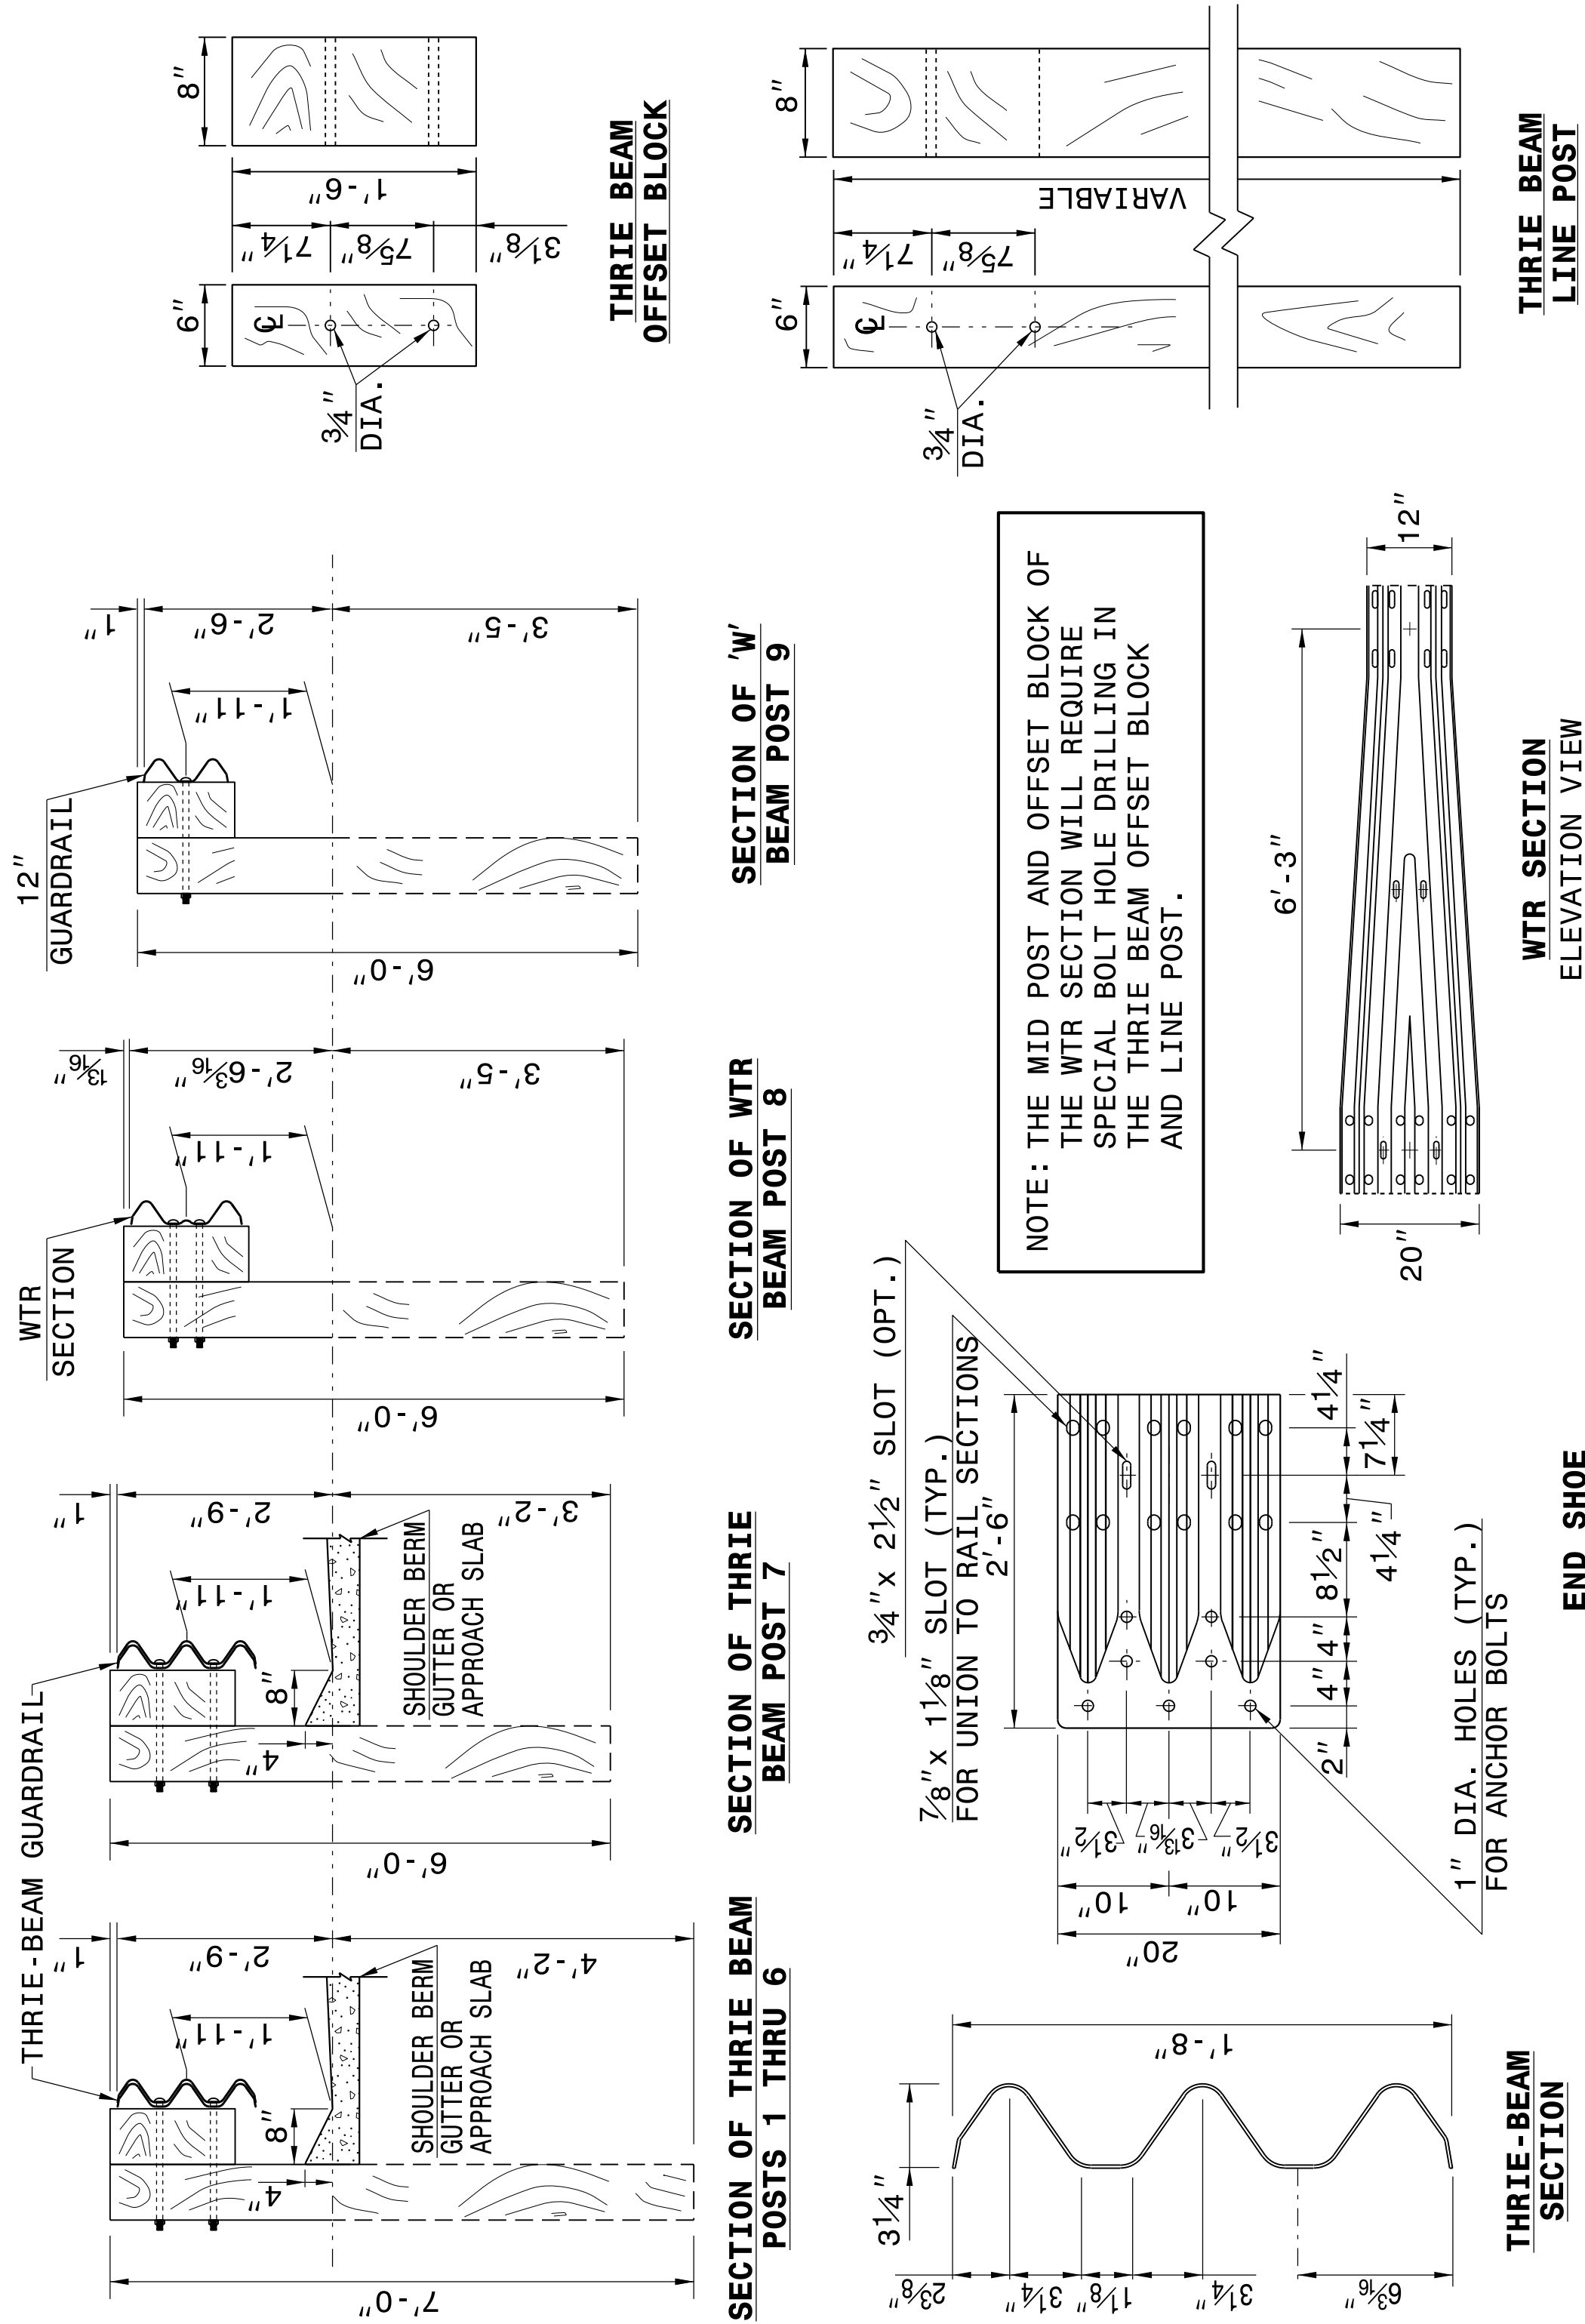

SHEET 3 OF 7


STATE OF
NORTH CAROLINA
DEPT. OF TRANSPORTATION
DIVISION OF HIGHWAYS
RALEIGH, N.C.

ENGLISH DETAIL DRAWING FOR
STRUCTURE ANCHOR UNITS
GUARDRAIL ANCHOR UNIT, TYPE III

ORIGINAL BY: J HOWERTON DATE: 06-22-12
MODIFIED BY: DATE: _____
CHECKED BY: DATE: _____
FILE SPEC.: _____

ENGLISH DETAIL DRAWING FOR
STRUCTURE ANCHOR UNITS
 GUARDRAIL ANCHOR UNIT, TYPE III FOR ATTACHMENT TO
 RAIL ON BRIDGE - SUB REGIONAL TIER

**GUARDRAIL ANCHOR UNIT, TYPE III FOR ATTACHMENT TO
RAIL ON BRIDGE - SUB REGIONAL TIER**

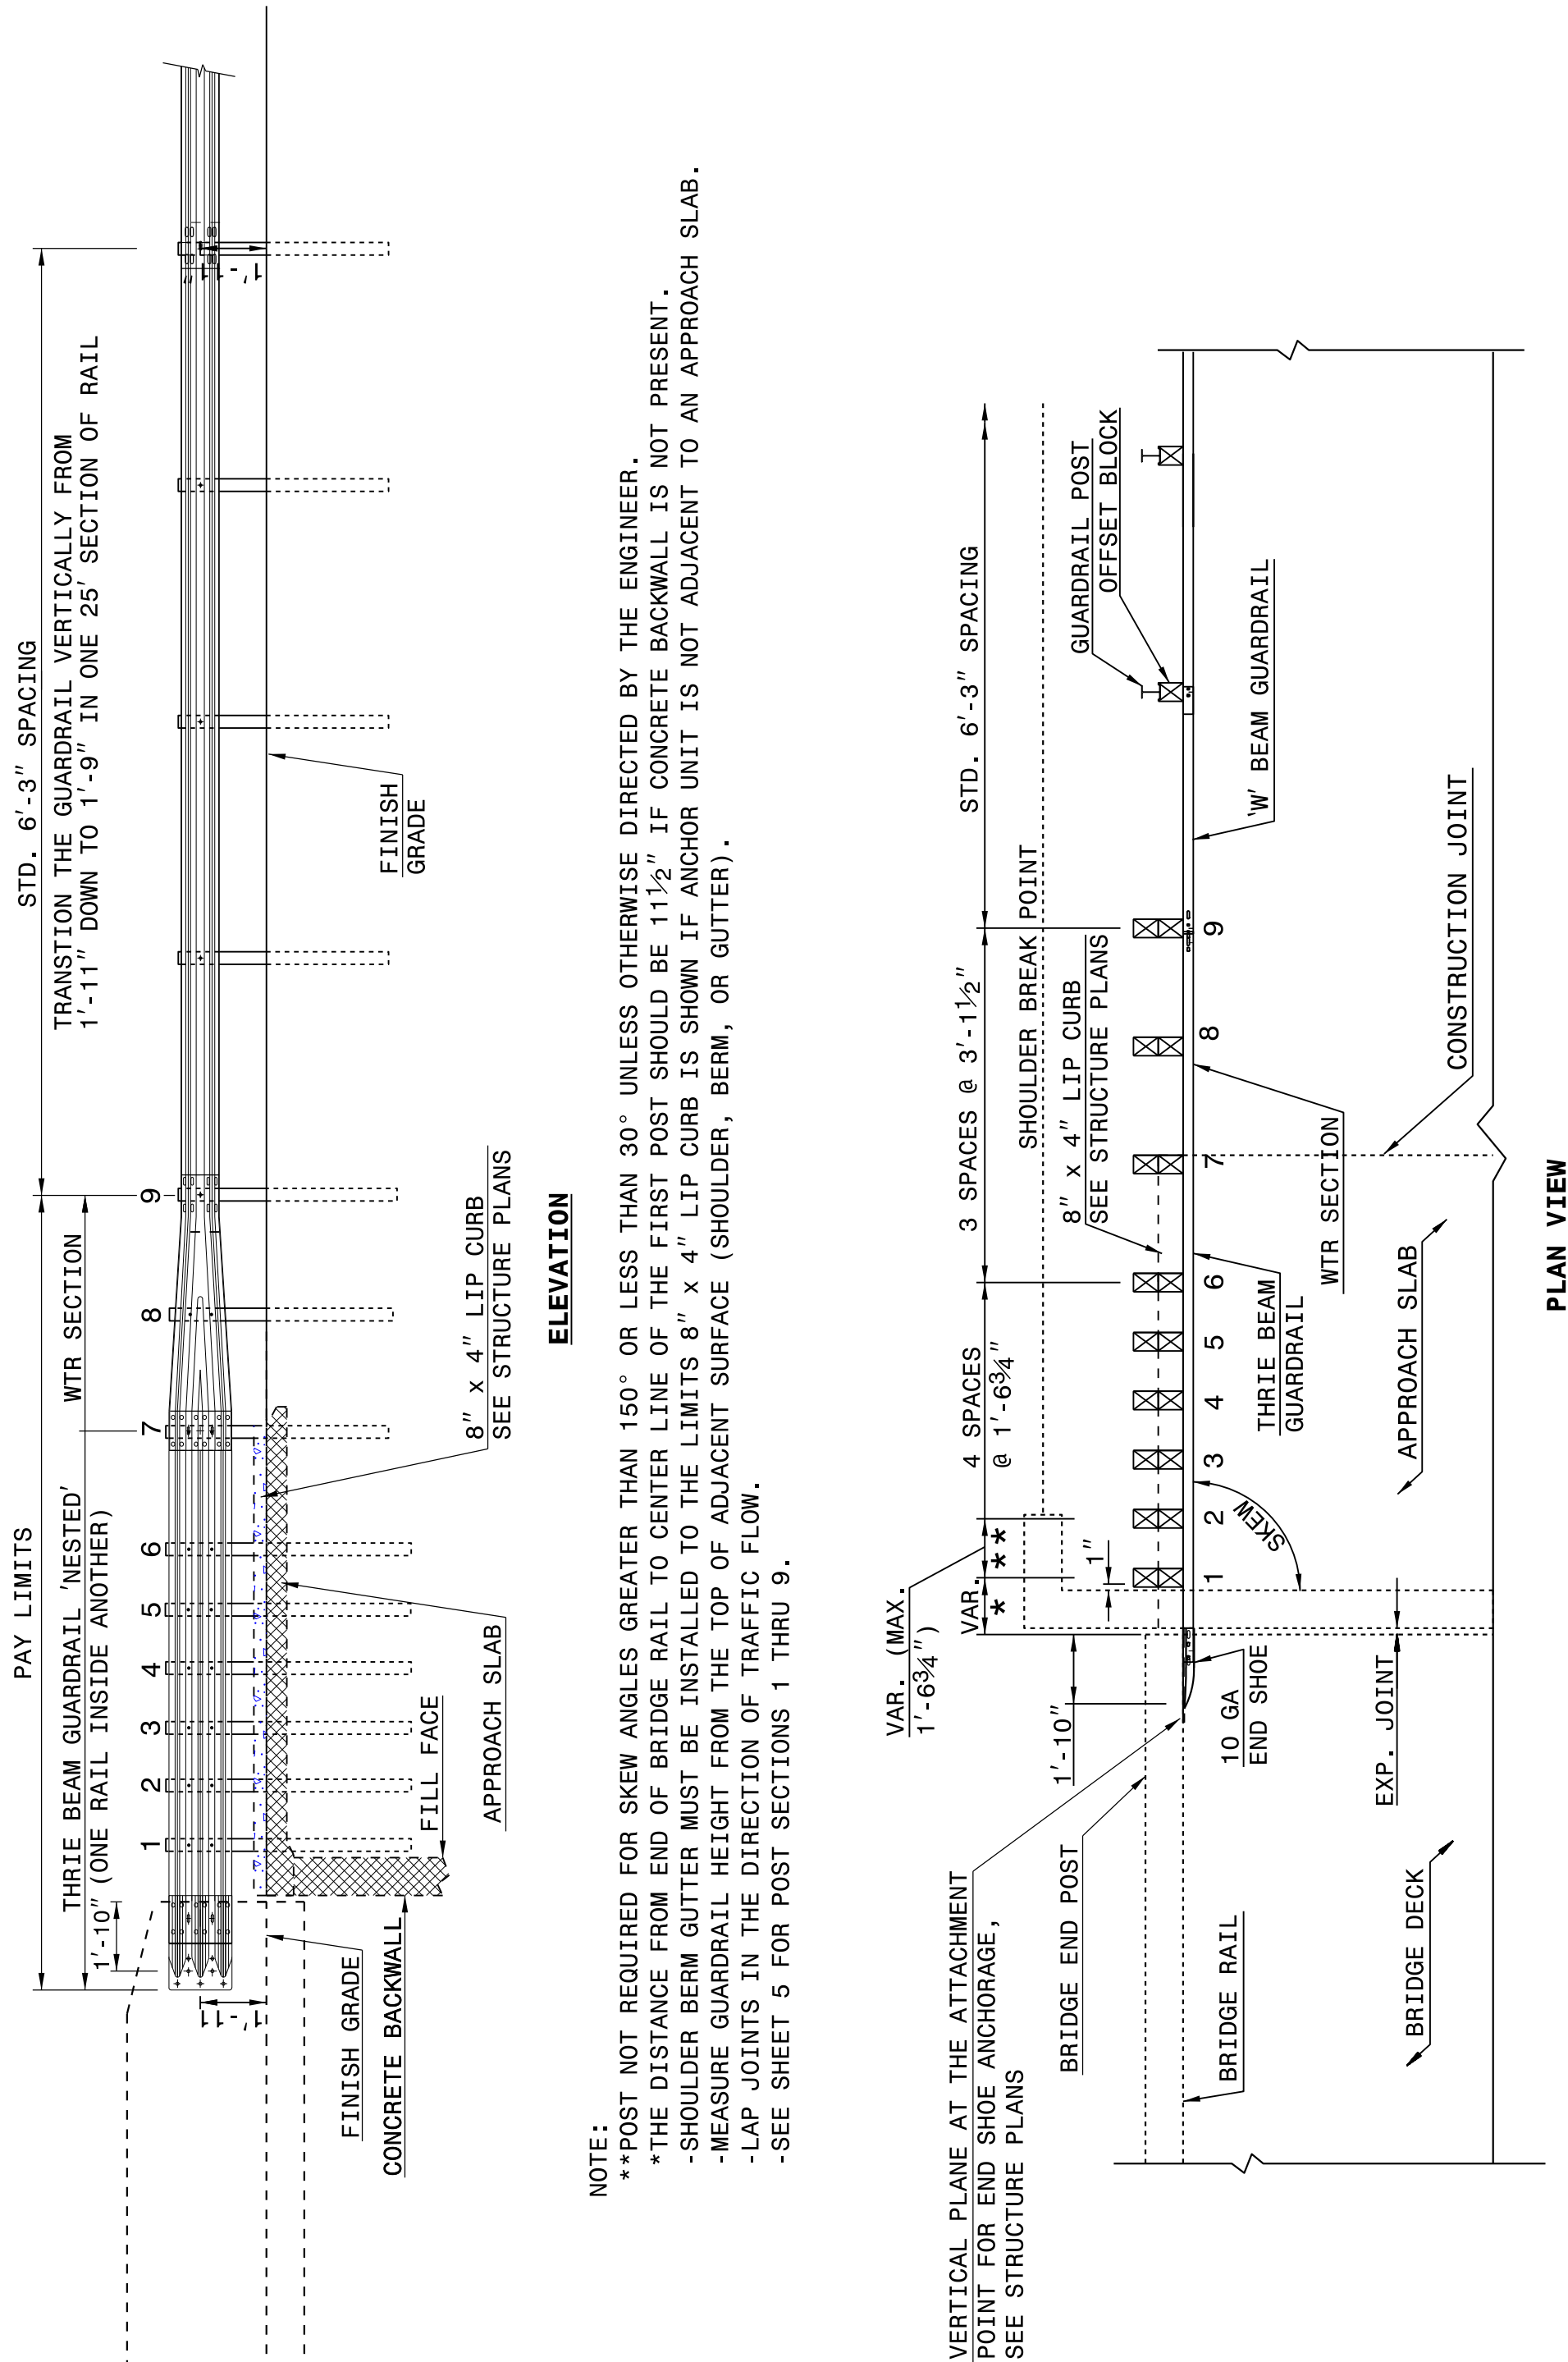

NOTE:
 **POST NOT REQUIRED FOR SKEW ANGLES GREATER THAN 150° OR LESS THAN 30° UNLESS OTHERWISE DIRECTED BY THE ENGINEER.
 *THE DISTANCE FROM END OF BRIDGE RAIL TO CENTER LINE OF THE FIRST POST SHOULD BE 11 1/2" IF CONCRETE BACKWALL IS NOT PRESENT.
 -SHOULDER BERM GUTTER MUST BE INSTALLED TO THE LIMITS 8" x 4" LIP CURB IS SHOWN IF ANCHOR UNIT IS NOT ADJACENT TO AN APPROACH SLAB.
 -MEASURE GUARDRAIL HEIGHT FROM THE TOP OF ADJACENT SURFACE (SHOULDER, BERM, OR GUTTER).
 -LAP JOINTS IN THE DIRECTION OF TRAFFIC FLOW.
 -SEE SHEET 5 FOR POST SECTIONS 1 THRU 9.


ELEVATION


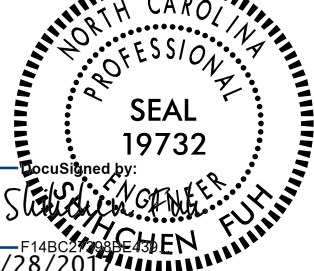

STATE OF
NORTH CAROLINA
DEPT. OF TRANSPORTATION
DIVISION OF HIGHWAYS
RALEIGH, N.C.


ENGLISH DETAIL DRAWING FOR
STRUCTURE ANCHOR UNITS
GUARDRAIL ANCHOR UNIT, TYPE III FOR ATTACHMENT TO
RAIL ON BRIDGE - SUB REGIONAL TIER

SHEET 2 OF 7

```
$SYTIME$$$$$DGN$$$  
$$$$$USERSNAME$$$
```

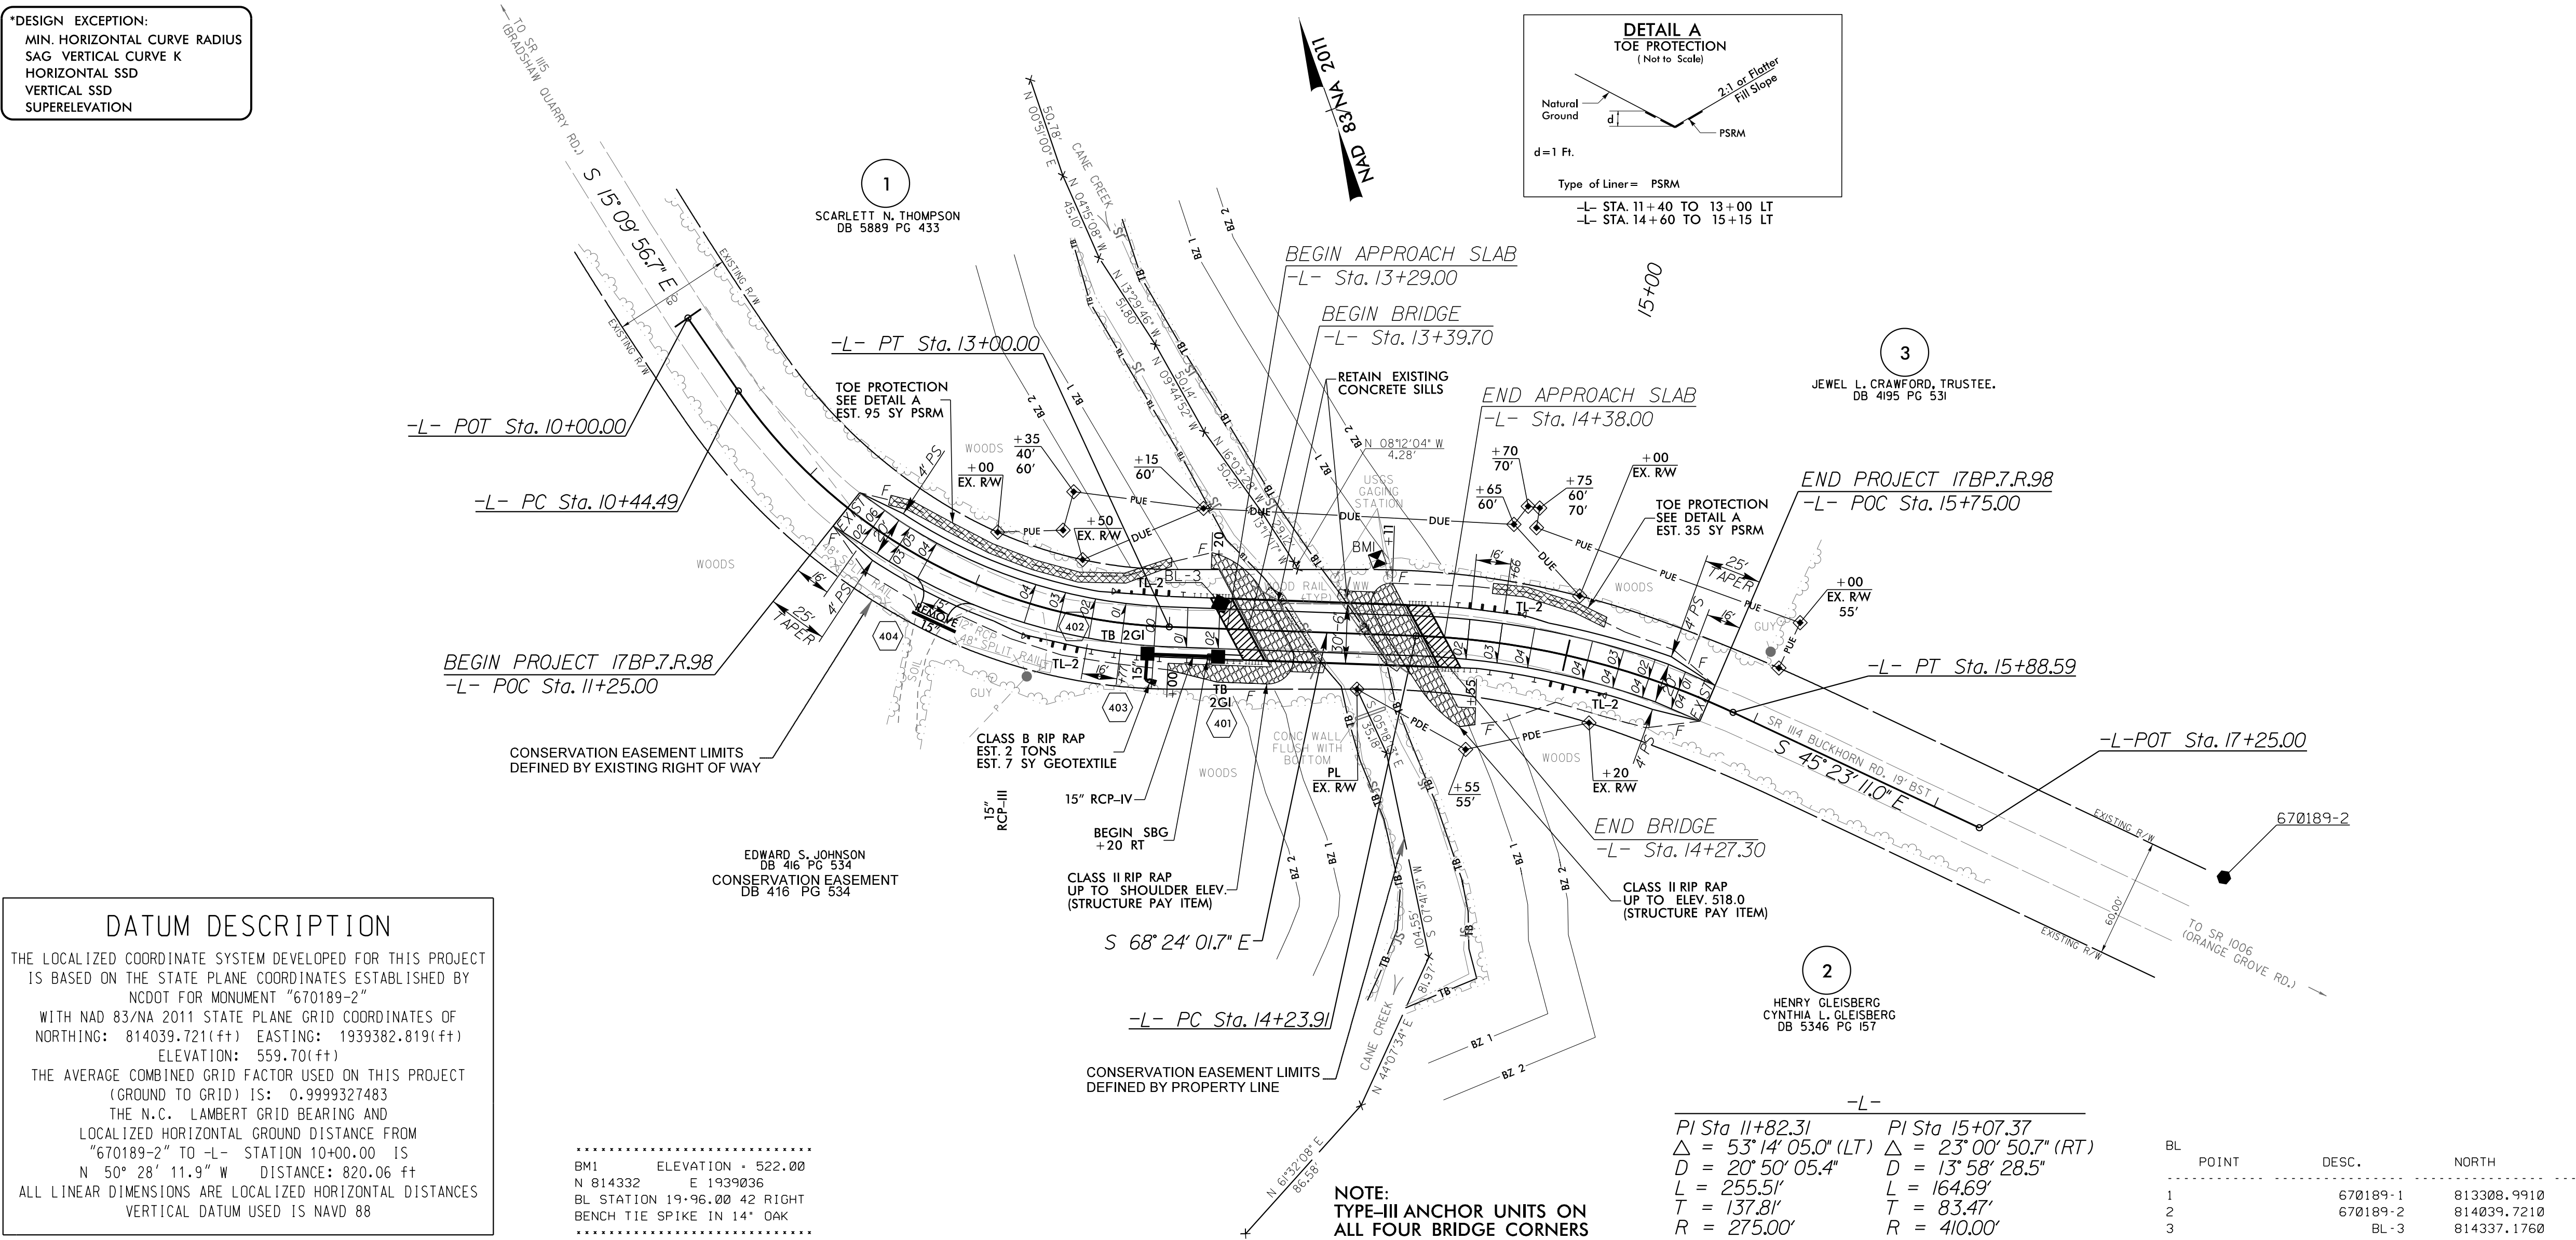PROJECT REFERENCE		SHEET NO.	
17BP.7.R.98 - ORANGE 189		4	
ROADWAY DESIGN ENGINEER		HYDRAULICS ENGINEER	
			
MOTT MACDONALD 18 E LLC LICENSE NO. F-6669			
DOCUMENT NOT CONSIDERED FINAL UNLESS ALL SIGNATURES COMPLETED			
Prepared in the Office of:		M M PO Box 700 MOTT Fuquay-Varina, NC 27526 MACDONALD www.mottmac.com	
		5121 Kingdom Way, Suite 100 Raleigh, NC 27607 NC License No. F-70258	
VERTICAL SCALE 5' 0 5' 10'		HORIZONTAL SCALE 25' 0 25' 50'	

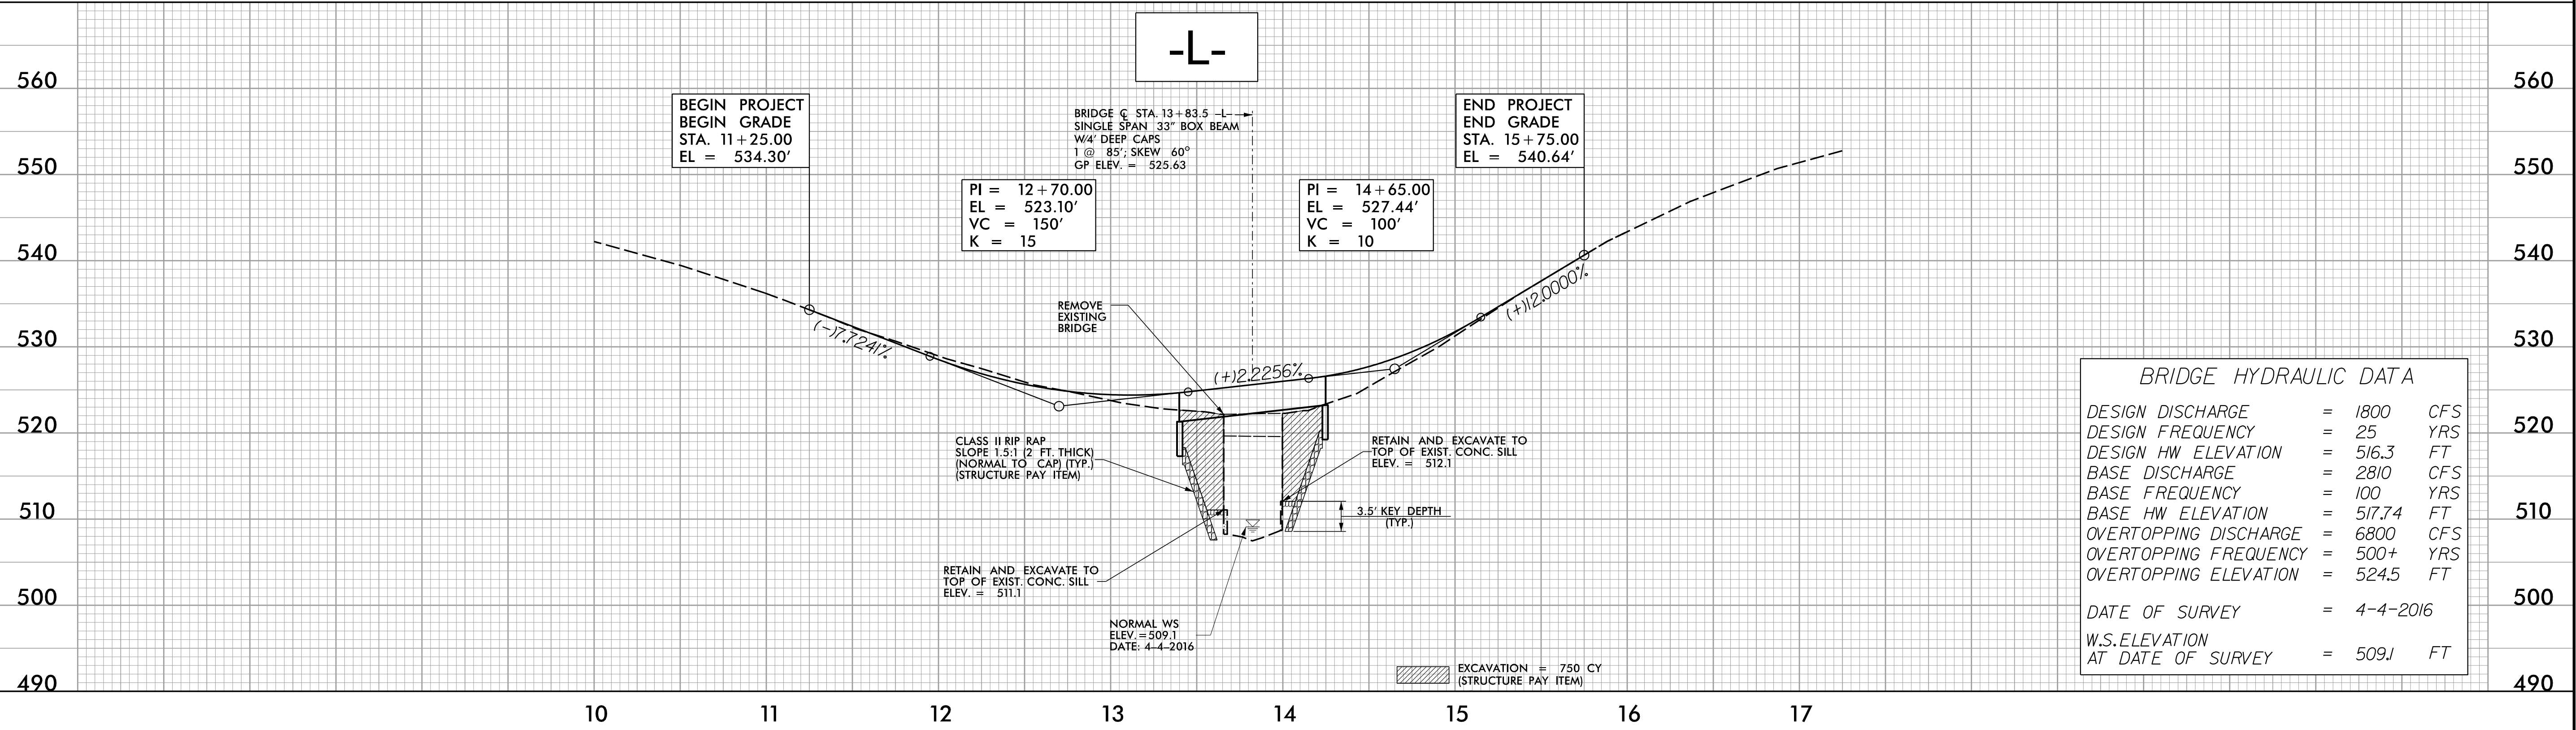

3/28/2017
8:26:16 AM
R:\Roadway\Proj\670189_rdy_psh.dgn
lor66165

THE FOLLOWING ROADWAY STANDARDS AS APPEAR IN “ROADWAY STANDARD DRAWINGS” – HIGHWAY DESIGN BRANCH– N.C. DEPARTMENT OF TRANSPORTATION – RALEIGH, N.C., DATED JANUARY 2012 ARE APPLICABLE TO THIS PROJECT AND BY REFERENCE HEREBY ARE CONSIDERED A PART OF THESE PLANS:

STD.	TITLE
1101.03	TEMPORARY ROAD CLOSURES
1110.01	STATIONARY WORK ZONE SIGNS
1145.01	BARRICADES
1205.01	PAVEMENT MARKINGS – LINE TYPES AND OFFSETS
1205.02	PAVEMENT MARKINGS – TWO-LANE AND MULTI-LANE ROADWAYS
1205.12	PAVEMENT MARKINGS – BRIDGES
1261.01	GUARDRAIL AND BARRIER DELINEATORS – INSTALLATION SPACING
1261.02	GUARDRAIL AND BARRIER DELINEATORS – TYPES AND MOUNTING
1262.01	GUARDRAIL END DELINEATION

GENERAL NOTES

CHANGES MAY BE REQUIRED WHEN PHYSICAL DIMENSIONS IN THE DETAIL DRAWINGS, STANDARD DETAILS, AND ROADWAY DETAILS ARE NOT ATTAINABLE TO MEET FIELD CONDITIONS OR RESULT IN DUPLICATE OR UNDESIRED OVERLAPPING OF DEVICES. MODIFICATION MAY INCLUDE: MOVING, SUPPLEMENTING, COVERING, OR REMOVAL OF DEVICES AS DIRECTED BY THE ENGINEER.

THE FOLLOWING GENERAL NOTES APPLY AT ALL TIMES FOR THE DURATION OF THE CONSTRUCTION PROJECT EXCEPT WHEN OTHERWISE NOTED IN THE PLAN OR DIRECTED BY THE ENGINEER.

TRAFFIC PATTERN ALTERATIONS

A) NOTIFY THE ENGINEER TWENTY ONE (21) CALENDAR DAYS PRIOR TO ANY TRAFFIC PATTERN ALTERATION.

SIGNING

B) PROVIDE PERMANENT SIGNING.

C) PROVIDE SIGNING AND DEVICES REQUIRED TO CLOSE THE ROAD ACCORDING TO THE ROADWAY STANDARD DRAWINGS AND TRAFFIC CONTROL PLANS.

PROVIDE SIGNING REQUIRED FOR THE OFF-SITE DETOUR ROUTE AS SHOWN IN THE TRAFFIC CONTROL PLANS.

D) COVER OR REMOVE ALL SIGNS AND DEVICES REQUIRED TO CLOSE THE ROAD WHEN ROAD CLOSURE IS NOT IN OPERATION.

COVER OR REMOVE ALL SIGNS REQUIRED FOR THE OFF-SITE DETOUR WHEN THE DETOUR IS NOT IN OPERATION.


E) ENSURE ALL NECESSARY SIGNING IS IN PLACE PRIOR TO ALTERING ANY TRAFFIC PATTERN.

TRAFFIC CONTROL DEVICES

F) PLACE TYPE III BARRICADES, WITH “ROAD CLOSED” SIGN R11-2 ATTACHED, OF SUFFICIENT LENGTH TO CLOSE ENTIRE ROADWAY.

PAVEMENT MARKINGS AND MARKERS

G) INSTALL PAVEMENT MARKINGS ON THE FINAL SURFACE.

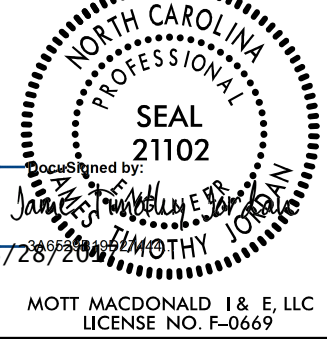PROJECT REFERENCE		SHEET NO.
17BP.7.R.98 – ORANGE 189		TMP-1
<div>ROADWAY DESIGN ENGINEER</div> <div></div> <div>MOTT MACDONALD 1 & E, LLC LICENSE NO. E-0669</div>		
DOCUMENT NOT CONSIDERED FINAL UNLESS ALL SIGNATURES COMPLETED		
Prepared in the Office of:		<div>M</div> <div>MOTT MACDONALD</div> <div>PO Box 700 Fuquay-Varina, NC 27526 www.mottmac.com</div>




PHASING


- STEP 1: USING ROADWAY STANDARD DRAWING NUMBER 1101.03, SHEET 1 OF 9, AND SHEET TMP-2, PERFORM THE FOLLOWING:
– INSTALL ALL ROAD CLOSURE AND DETOUR SIGNING INCLUDING BARRICADES
– CLOSE SR 1114 (BUCKHORN ROAD)
– PLACE TRAFFIC ONTO OFF- SITE DETOUR
- STEP 2: REMOVE EXISTING BRIDGE #189 AND CONSTRUCT THE PROPOSED BRIDGE AND APPROACHES AS SHOWN IN THE CONSTRUCTION PLANS.
- STEP 3: INSTALL FINAL PAVEMENT MARKINGS.
- STEP 4: REMOVE ALL TRAFFIC CONTROL SIGNING AND DEVICES AND RE-OPEN SR 1114 (BUCKHORN ROAD) TO THE FINAL TRAFFIC PATTERN.

PAVEMENT MARKING

PAINT WHITE EDGELINE (4”) 1,800 LF
PAINT YELLOW DOUBLE CENTER (4”) 1,800 LF

NOTE: QUANTITY INCLUDES 2 APPLICATIONS OF EACH

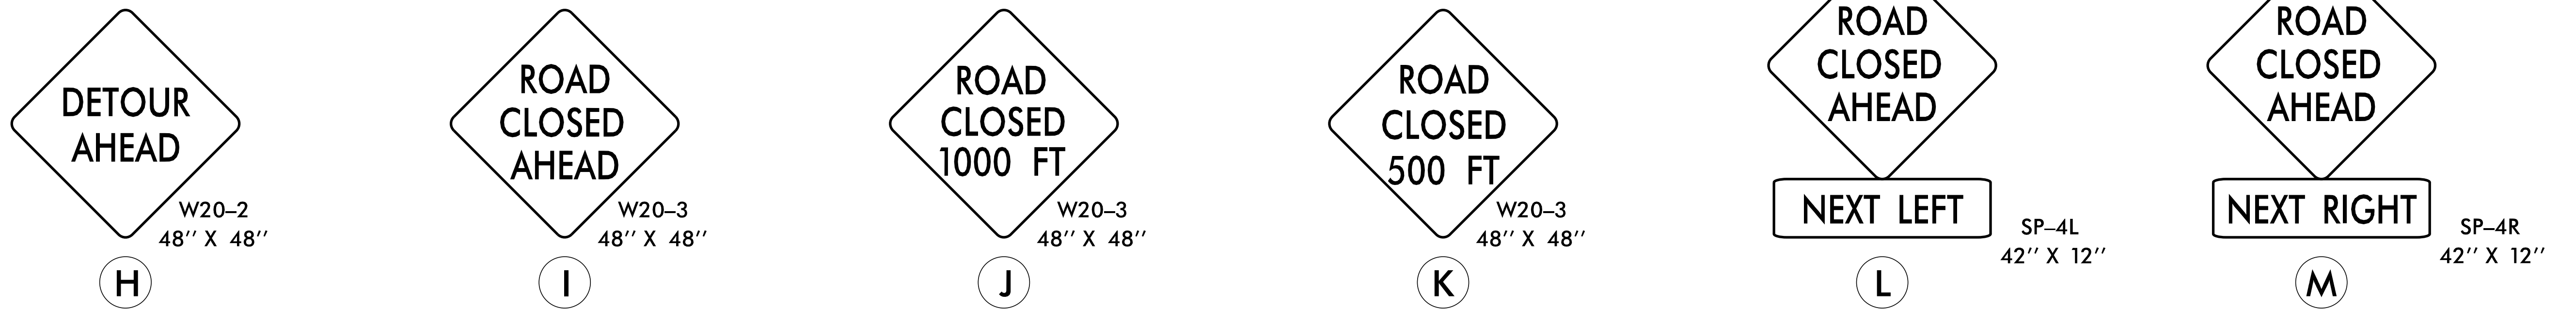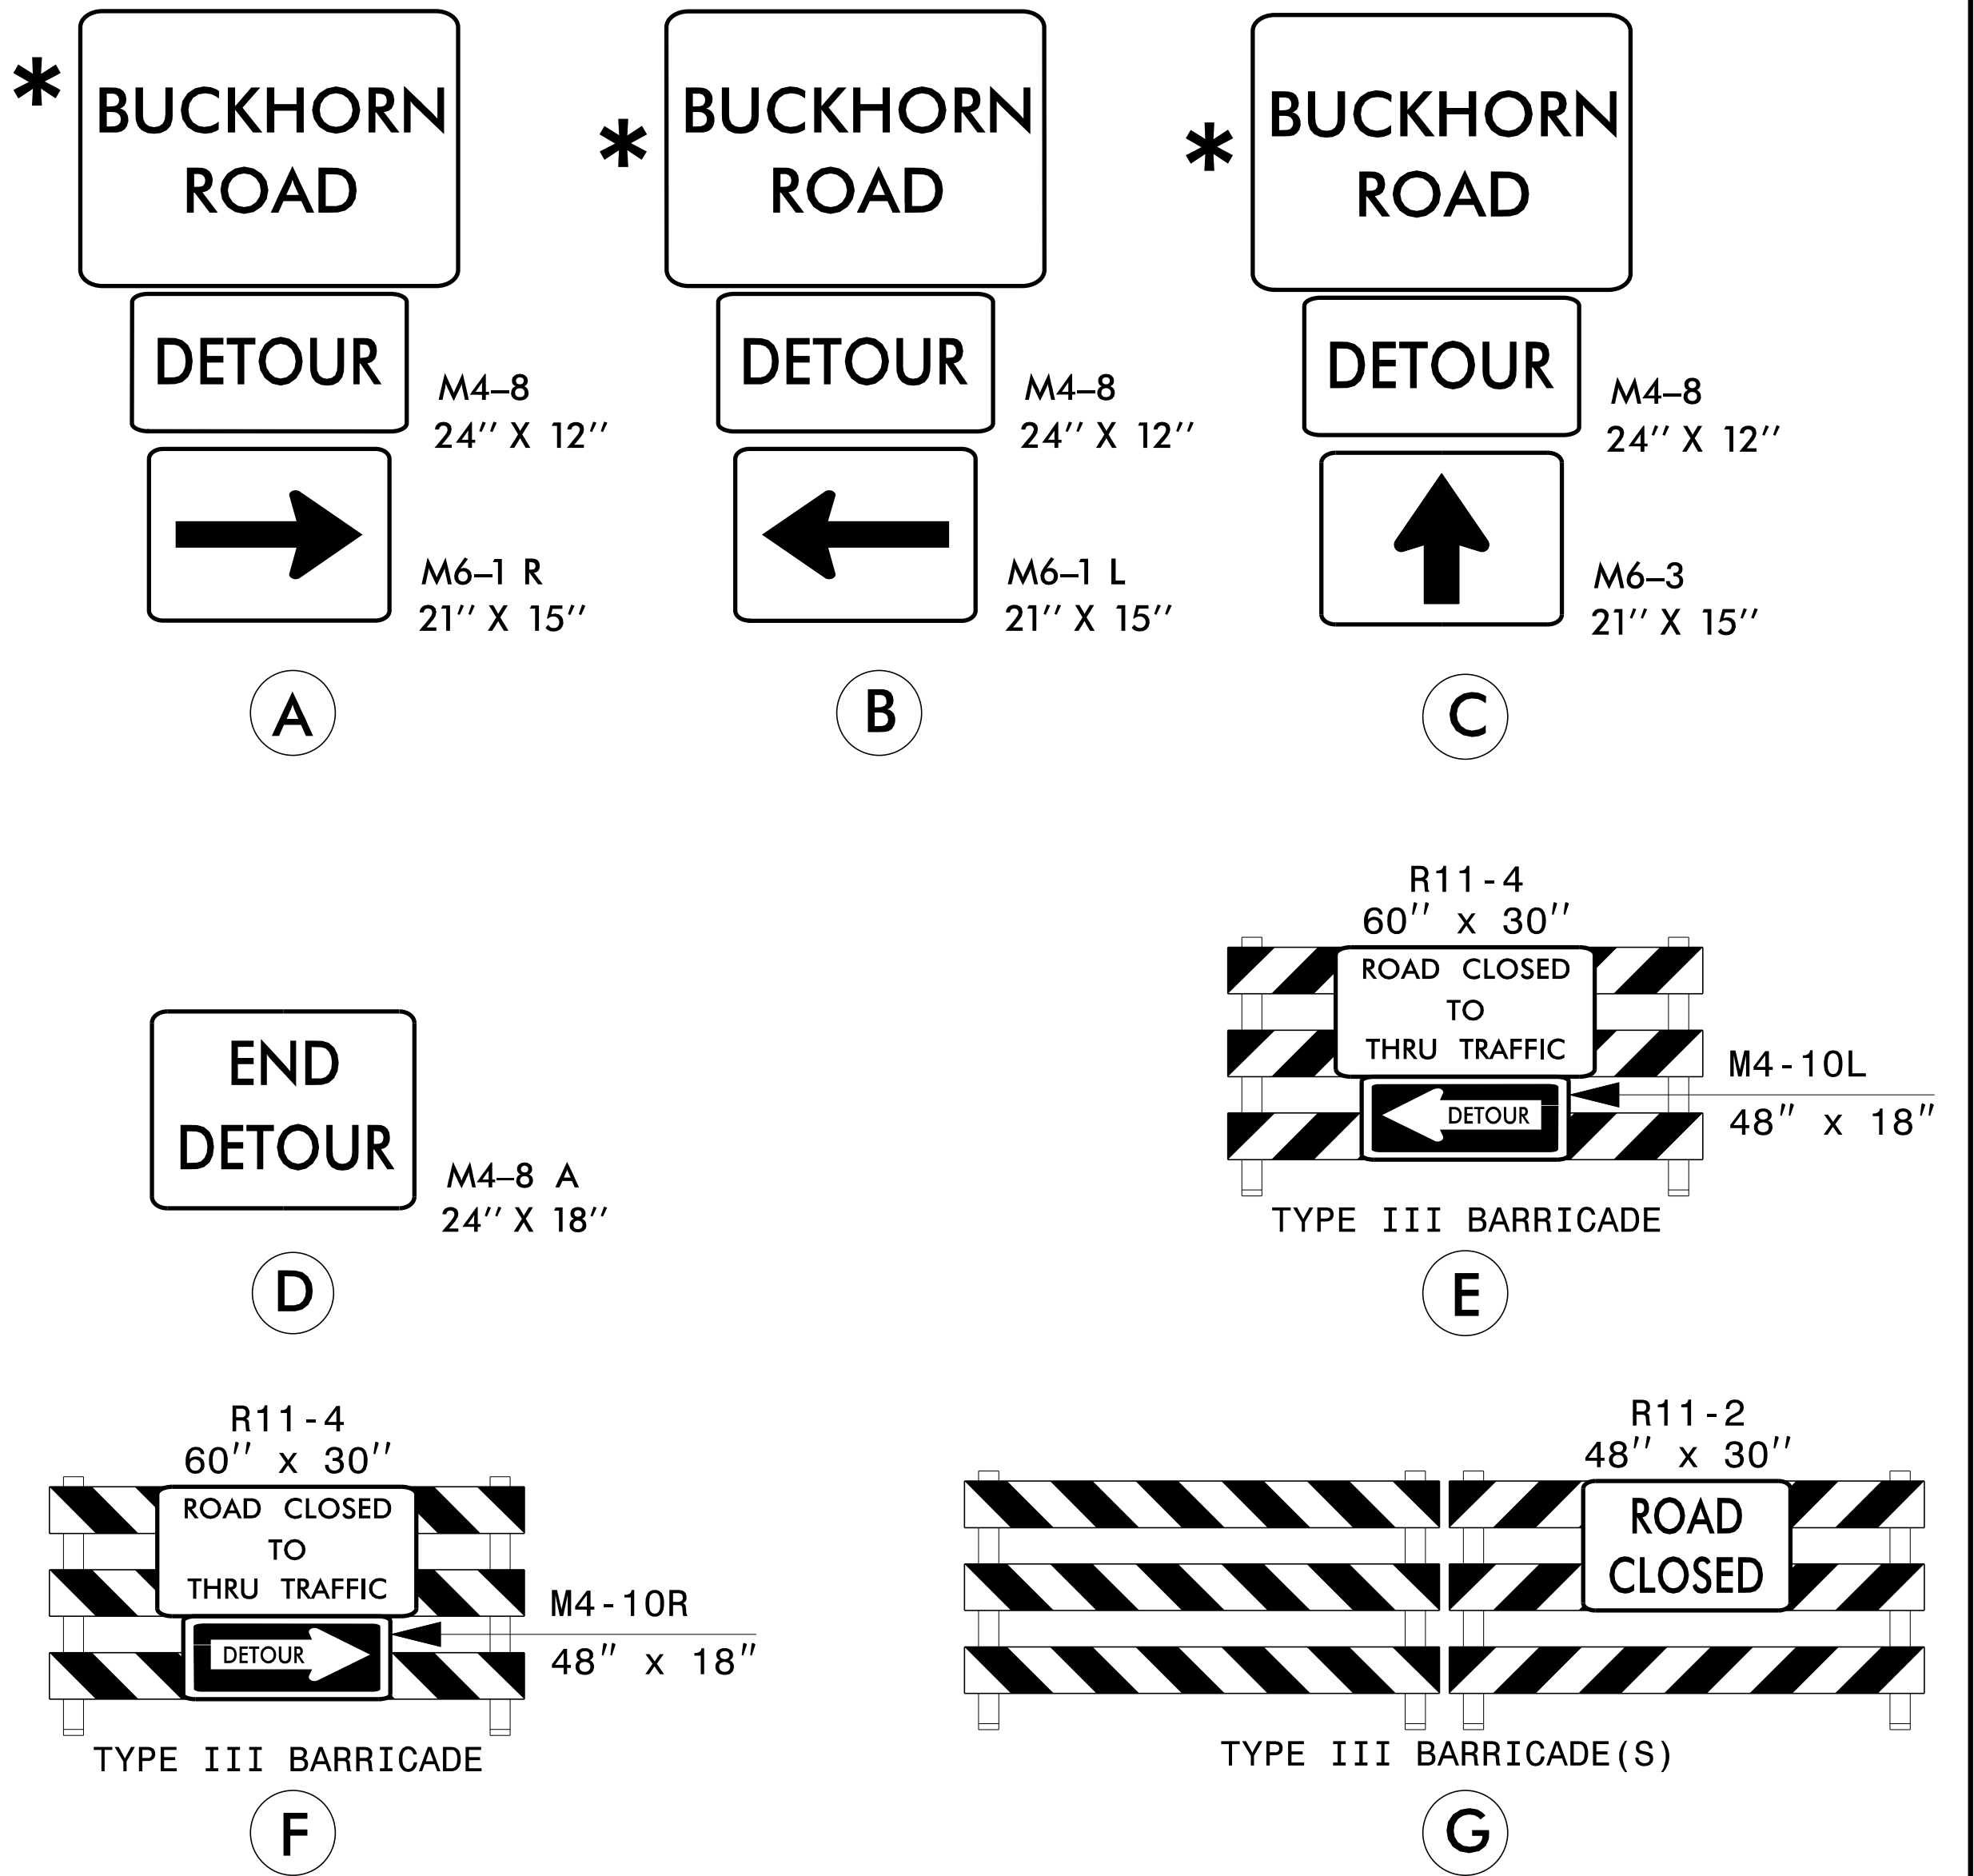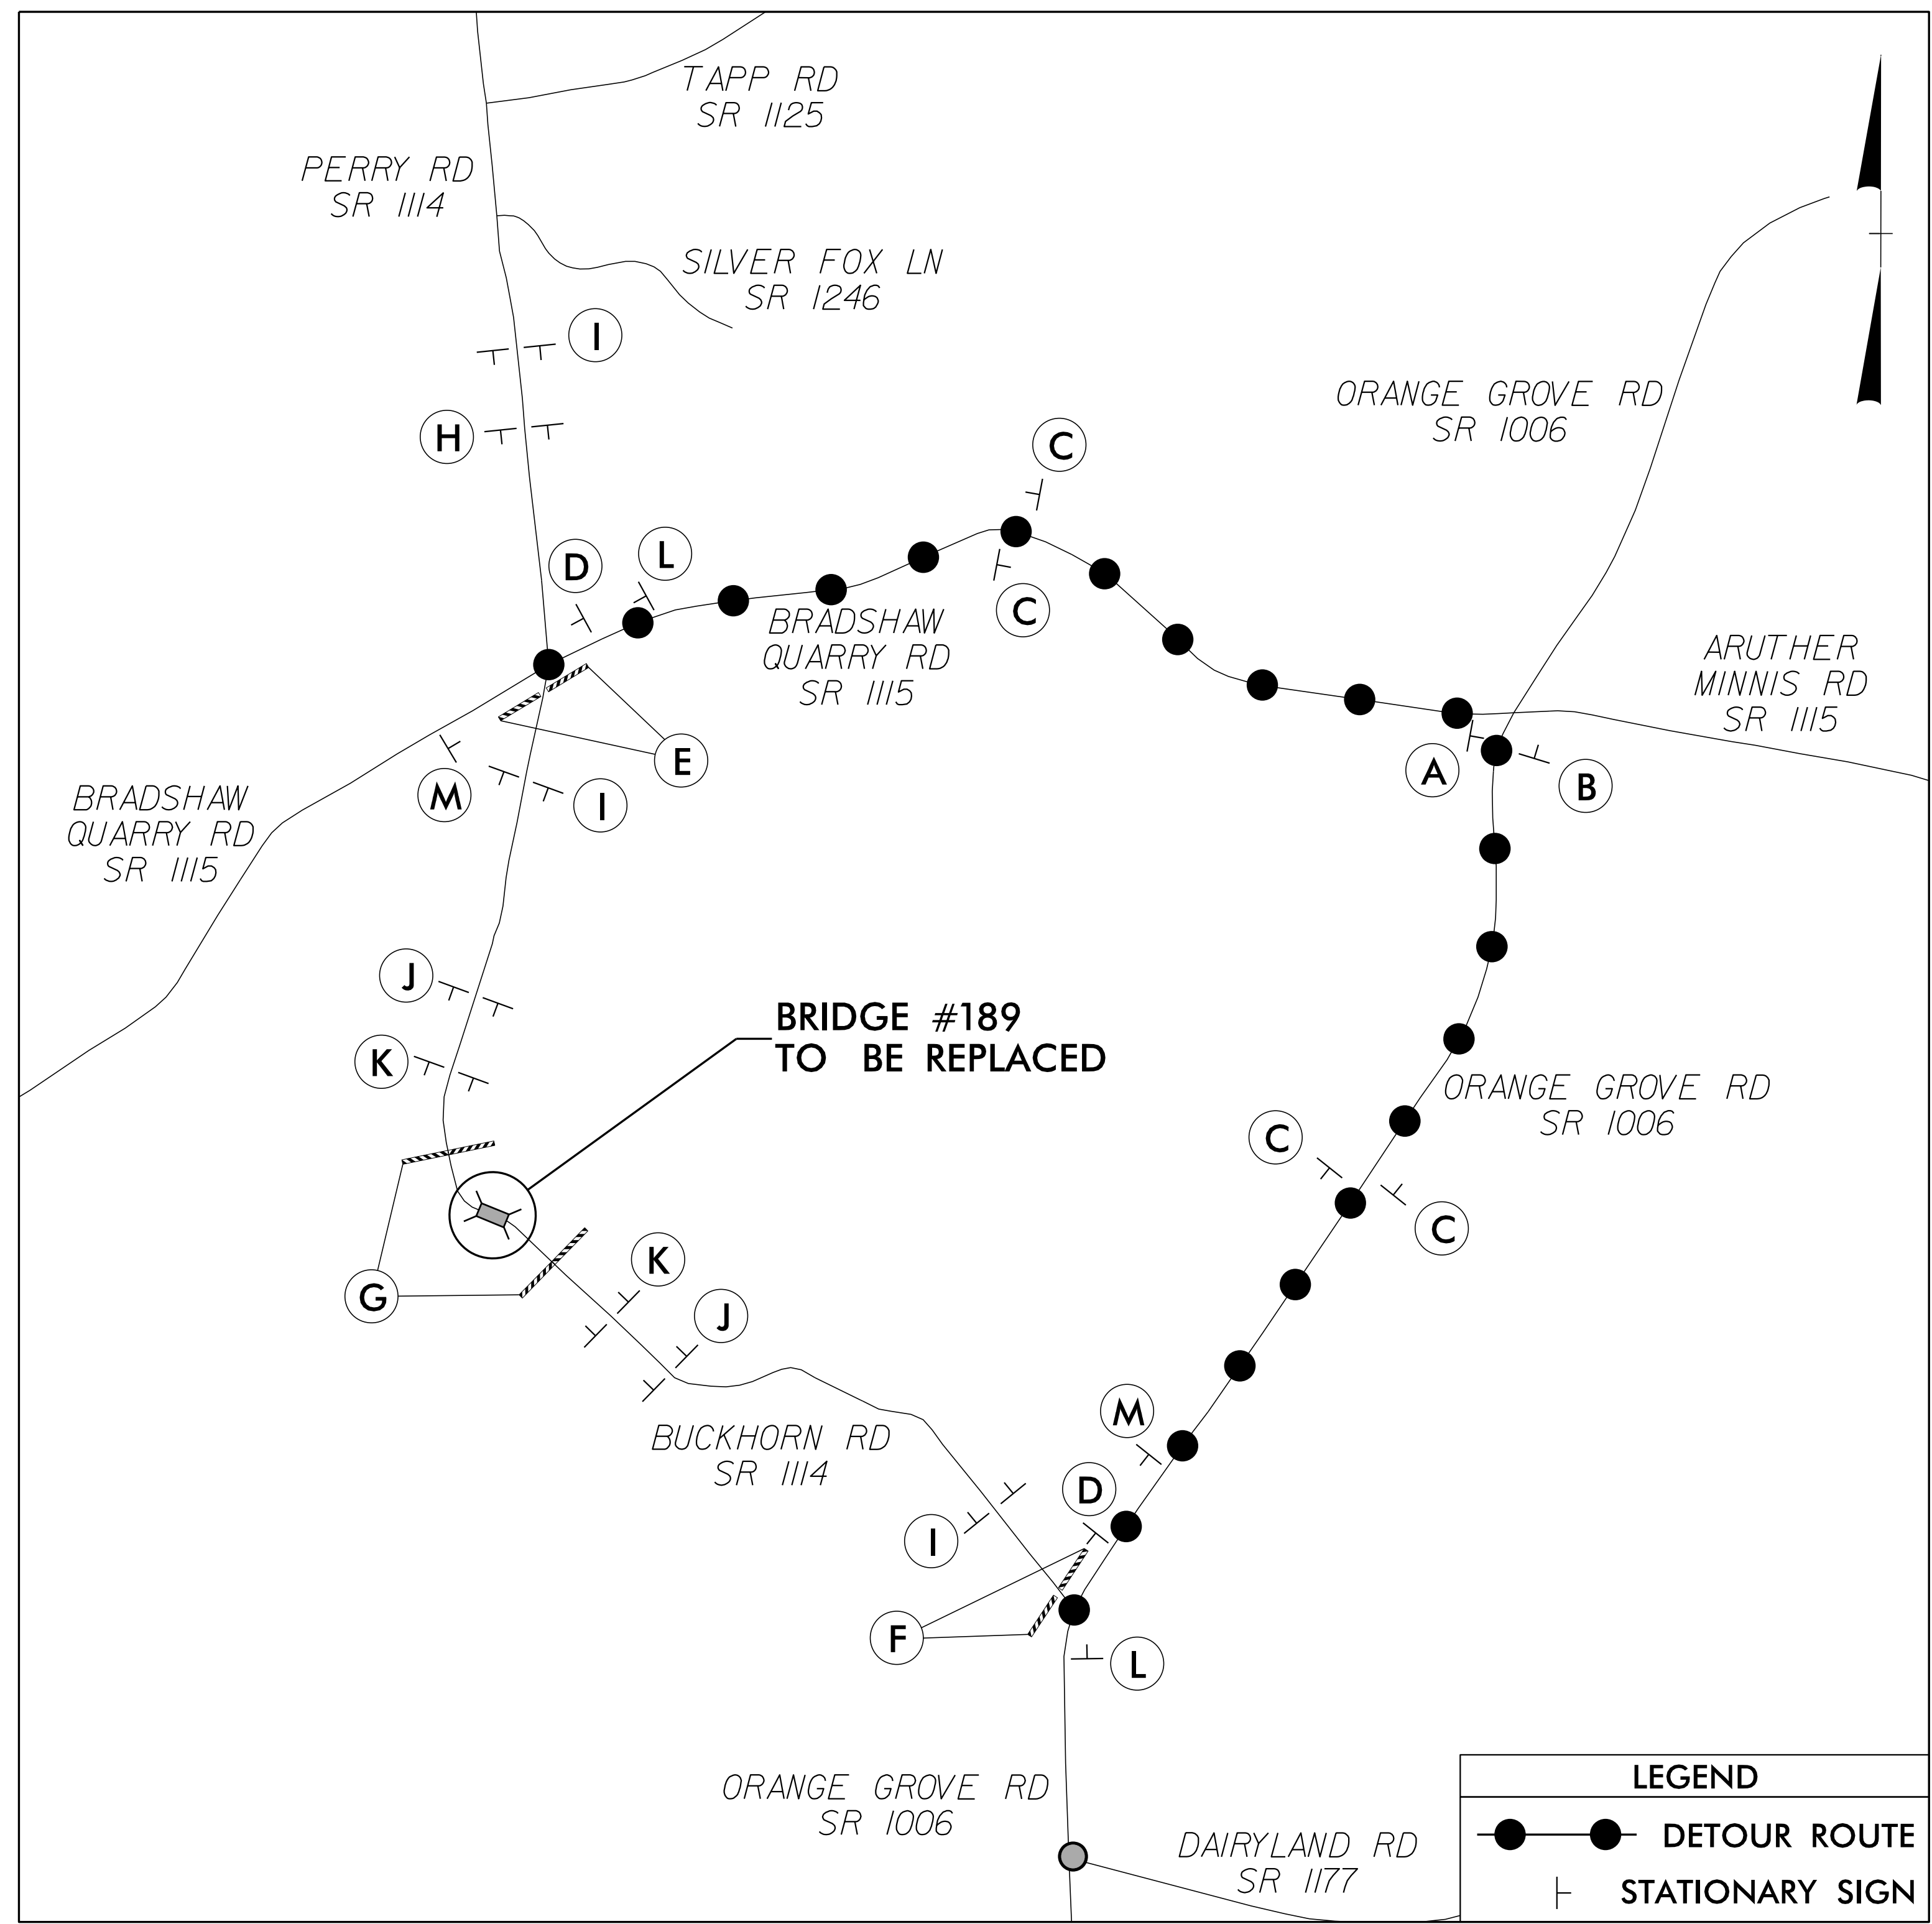

PROJECT REFERENCE	SHEET NO.
17BP.7.9.8 – ORANGE 189	TMP-3
<p>TRAFFIC ENGINEER</p>  <p>3/29/2010</p> <p>MOTT MACDONALD & E, LLC LICENSE NO. F-03669</p>	
<p>DOCUMENT NOT CONSIDERED FINAL UNLESS ALL SIGNATURES COMPLETED</p>	
<p>Prepared in the Office of:</p> <div style="display: flex; align-items: center;"> <div style="margin-right: 20px;"> <p>M</p> <p>MOTT MACDONALD</p> </div> <div> <p>PO. Box 700 Fuquay-Varina, NC 27526 www.mottmac.com</p> </div> </div>	


[illegible]

3/27/2017
draulica\EA\Projects\17BP.7.R.98\hyd_erosion_tsh.dgn

TIP PROJECT: 17BP.7.R.98

STATE OF NORTH CAROLINA
DIVISION OF HIGHWAYS
PLAN FOR PROPOSED
HIGHWAY EROSION CONTROL
ORANGE COUNTY


LOCATION: BRIDGE NO. 189 OVER CANE CREEK ON SR 114 (BUCKHORN ROAD)
TYPE OF WORK: GRADING, PAVING, DRAINAGE AND STRUCTURE

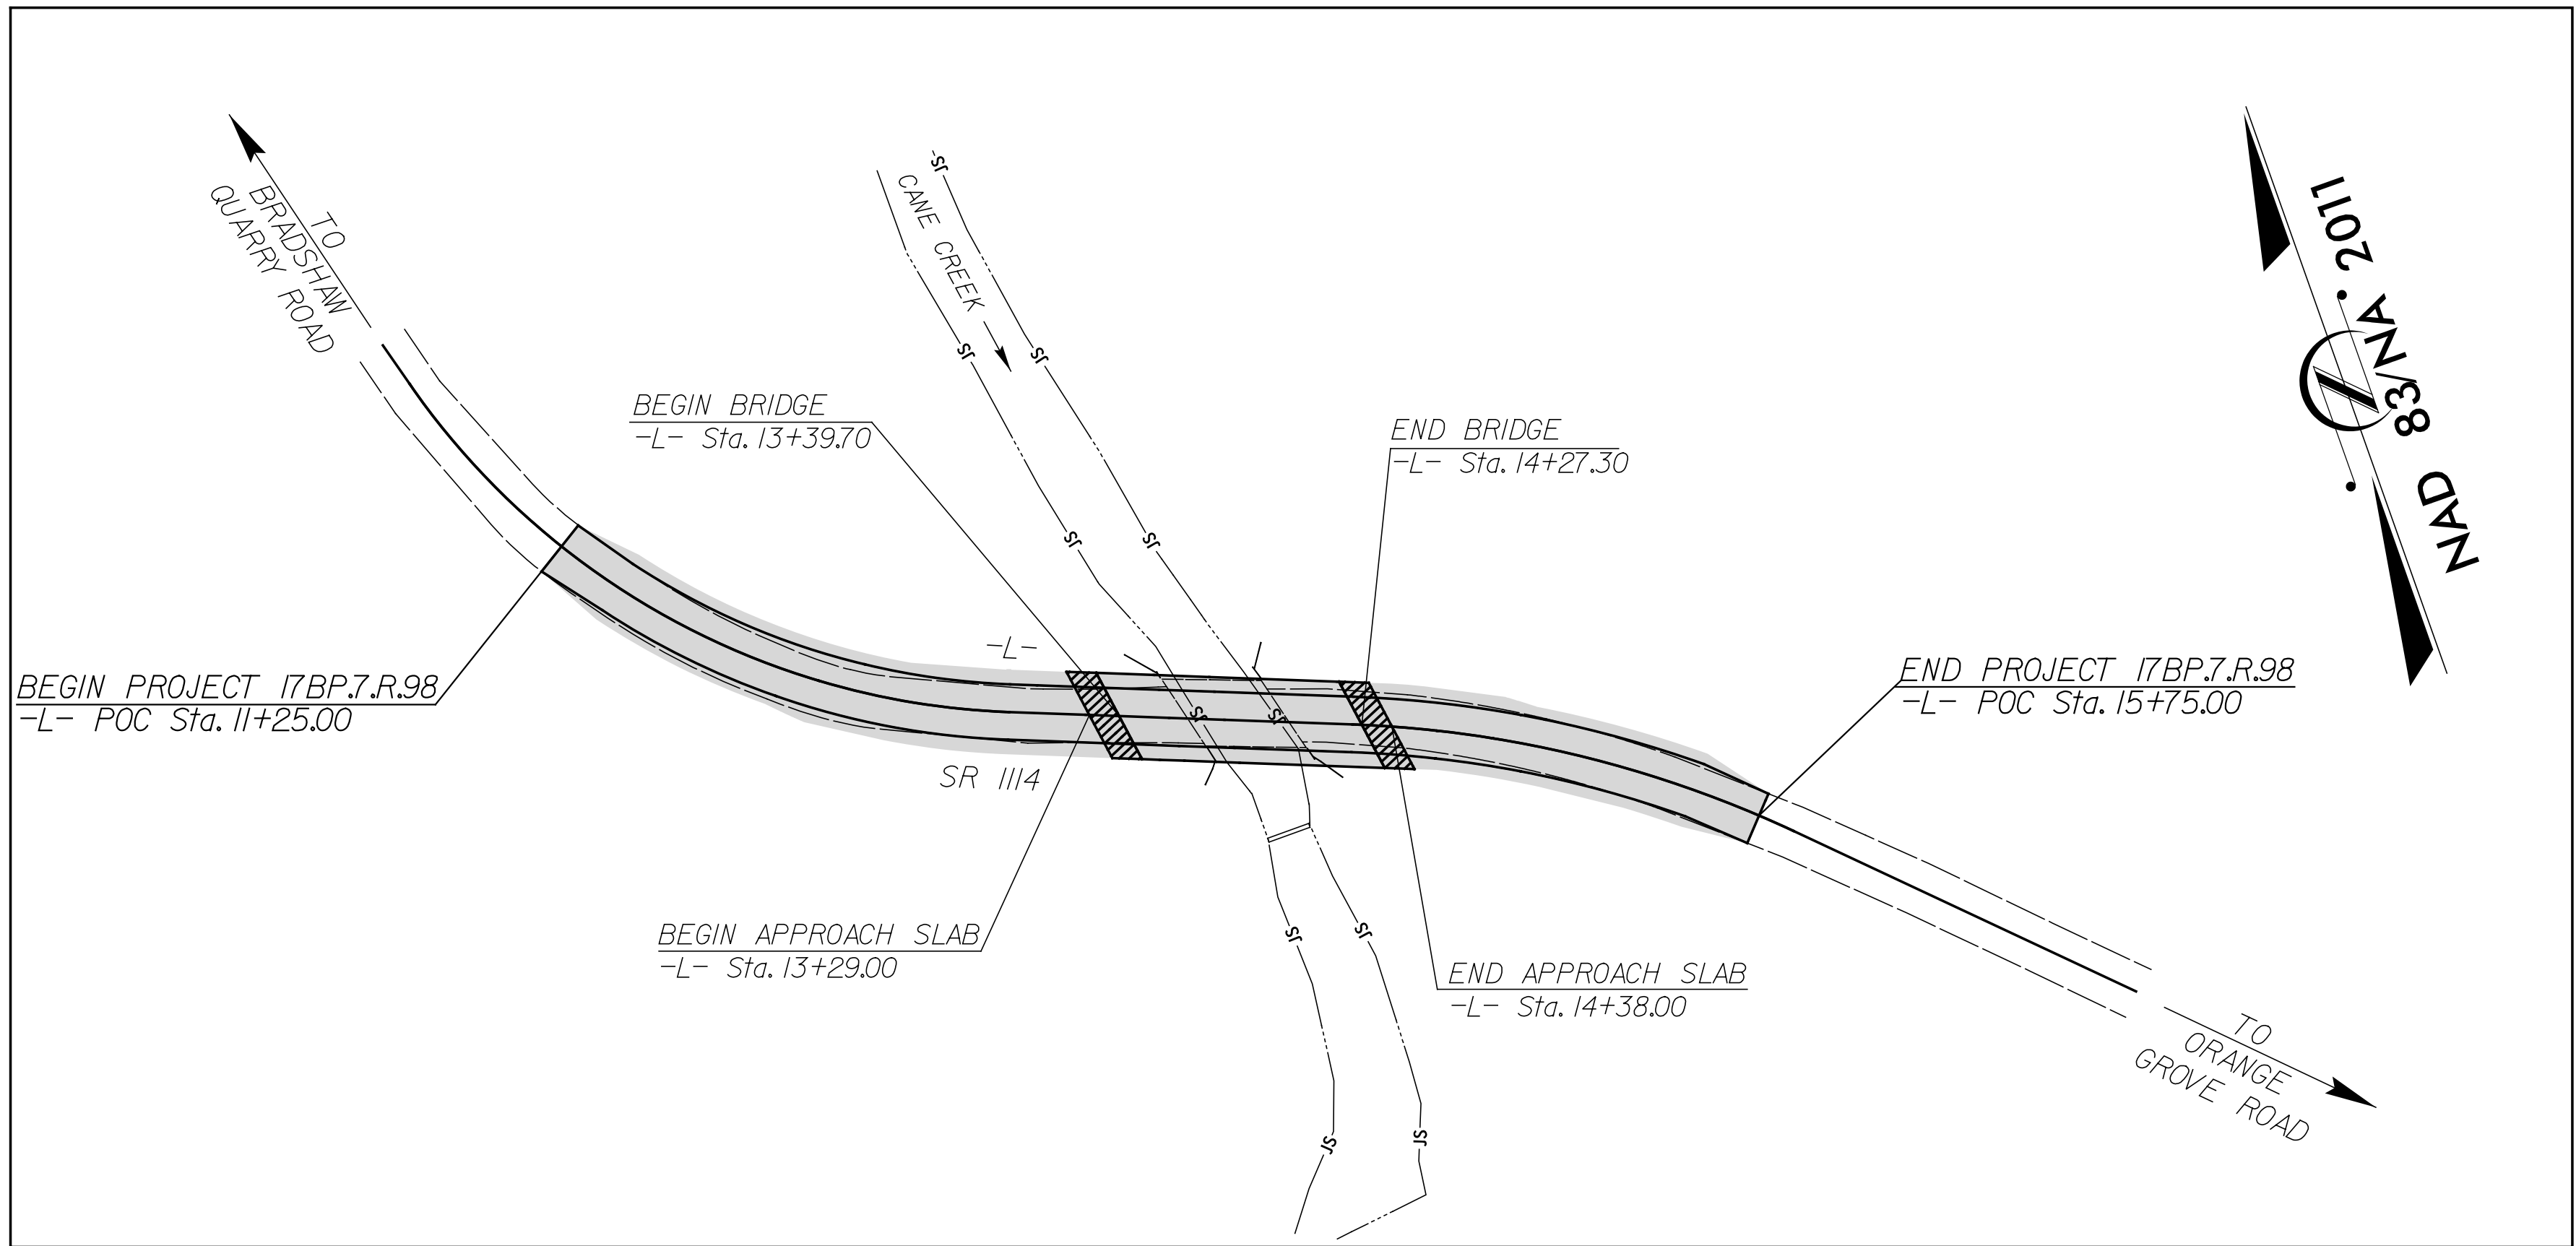


ENVIRONMENTALLY
SENSITIVE AREA(S) EXIST
ON THIS PROJECT

Refer To E. C. Special Provisions
for Special Considerations.

GRAPHIC SCALE

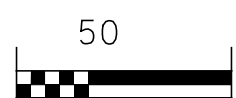

PLANS

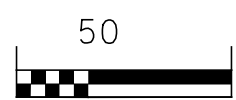

PROFILE (HORIZONTAL)



PROFILE (VERTICAL)

THESE EROSION AND SEDIMENT
CONTROL PLANS COMPLY WITH
THE REGULATIONS SET FORTH
BY THE NCG-010000 GENERAL
CONSTRUCTION PERMIT EFFECTIVE
AUGUST 1, 2016 AND ISSUED BY
THE NORTH CAROLINA DEPARTMENT
OF ENVIRONMENT AND NATURAL
RESOURCES DIVISION OF WATER
RESOURCES.

Prepared In the Office of:

ICA ENGINEERING

5121 KINGDOM WAY, SUITE 100
RALEIGH NC 27607
NC License No. F-0258

Designed by:

STACEY H. BAILEY, PE

NAME

3074

LEVEL III CERTIFICATION NO.

Reviewed In the Office of:

ROADSIDE ENVIRONMENTAL UNIT

1 South Wilmington St.
Raleigh, NC 27611

2012 STANDARD SPECIFICATIONS

Reviewed by:

WES CHANDLER, EI

Roadway Standard Drawings

The following roadway english standards as appear in "Roadway Standard Drawings"- Roadway Design Unit - N. C. Department of Transportation - Raleigh, N. C., dated January 2012 and the latest revision thereto are applicable to this project and by reference hereby are considered a part of these plans.

1604.01	Railroad Erosion Control Detail	1632.01	Rock Inlet Sediment Trap Type A
1605.01	Temporary Silt Fence	1632.02	Rock Inlet Sediment Trap Type B
1606.01	Special Sediment Control Fence	1632.03	Rock Inlet Sediment Trap Type C
1607.01	Gravel Construction Entrance	1633.01	Temporary Rock Silt Check Type A
1622.01	Temporary Berms and Slope Drains	1633.02	Temporary Rock Silt Check Type B
1630.01	Riser Basin	1634.01	Temporary Rock Sediment Dam Type A
1630.02	Silt Basin Type B	1634.02	Temporary Rock Sediment Dam Type B
1630.03	Temporary Silt Ditch	1635.01	Rock Pipe Inlet Sediment Trap Type A
1630.04	Stilling Basin	1635.02	Rock Pipe Inlet Sediment Trap Type B
1630.05	Temporary Diversion	1640.01	Coir Fiber Baffle
1630.06	Special Stilling Basin	1645.01	Temporary Stream Crossing
1631.01	Matting Installation		

STATE	STATE PROJECT REFERENCE NO.	SHEET NO.	TOTAL SHEETS
N.C.	17BP.7.R.98	EC-1	
STATE PROJ. NO.	F.A. PROJ. NO.	DESCRIPTION	

EROSION AND SEDIMENT CONTROL MEASURES

Std. #	Description	Symbol
1630.03	Temporary Silt Ditch	TD
1630.05	Temporary Diversion	TD
1605.01	Temporary Silt Fence	III III III
1606.01	Special Sediment Control Fence	III III III
1622.01	Temporary Berms and Slope Drains	III III III
1630.02	Silt Basin Type B	III III III
1633.01	Temporary Rock Silt Check Type-A	III III III
	Temporary Rock Silt Check Type-A with Matting and Polyacrylamide (PAM)	III III III
1633.02	Temporary Rock Silt Check Type-B	III III III
	Wattle/ Coir Fiber Wattle	III III III
	Wattle/ Coir Fiber Wattle with Polyacrylamide (PAM)	III III III
1634.01	Temporary Rock Sediment Dam Type-A	III III III
1634.02	Temporary Rock Sediment Dam Type-B	III III III
1635.01	Rock Pipe Inlet Sediment Trap Type-A	III III III
1635.02	Rock Pipe Inlet Sediment Trap Type-B	III III III
1630.04	Stilling Basin	III III III
1630.06	Special Stilling Basin	III III III
	Rock Inlet Sediment Trap:	III III III
1632.01	Type A	A
1632.02	Type B	B
1632.03	Type C	C
	Skimmer Basin	III III III
	Tiered Skimmer Basin	III III III
	Infiltration Basin	III III III


THIS PROJECT CONTAINS
EROSION CONTROL PLANS
FOR CLEARING AND
GRUBBING PHASE OF
CONSTRUCTION.

THIS PROJECT HAS
BEEN DESIGNED TO
SENSITIVE WATERSHED
STANDARDS.


HIGH QUALITY WATER(S) EXIST
ON THIS PROJECT

High Quality Water Zone(s) Exist
From Sta. 11+25
to Sta. 15+75
Refer To E. C. Special Provisions
for Special Considerations.

TEMPORARY ROCK SILT CHECK TYPE 'A' WITH EXCELSIOR MATTING AND POLYACRYLAMIDE (PAM)

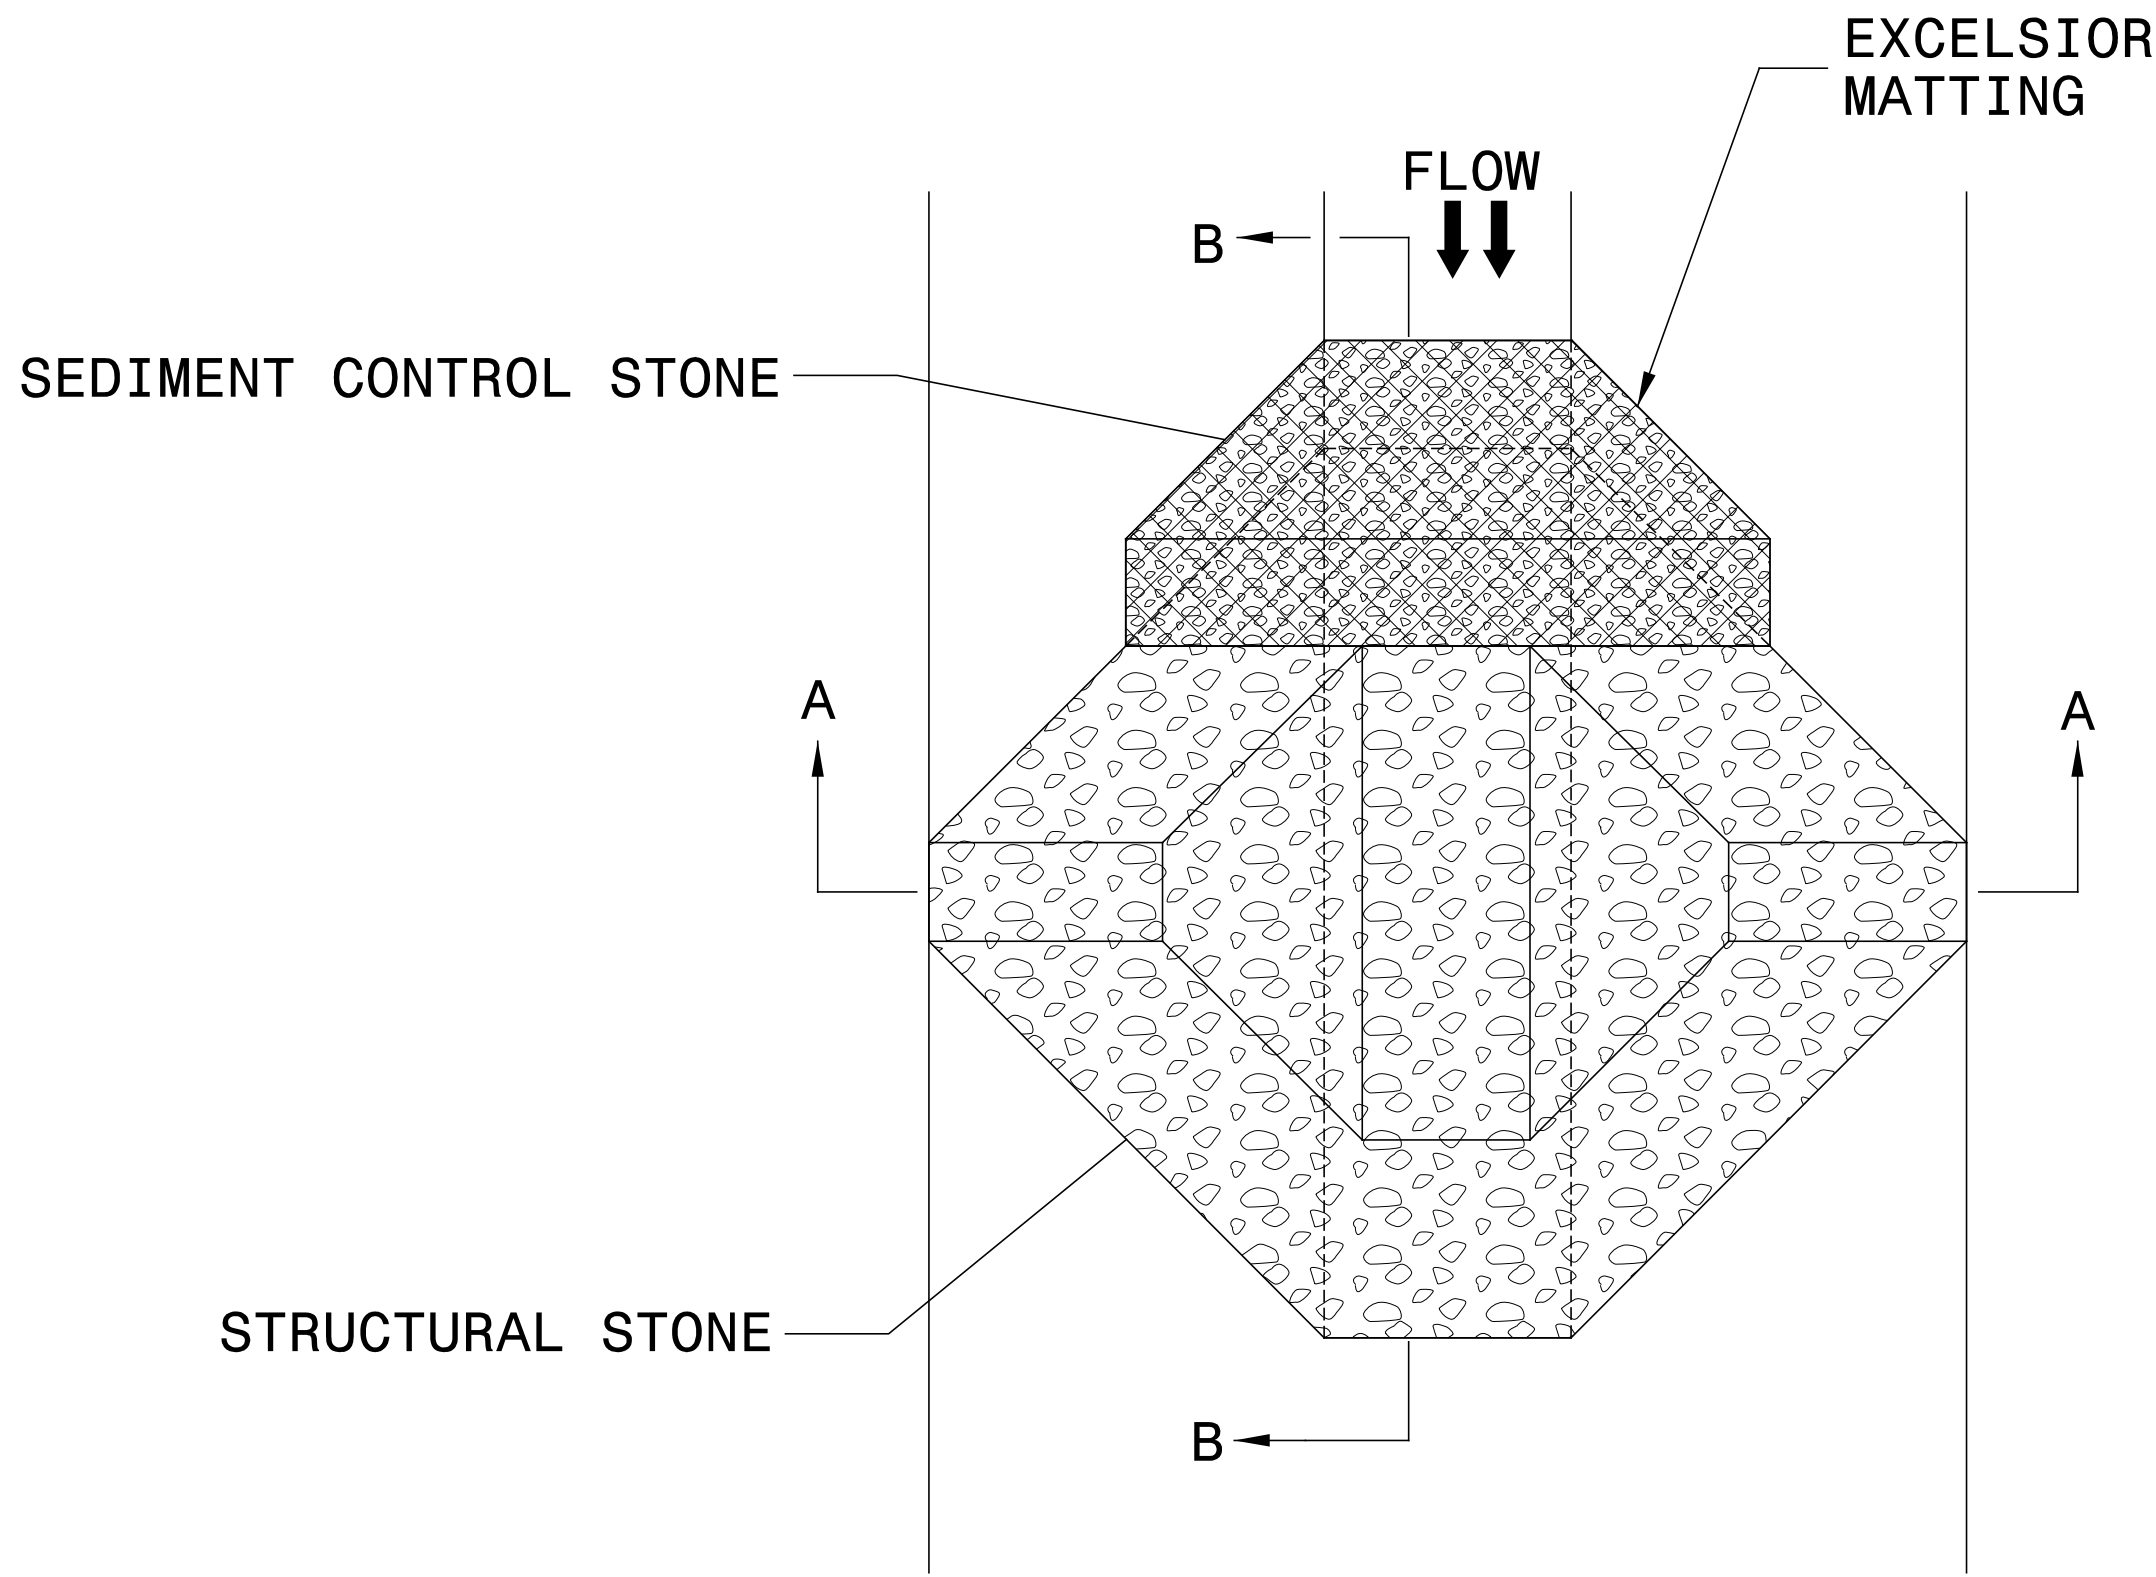

PLAN

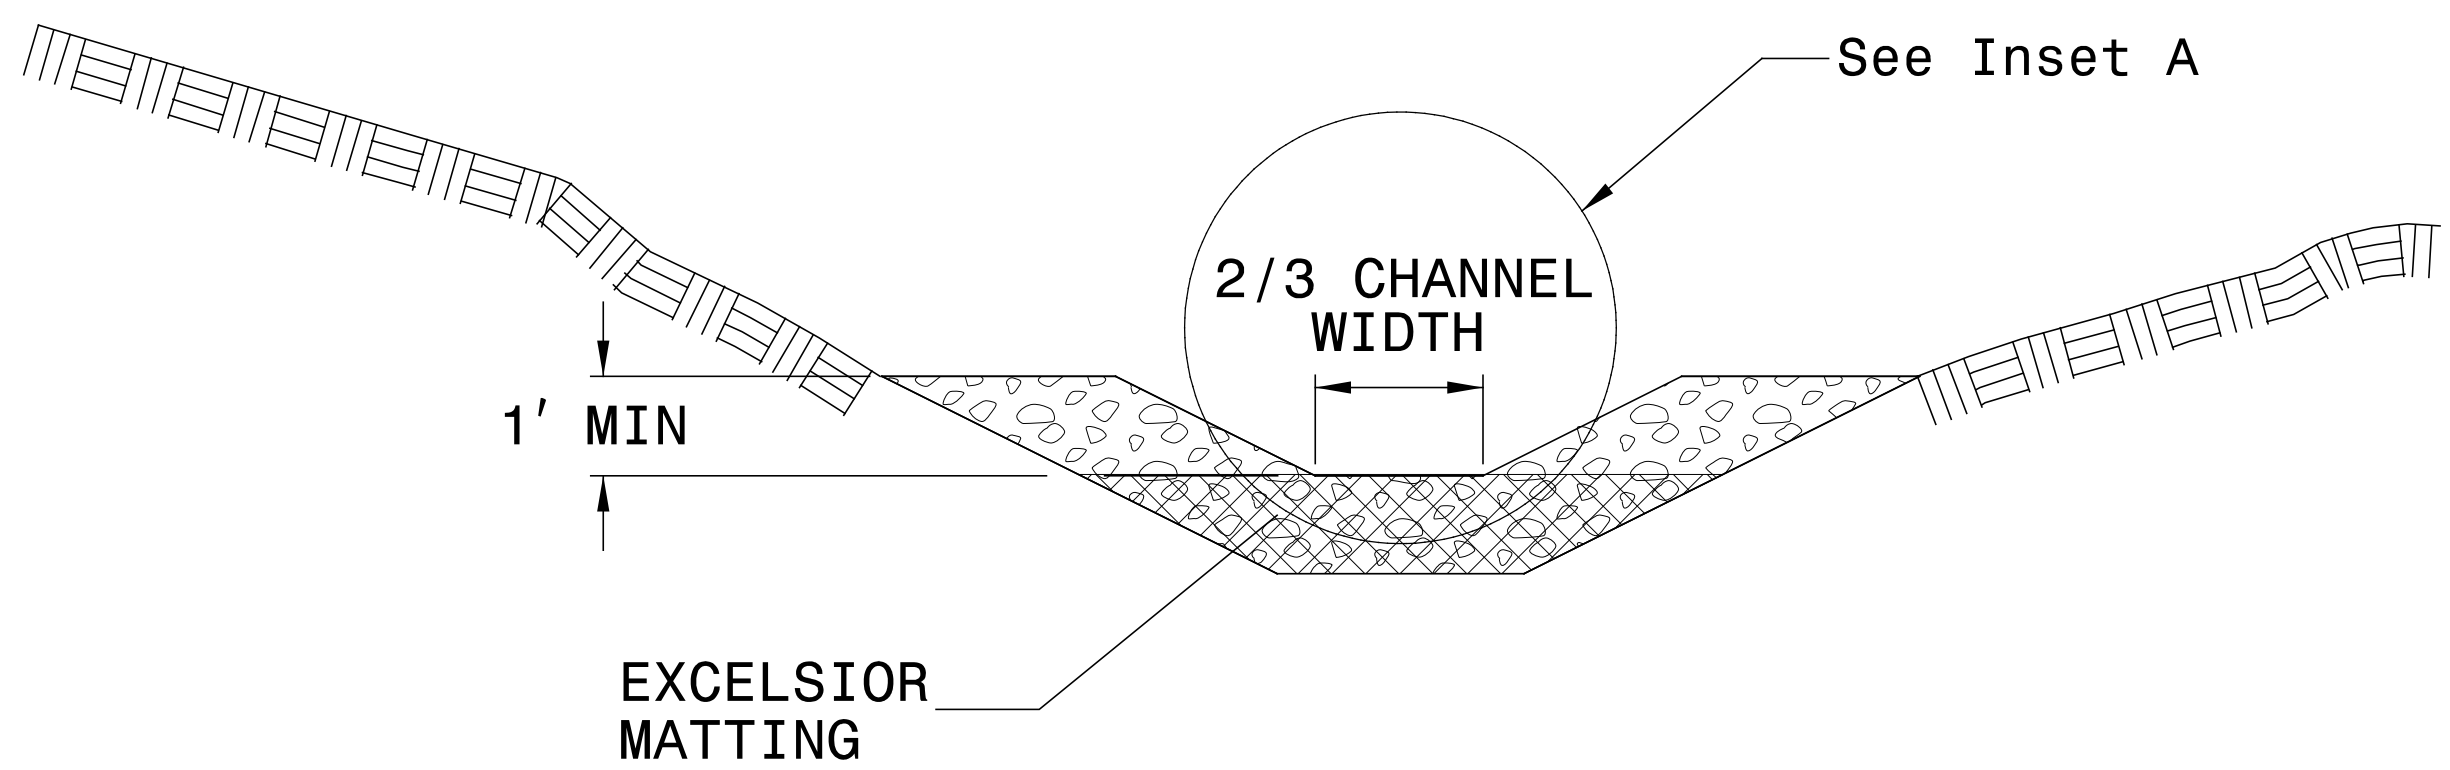

SECTION A-A


NOTES:

INSTALL TEMPORARY ROCK SILT CHECK TYPE A IN ACCORDANCE WITH ROADWAY STANDARD DRAWING NO. 1633.01.


USE EXCELSIOR FOR MATTING MATERIAL AND ANCHOR MATTING SECTION AT TOP AND BOTTOM WITH CLASS B STONE.

PRIOR TO POLYACRYLAMIDE (PAM) APPLICATION, OBTAIN A SOIL SAMPLE FROM PROJECT LOCATION, AND FROM OFFSITE MATERIAL, AND ANALYZE FOR APPROPRIATE PAM FLOCCULANT TO BE APPLIED TO EACH ROCK SILT CHECK.

INITIALLY APPLY 4 OUNCES OF POLYACRYLAMIDE (PAM) TO TOP OF MATTING SECTION AND AFTER EVERY RAINFALL EVENT THAT EQUALS OR EXCEEDS 0.50 INCHES.

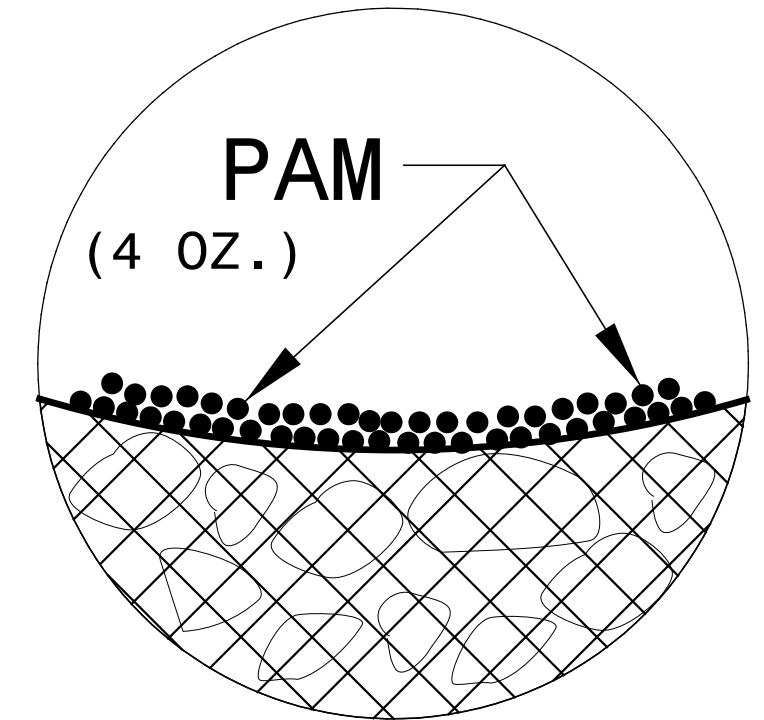

INSET A

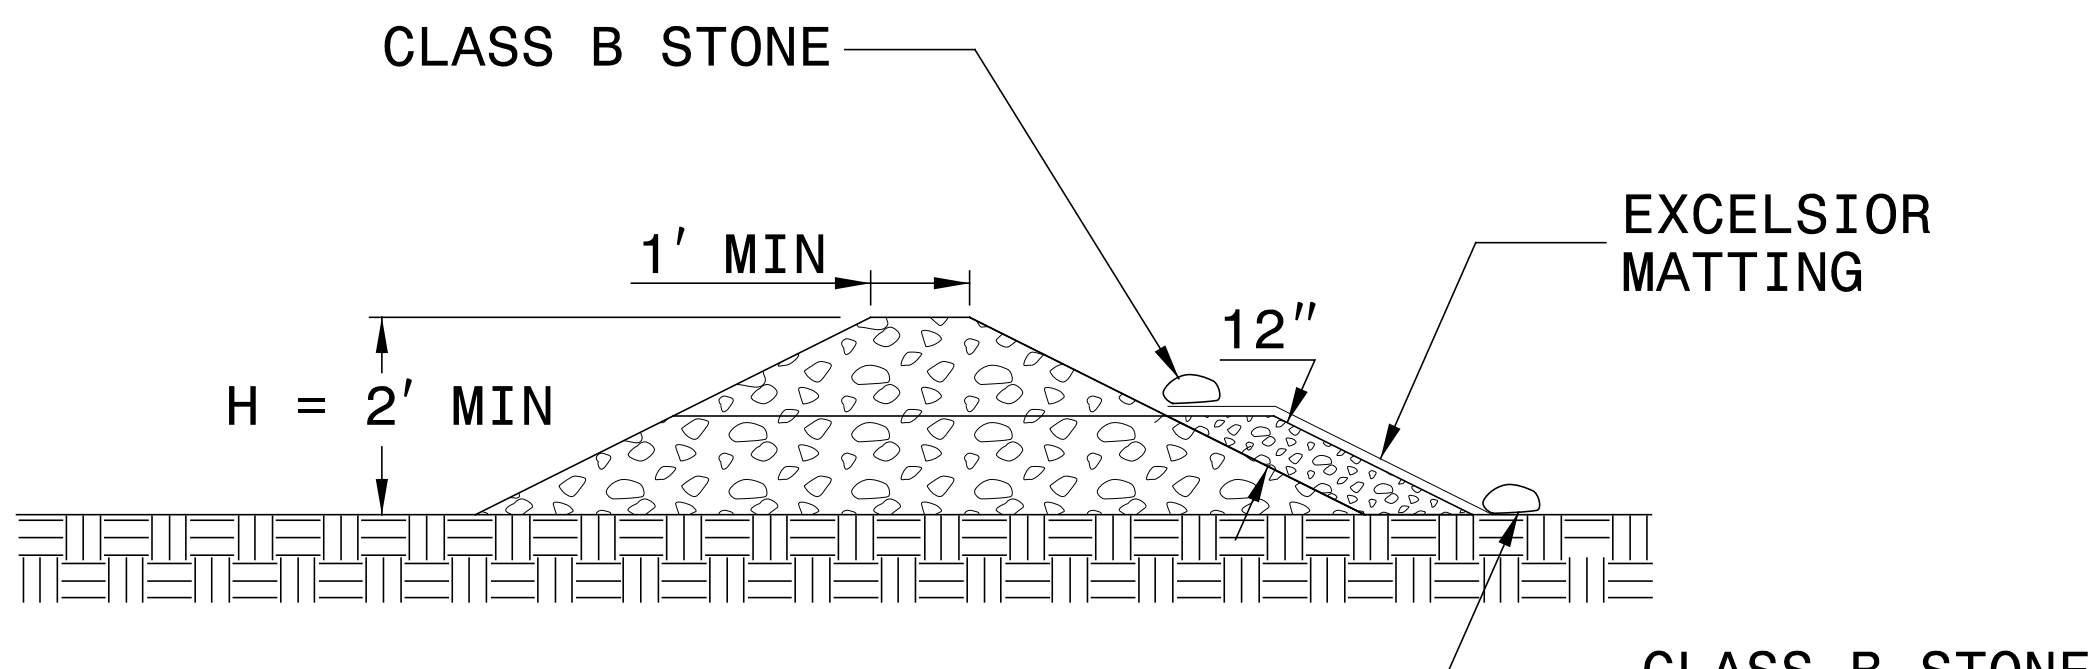

SECTION B-B


NOT TO SCALE

DIVISION OF HIGHWAYS
STATE OF NORTH CAROLINA


SOIL STABILIZATION TIMEFRAMES

SITE DESCRIPTION	STABILIZATION TIME	TIMEFRAME EXCEPTIONS
PERIMETER DIKES, SWALES, DITCHES AND SLOPES	7 DAYS	NONE
HIGH QUALITY WATER (HQW) ZONES	7 DAYS	NONE
SLOPES STEEPER THAN 3:1	7 DAYS	IF SLOPES ARE 10' OR LESS IN LENGTH AND ARE NOT STEEPER THAN 2:1, 14 DAYS ARE ALLOWED.
SLOPES 3:1 OR FLATTER	14 DAYS	7 DAYS FOR SLOPES GREATER THAN 50' IN LENGTH.
ALL OTHER AREAS WITH SLOPES FLATTER THAN 4:1	14 DAYS	NONE, EXCEPT FOR PERIMETERS AND HQW ZONES.

CLEARING AND GRUBBING
EROSION CONTROL FOR
CONSTRUCTION SHEET 04

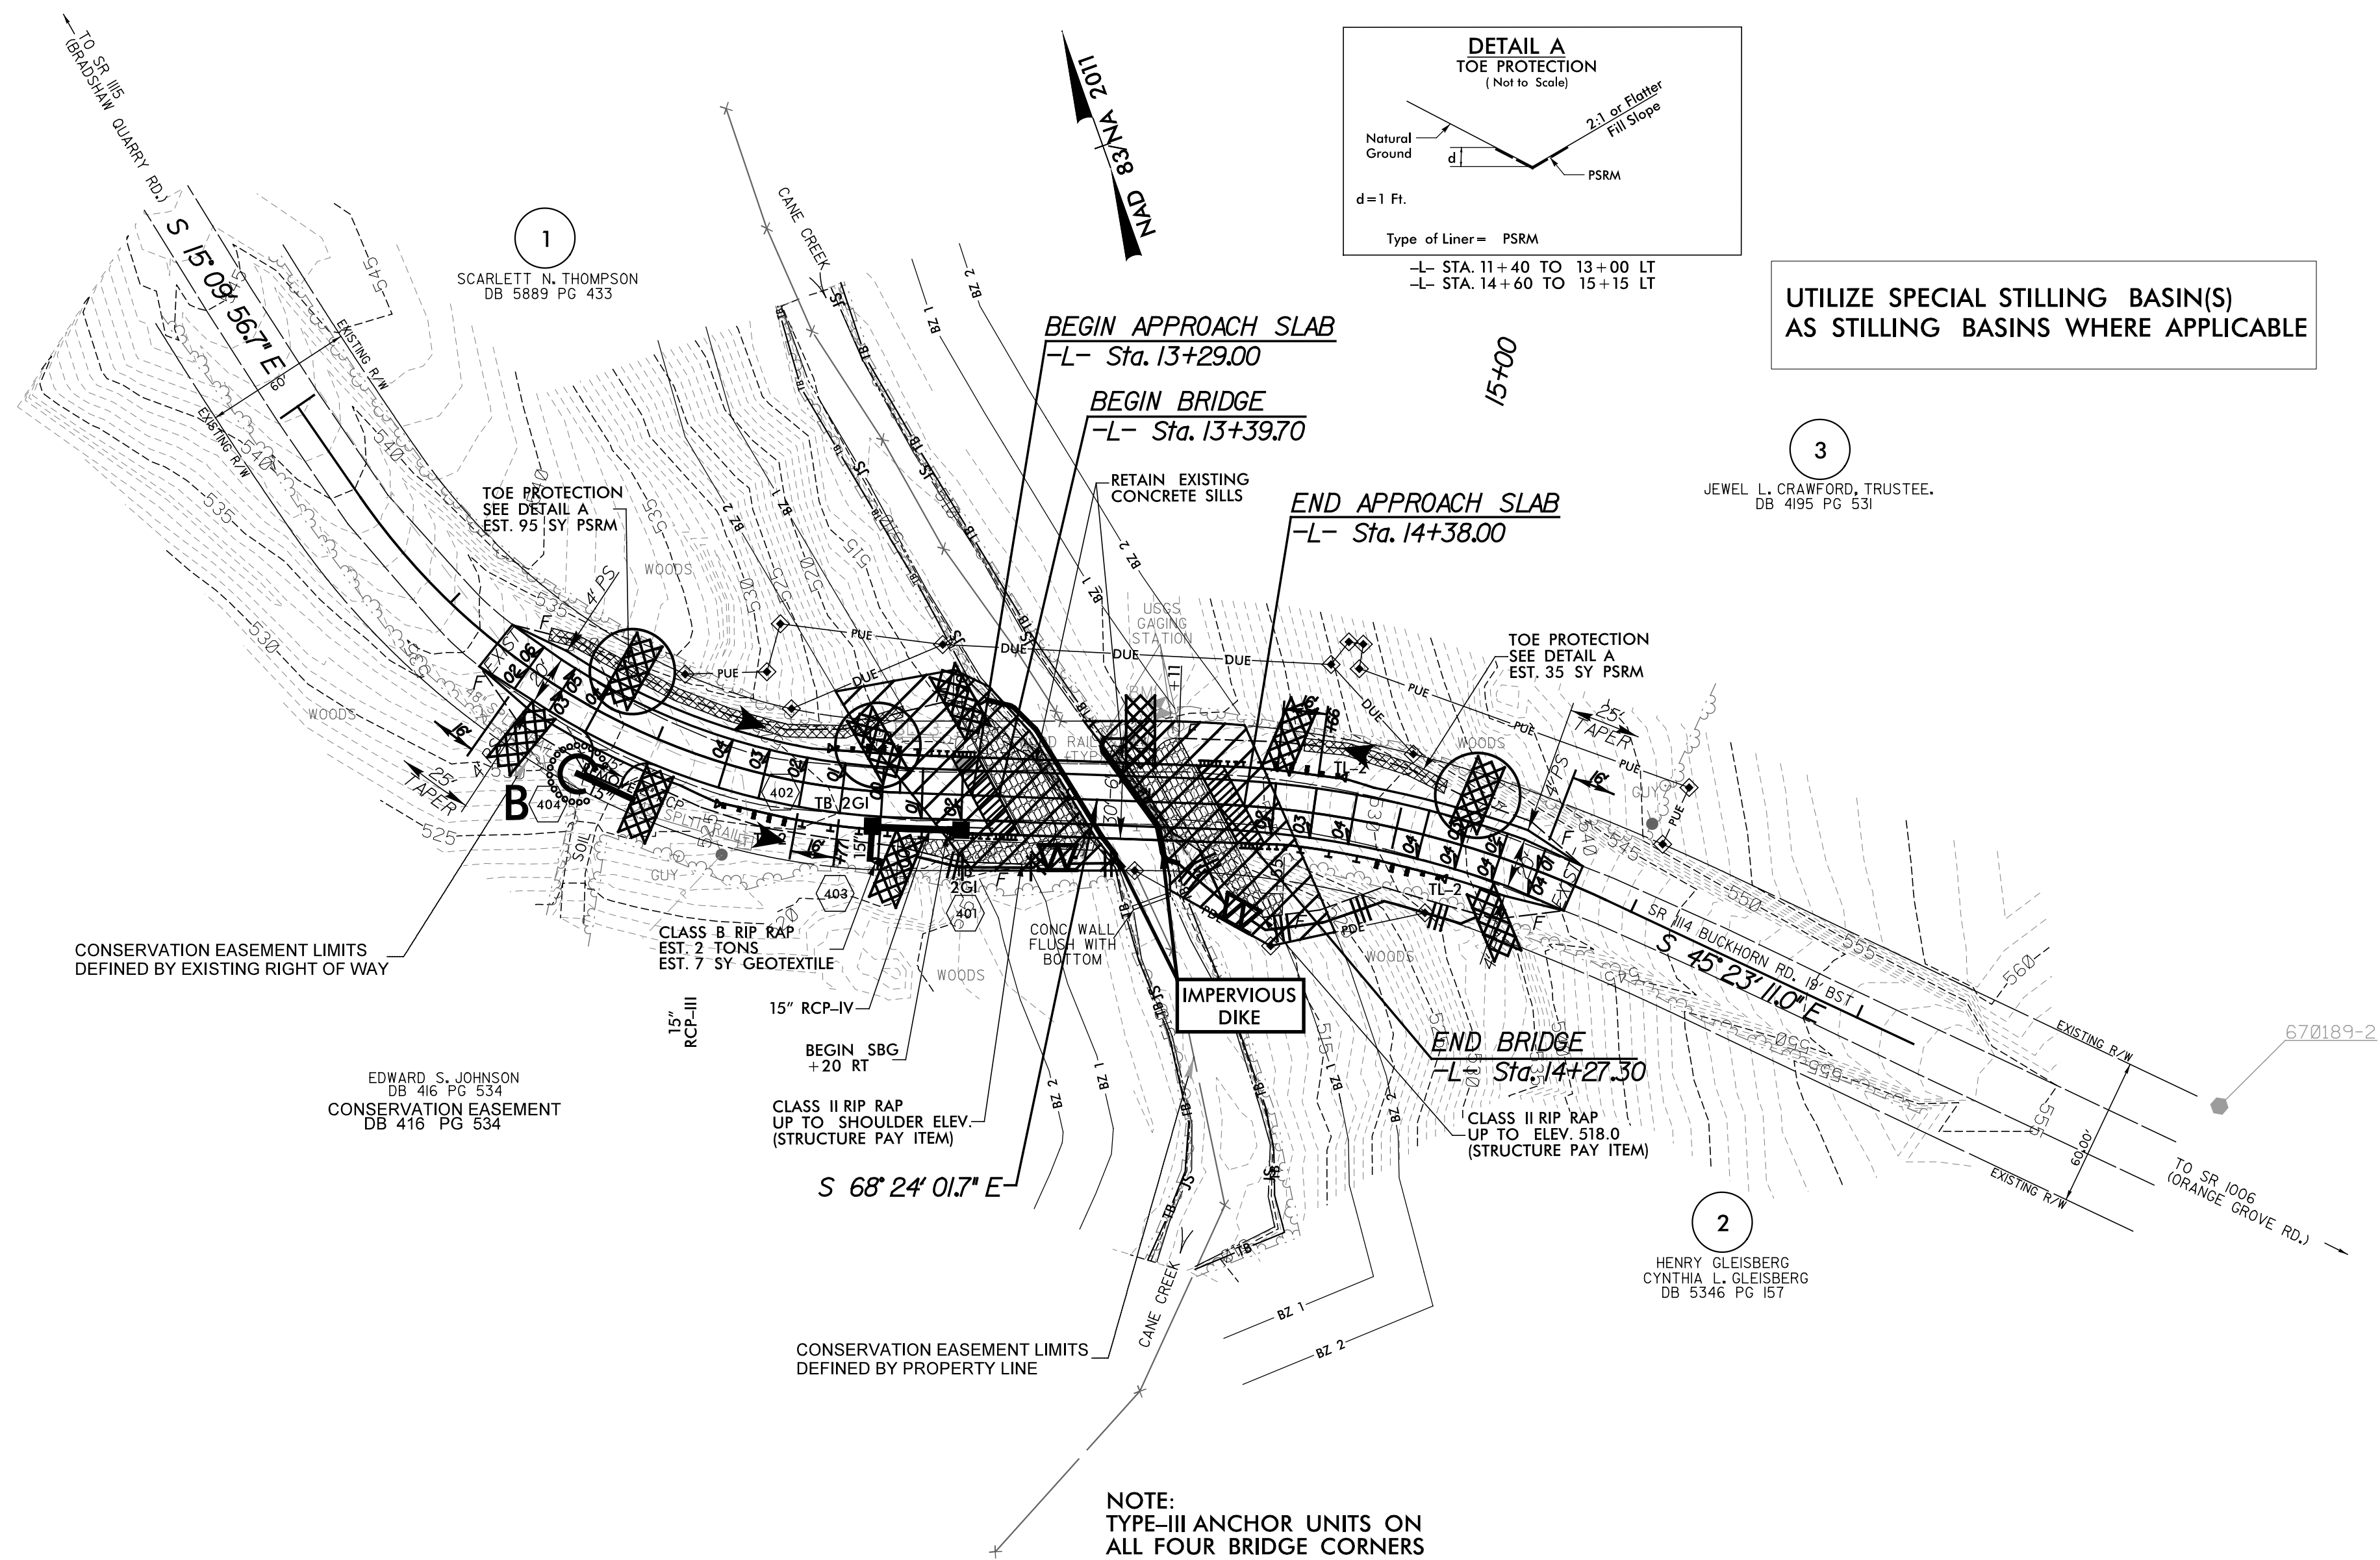

ICA ENGINEERING, INC.
R:\Hydraulics\Erosion Control\cadd\670189_hyd_erosion_final_psh04.dgn
3/27/2017
\$\$\$\$DATE\$

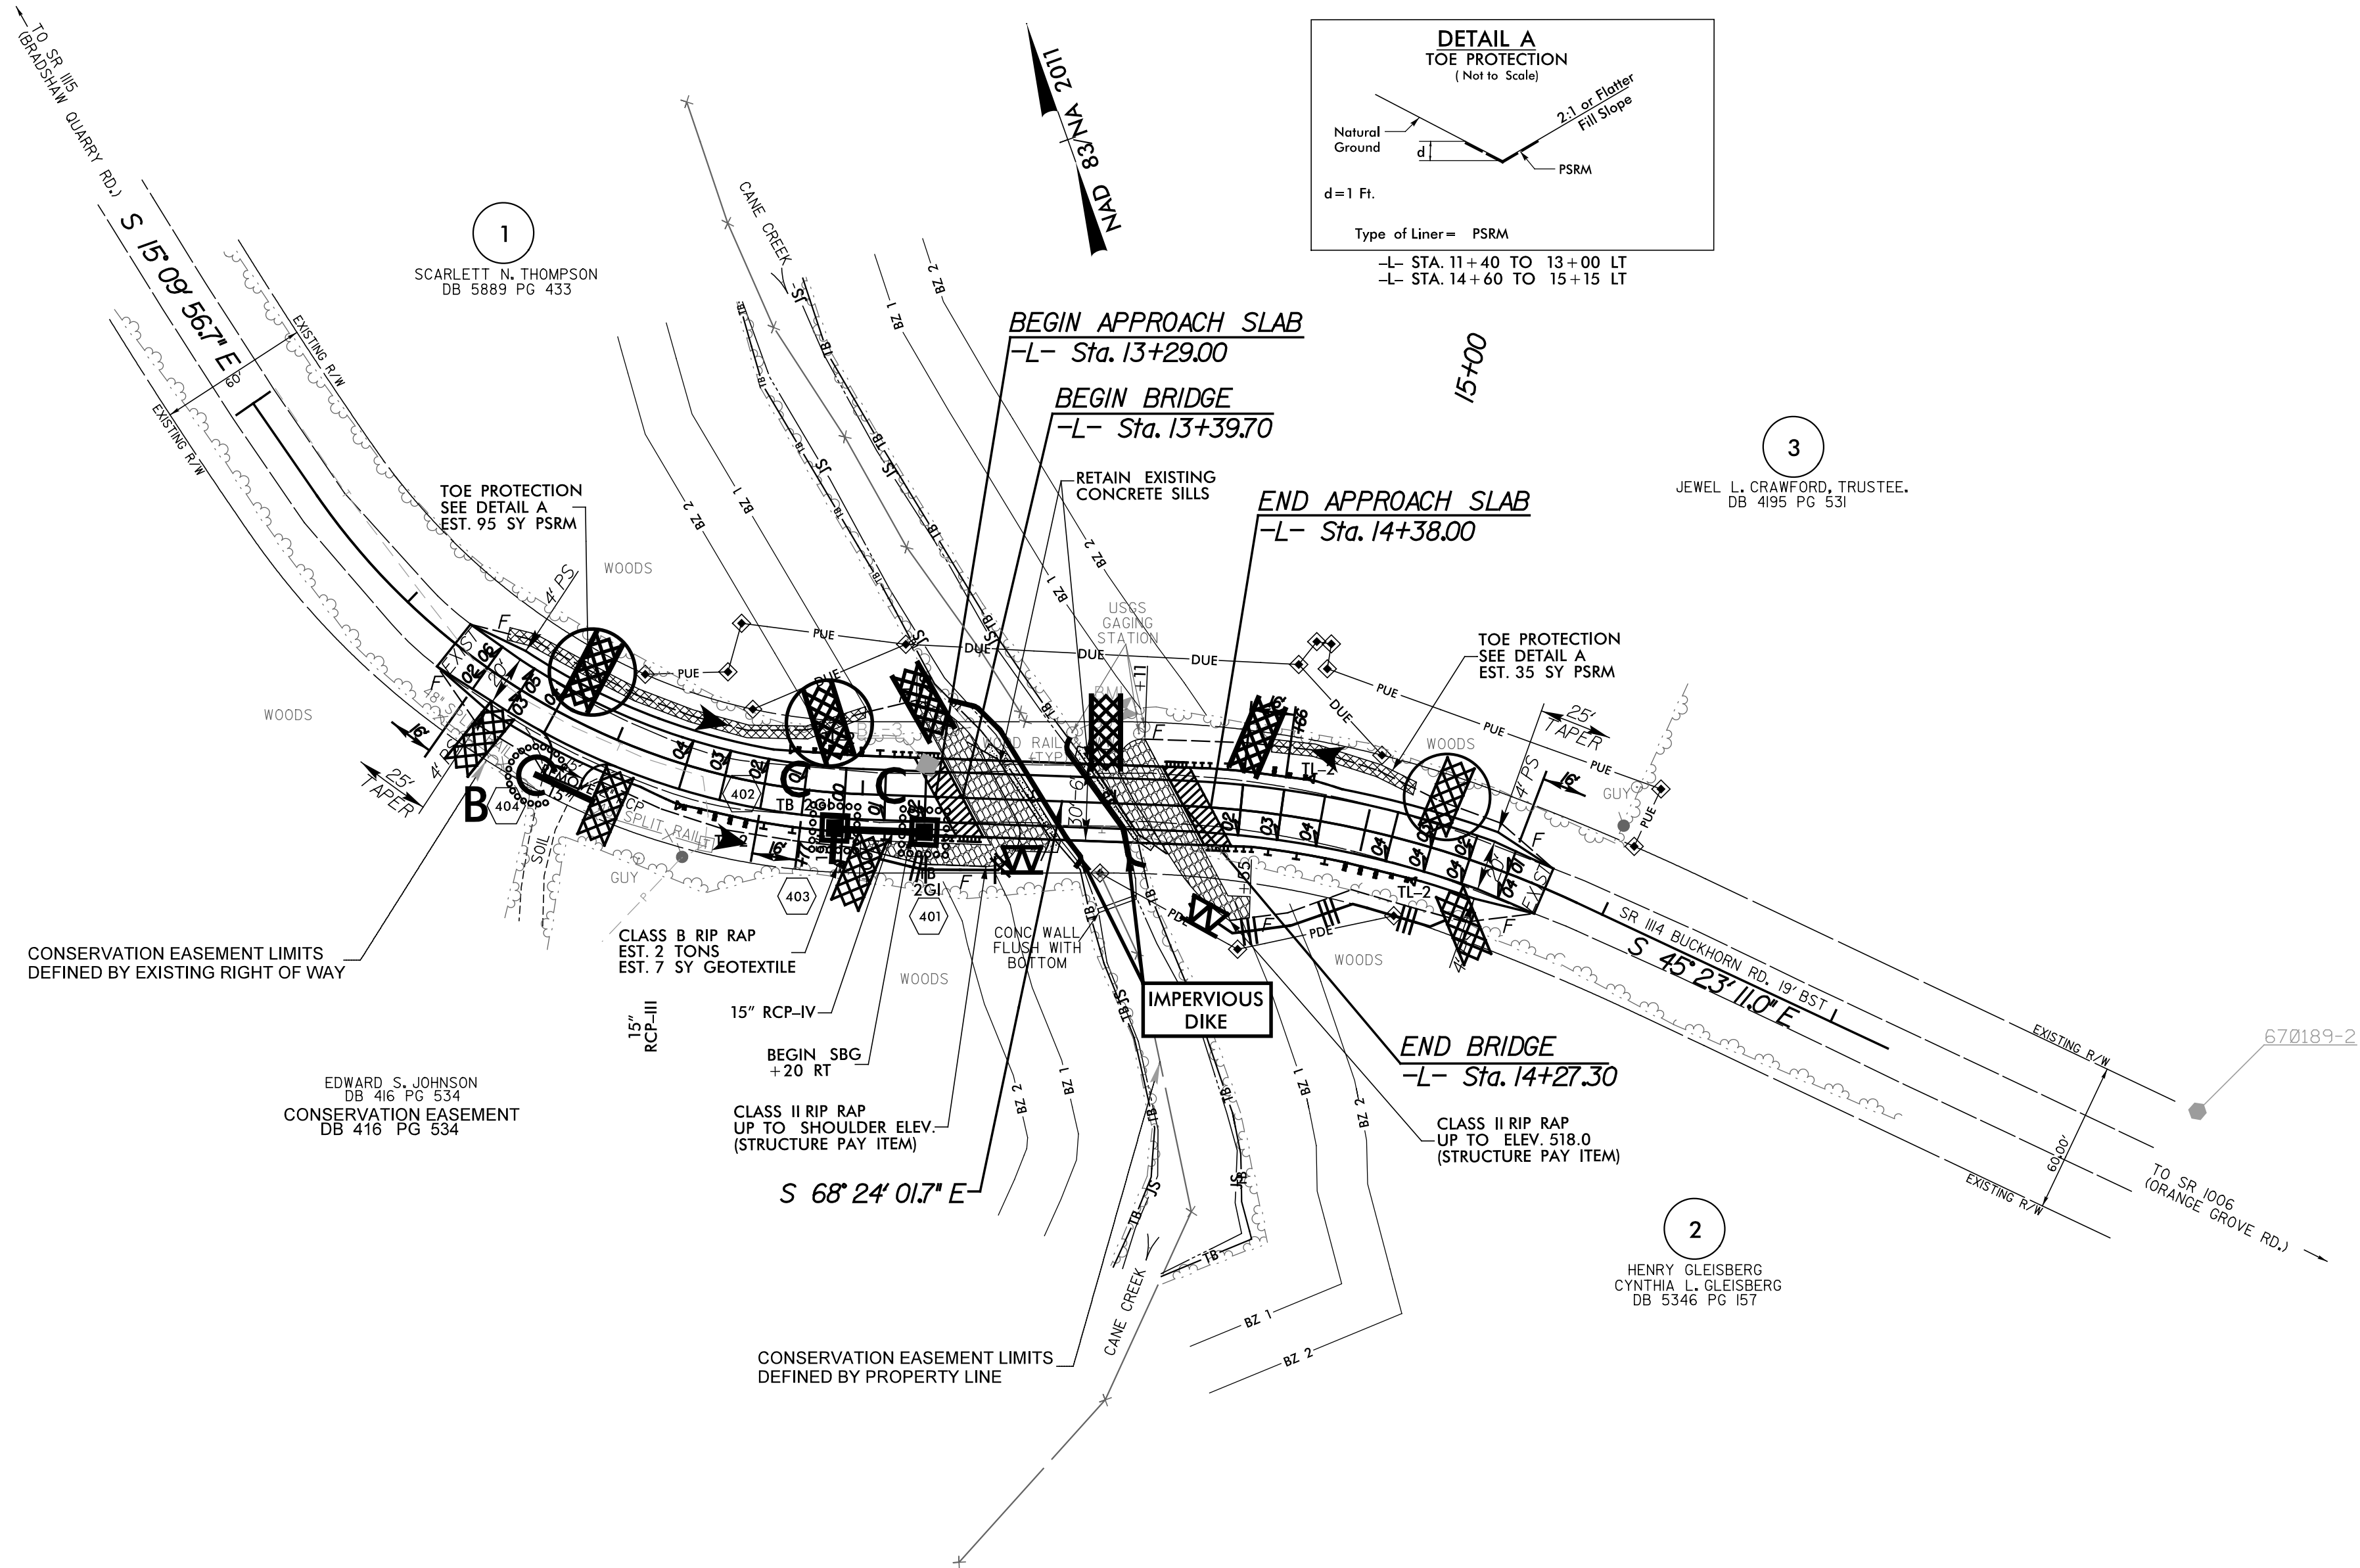

PROJECT REFERENCE	SHEET NO.
17BP.7.R.98 - ORANGE 189	EC-05/CONST.04
ROADSIDE ENVIRONMENTAL PROJECT ENGINEER	
LEVEL III CERTIFIED BY: STACEY H. BAILEY, PE CERTIFICATION NUMBER: 3074 ISSUED: MARCH 17, 2017	

Prepared in the Office of:

M PO Box 700
MOTT MACDONALD Fuquay-Varina, NC 27526
www.mottmac.com

ICA Engineering 1121 Kingdom Way, Suite 100
Raleigh, NC 27607
NC License No. F4228


FINAL EROSION CONTROL
FOR CONSTRUCTION
SHEET 04

STATE	STATE PROJECT REFERENCE NO.	SHEET NO.	TOTAL SHEETS
N.C.	17BP.7.R.98	RF-1	
STATE PROJ.NO.	F.A.PROJ.NO.	DESCRIPTION	


PLANTING DETAILS
SEEDLING / LINER BARERROOT PLANTING DETAIL

HEALING IN


1. Locate a healing-in site in a shady, well protected area.
2. Excavate a flat bottom trench 12 inches deep and provide drainage.

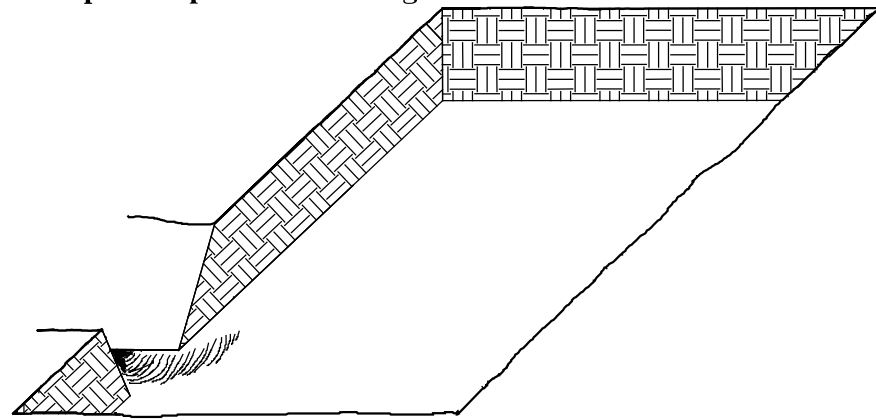


3. Backfill the trench with 2 inches well rotted sawdust. Place a 2 inch layer of well rotted sawdust at a sloping angle at one end of the trench.

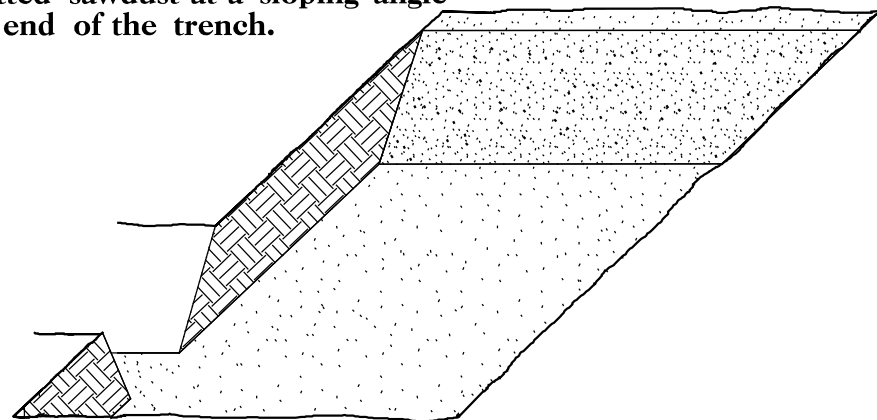

4. Place a single layer of plants against the sloping end so that the root collar is at ground level.

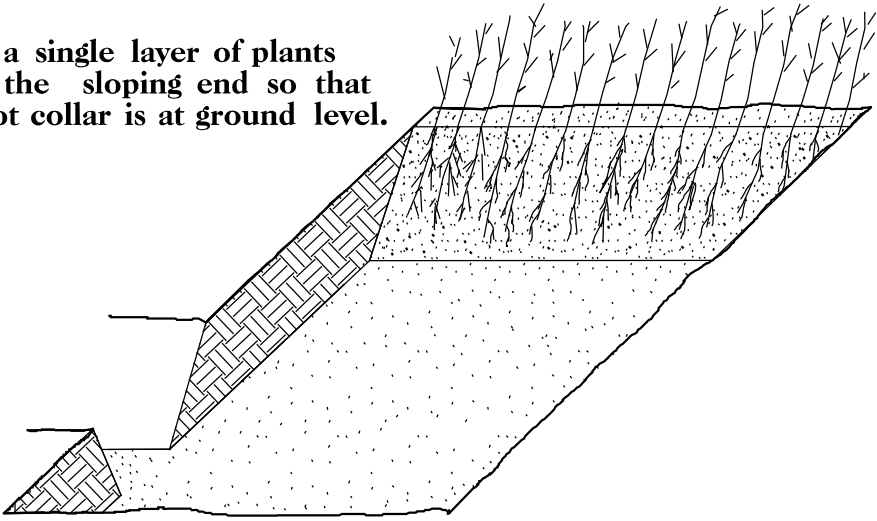


5. Place a 2 inch layer of well rotted sawdust over the roots maintaining a sloping angle.

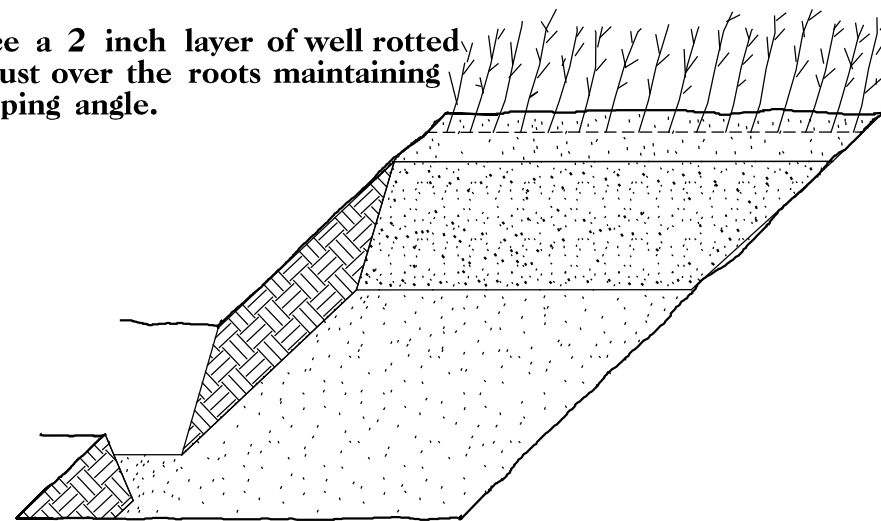


6. Repeat layers of plants and sawdust as necessary and water thoroughly.


DIBBLE PLANTING METHOD
USING THE KBC PLANTING BAR

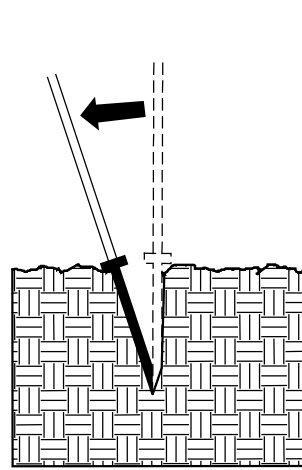


1. Insert planting bar as shown and pull handle toward planter.

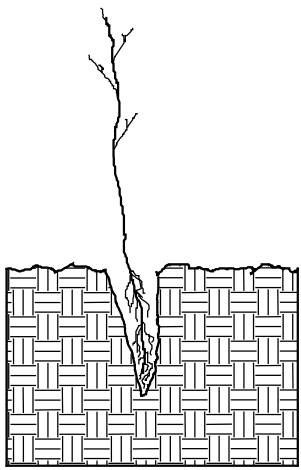


2. Remove planting bar and place seedling at correct depth.

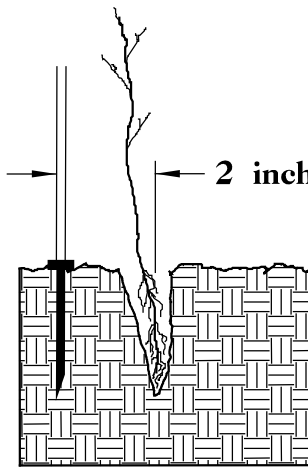


3. Insert planting bar 2 inches toward planter from seedling.

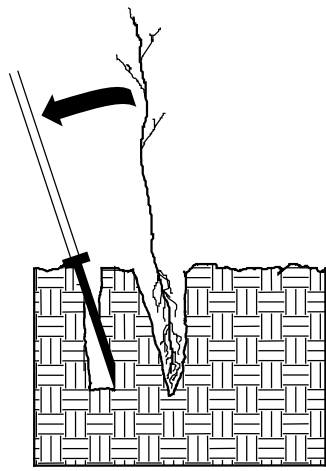

4. Pull handle of bar toward planter, firming soil at bottom.

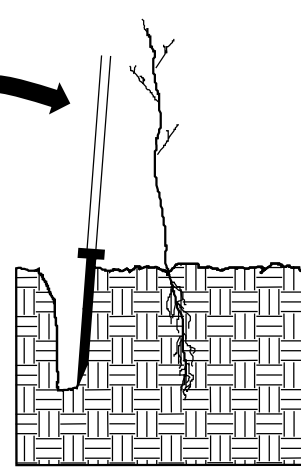

5. Push handle forward firming soil at top.

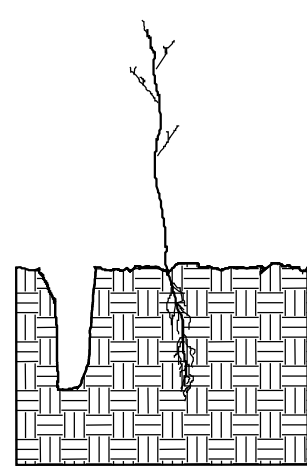


6. Leave compaction hole open. Water thoroughly.

PLANTING NOTES:

PLANTING BAG
During planting, seedlings shall be kept in a moist canvas bag or similar container to prevent the root systems from drying.



KBC PLANTING BAR
Planting bar shall have a blade with a triangular cross section, and shall be 12 inches long, 4 inches wide and 1 inch thick at center.

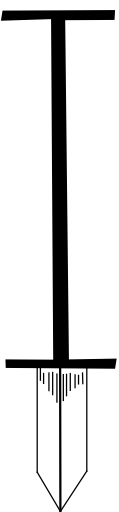

ROOT PRUNING
All seedlings shall be root pruned, if necessary, so that no roots extend more than 10 inches below the root collar.

REFORESTATION

- ☐ TREE REFORESTATION SHALL BE PLANTED 6 FT. TO 10 FT. ON CENTER, RANDOM SPACING, AVERAGING 8 FT. ON CENTER, APPROXIMATELY 680 PLANTS PER ACRE.

REFORESTATION

MIXTURE, TYPE, SIZE, AND FURNISH SHALL CONFORM TO THE FOLLOWING:

25% LIRIODENDRON TULIPIFERA	TULIP POPLAR	12 in - 18 in BR
25% PLATANUS OCCIDENTALIS	AMERICAN SYCAMORE	12 in - 18 in BR
25% FRAXINUS PENNSYLVANICA	GREEN ASH	12 in - 18 in BR
25% BETULA NIGRA	RIVER BIRCH	12 in - 18 in BR

REFORESTATION DETAIL SHEET


N.C.D.O.T. - ROADSIDE ENVIRONMENTAL UNIT

DESIGN EXCEPTION:
MIN. HORIZONTAL CURVE RADIUS
SAG VERTICAL CURVE K
HORIZONTAL SSD
VERTICAL SSD
SUPERELEVATION

CENTURYLINK SERVICE CABLE
WILL REMAIN IN PLACE.
EXERCISE CAUTION DURING
GUARDRAIL INSTALLATION TO
EXTENT PRACTICABLE.

DATUM DESCRIPTION
THE LOCALIZED COORDINATE SYSTEM DEVELOPED FOR THIS PROJECT
IS BASED ON THE STATE PLANE COORDINATES ESTABLISHED BY
NCDOT FOR MONUMENT "670189-2"
WITH NAD 83/NA 2011 STATE PLANE GRID COORDINATES OF
NORTHING: 814039.721(±) EASTING: 1939382.819(±)
ELEVATION: 559.70(±)
THE AVERAGE COMBINED GRID FACTOR USED ON THIS PROJECT
(GROUND TO GRID) IS: 0.999327483
THE N.C. LAMBERT GRID BEARING AND
LOCALIZED HORIZONTAL GROUND DISTANCE FROM
"670189-2" TO -L- STATION 10+00.00 IS
N 50° 28' 11.9" W DISTANCE: 820.06 ft
ALL LINEAR DIMENSIONS ARE LOCALIZED HORIZONTAL DISTANCES
VERTICAL DATUM USED IS NAVD 88

BM1 ELEVATION = 522.00
N 814332 E 1939036
BL STATION 19+96.00 42 RIGHT
BENCH TIE SPIKE IN 14" OAK

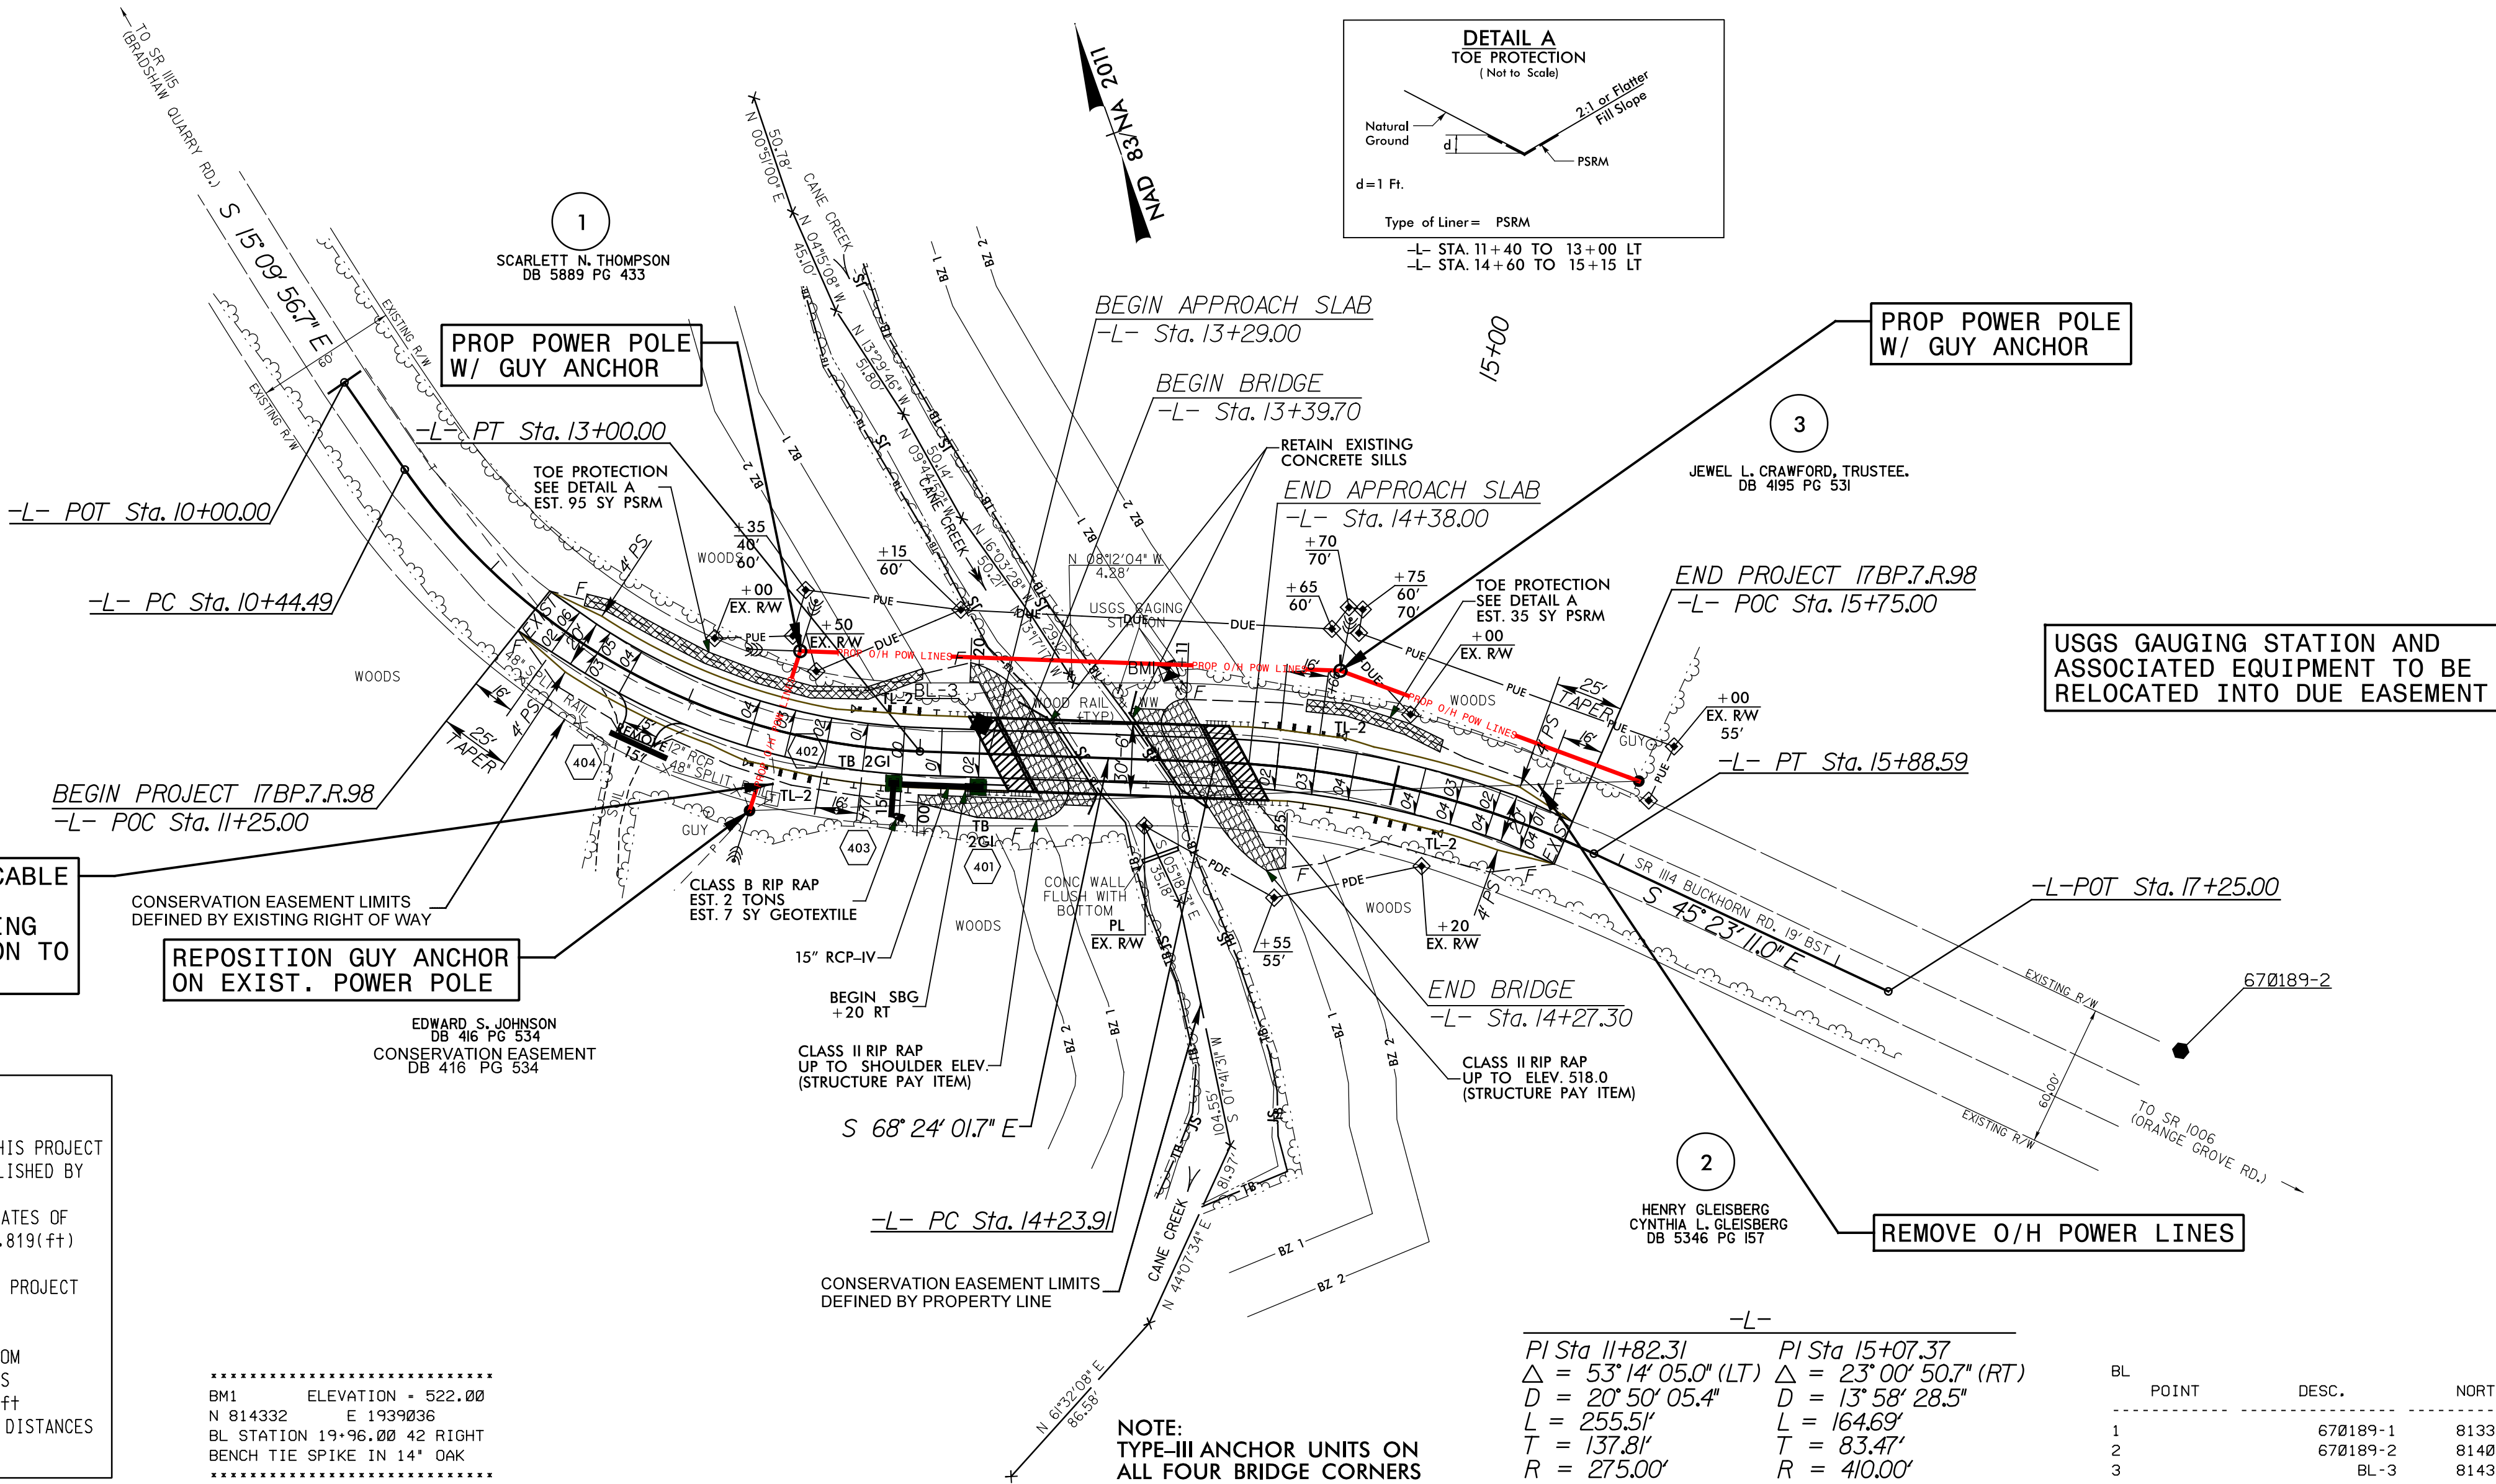

PROJECT REFERENCE
17BP.7.R.98 - ORANGE 189

SHEET NO.
UO-1

Prepared in the
Office of:

THE WOOTEN COMPANY
120 North Boylan Avenue Raleigh, NC 27603-1423
919.828.0531 fax 919.834.3589
License Number: F-0115

DOCUMENT NOT CONSIDERED FINAL
UNLESS ALL SIGNATURES COMPLETED


GRAPHIC SCALE
25' 0 25' 50'

UTILITIES BY OTHERS

NOTE:
ALL PROPOSED UTILITY WORK
SHOWN ON THIS SHEET WILL
BE DONE BY OTHERS


3/28/2017 8:26:35 AM
R:\Corporat\Xsc\Xpl\G\0189_Fdy_xpl.dgn
0960103

--

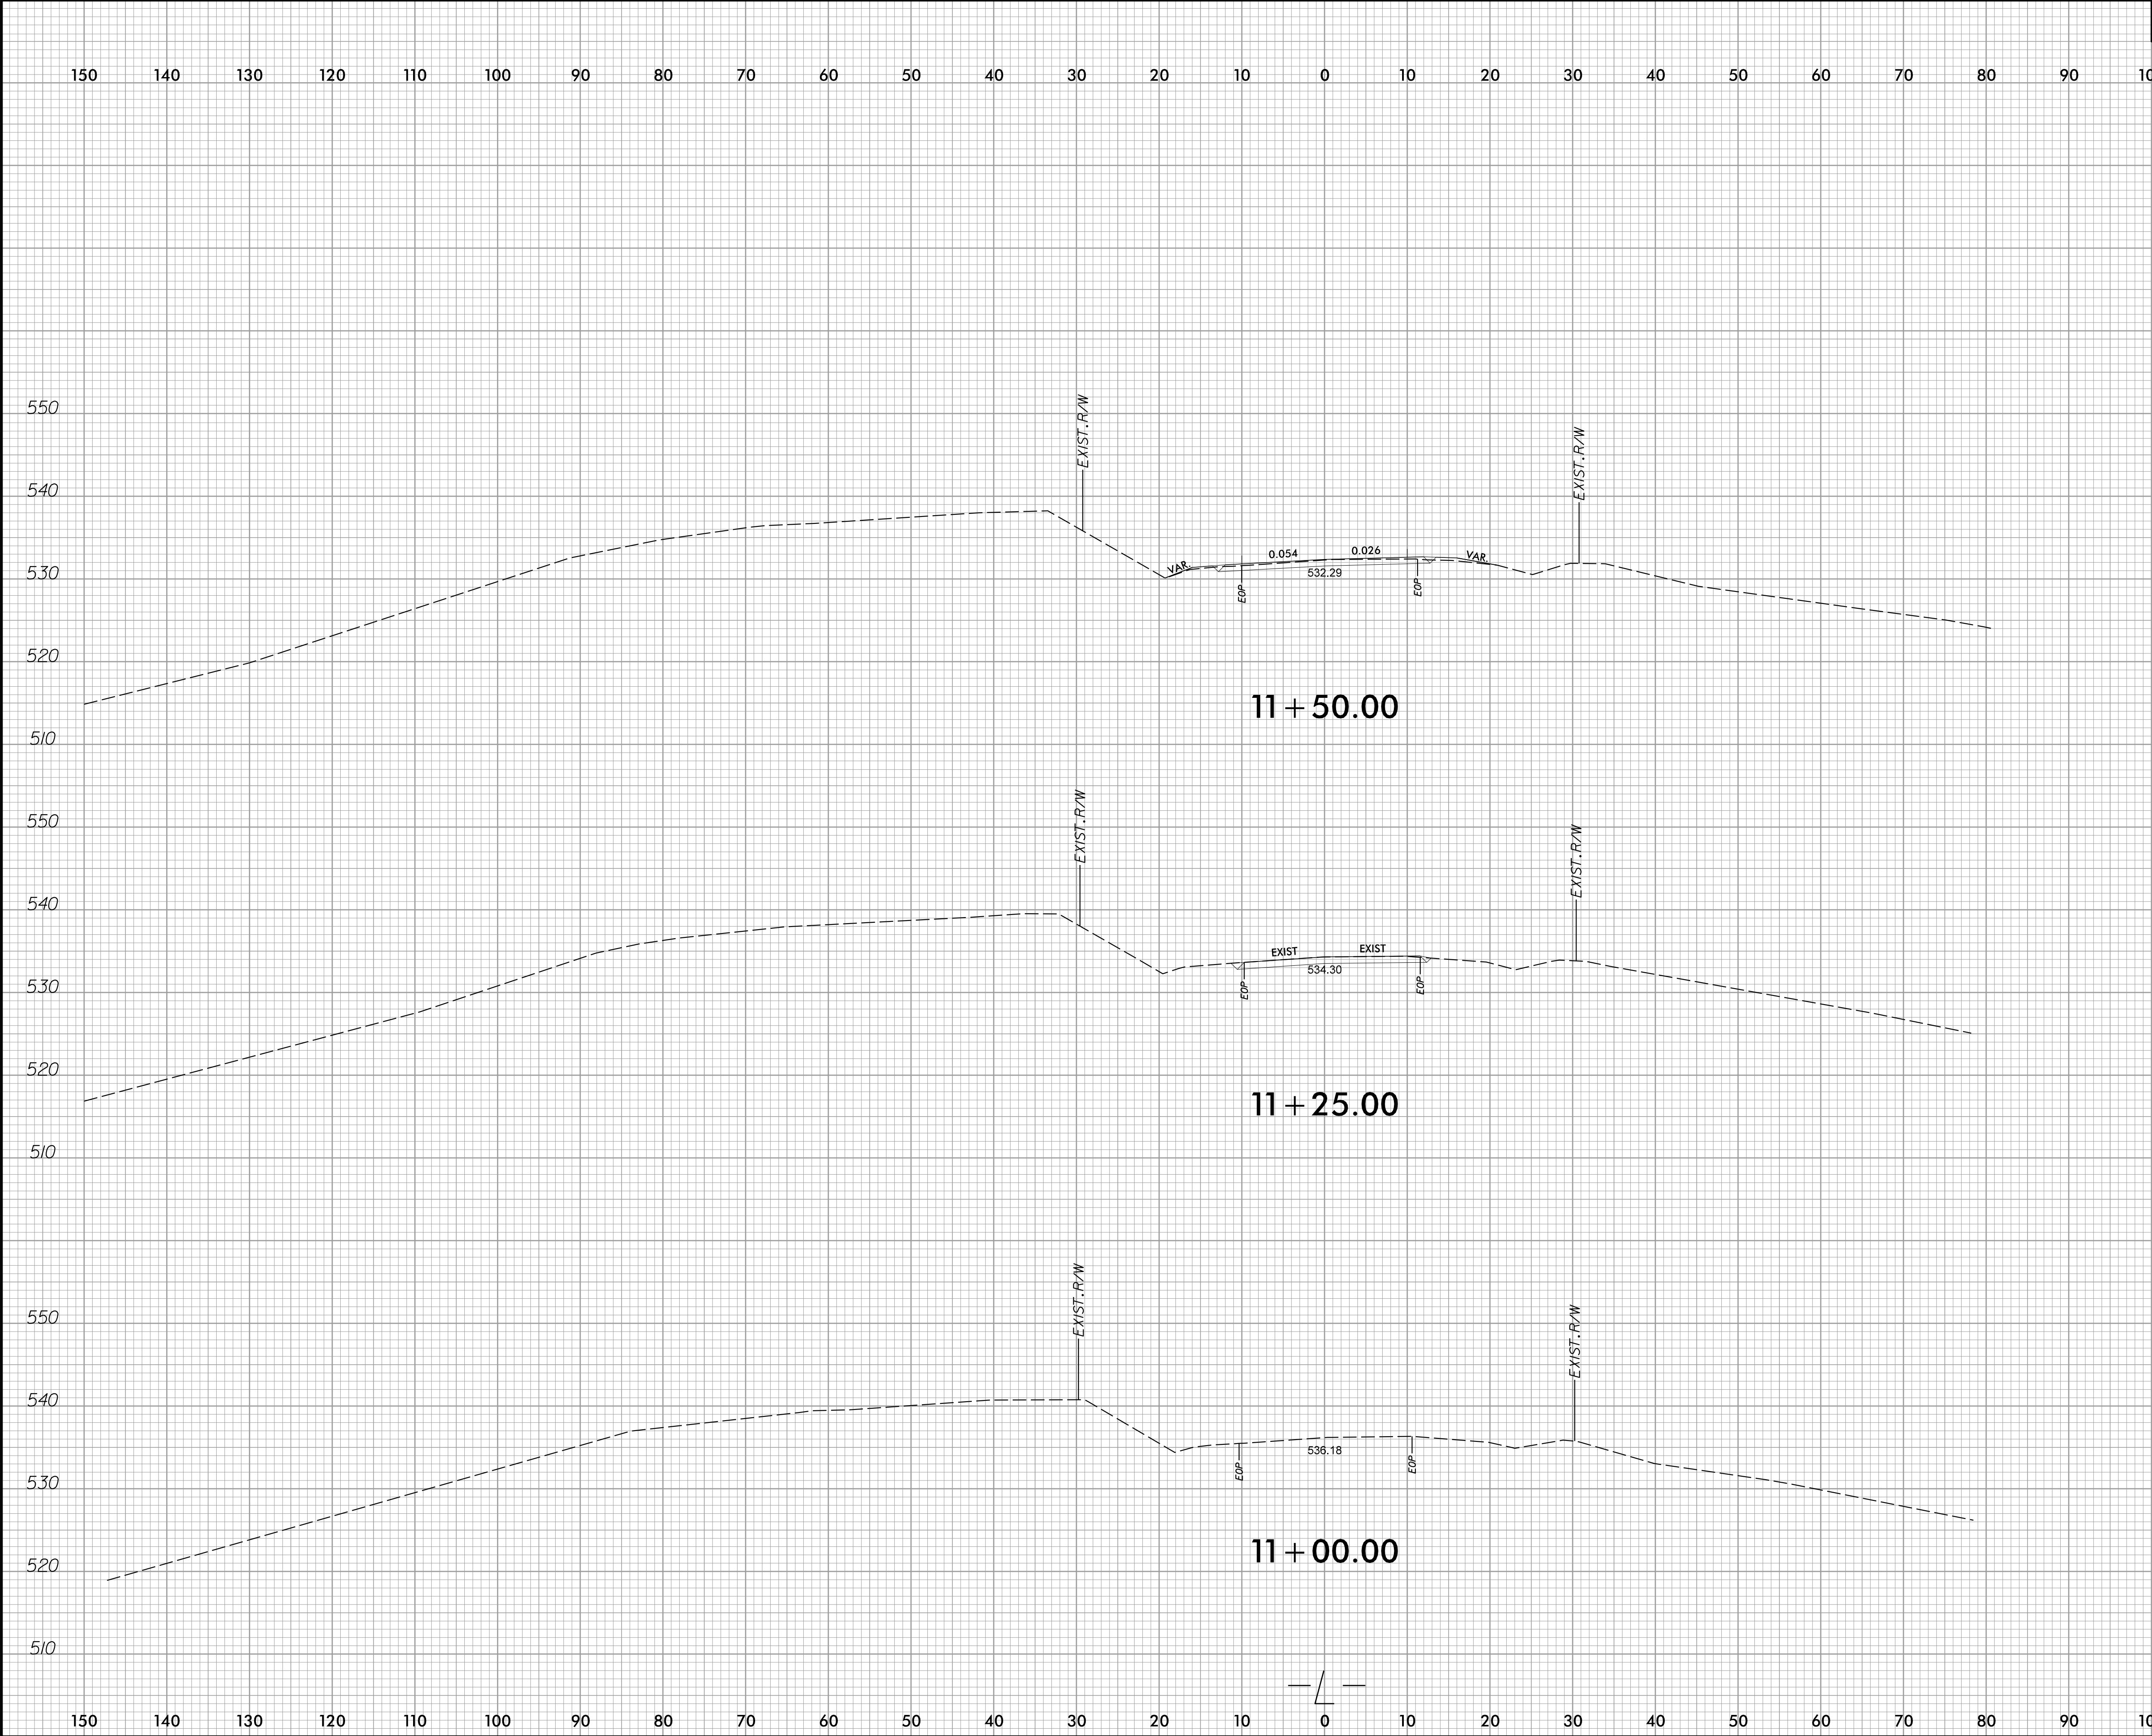


3/28/2017 8:26:35 AM
R:\Corps\ex\Xsc\Xpl\670189_Fdy_xpl.dgn
0960103

	PROJECT REFERENCE	SHEET NO.
	17BP.7.R.98 – ORANGE 189	X-2

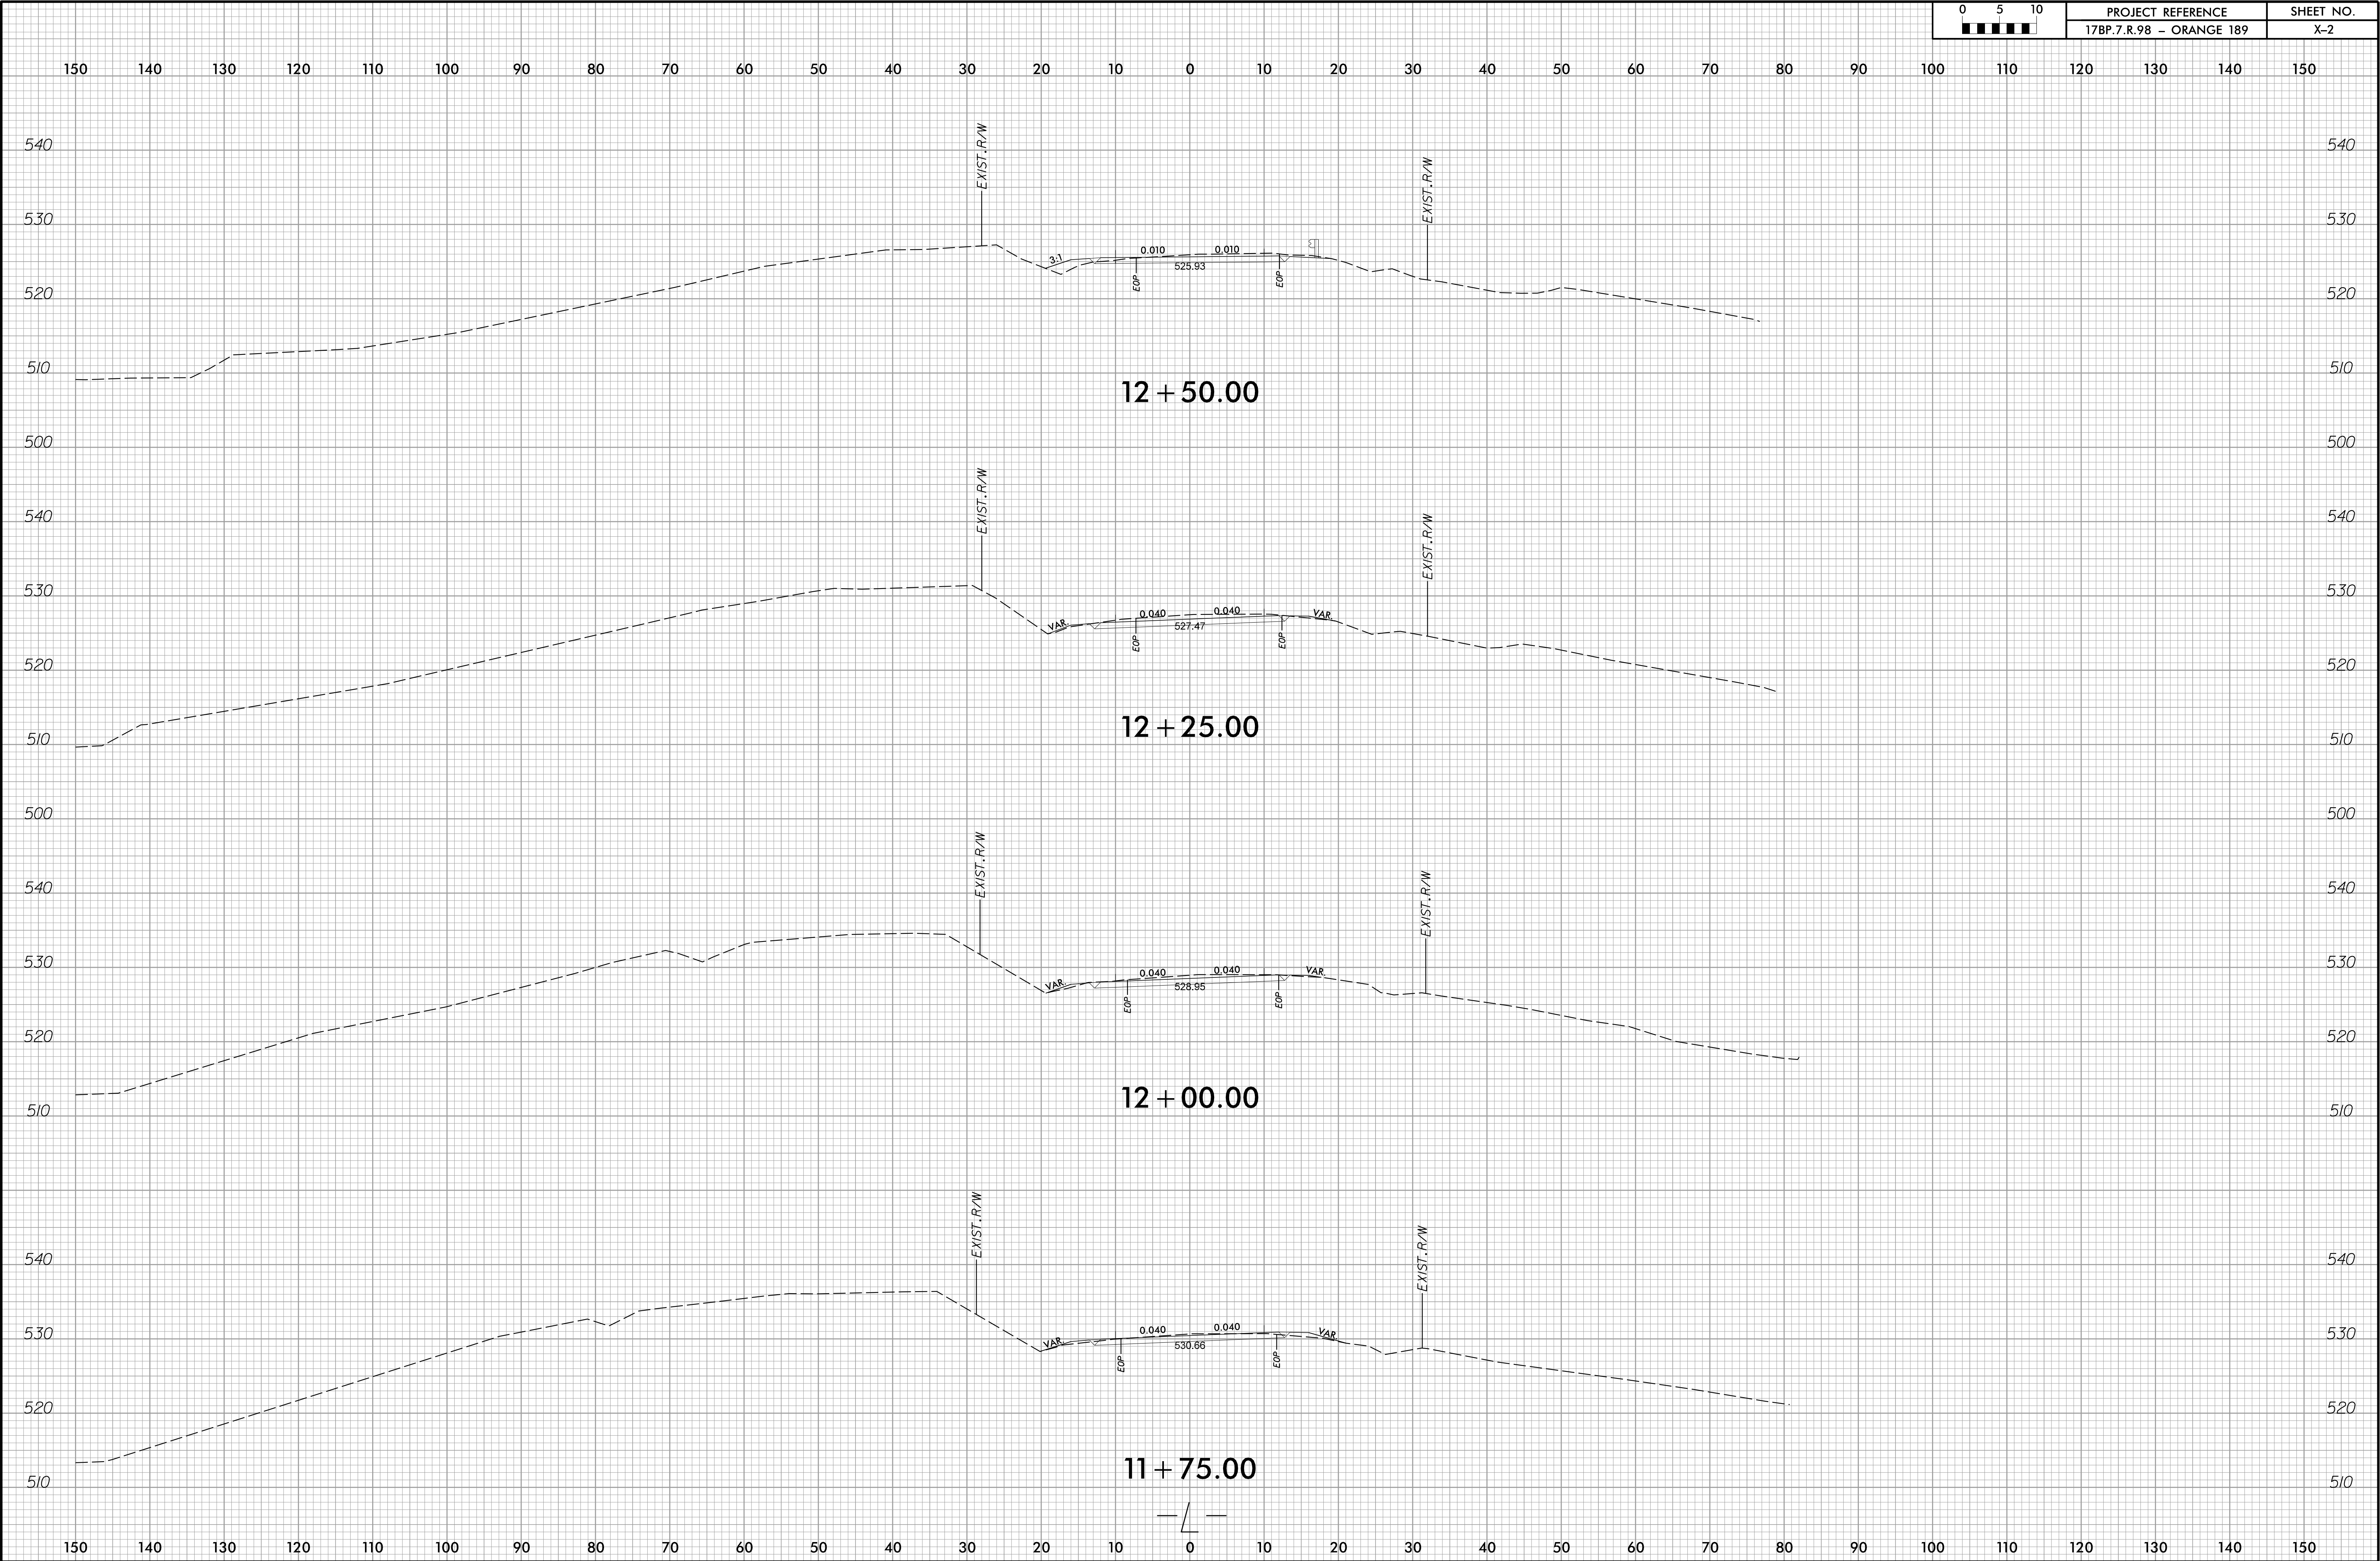


3/28/2017 8:26:35 AM
R:\Corporat\Xsc\Xpl\1670189_Fdy_xpl.dgn
0960103

0510 520 530	05	10	PROJECT REFERENCE	SHEET NO.
	0510 520 530	05	17BP.7.R.98 - ORANGE 189	X-3

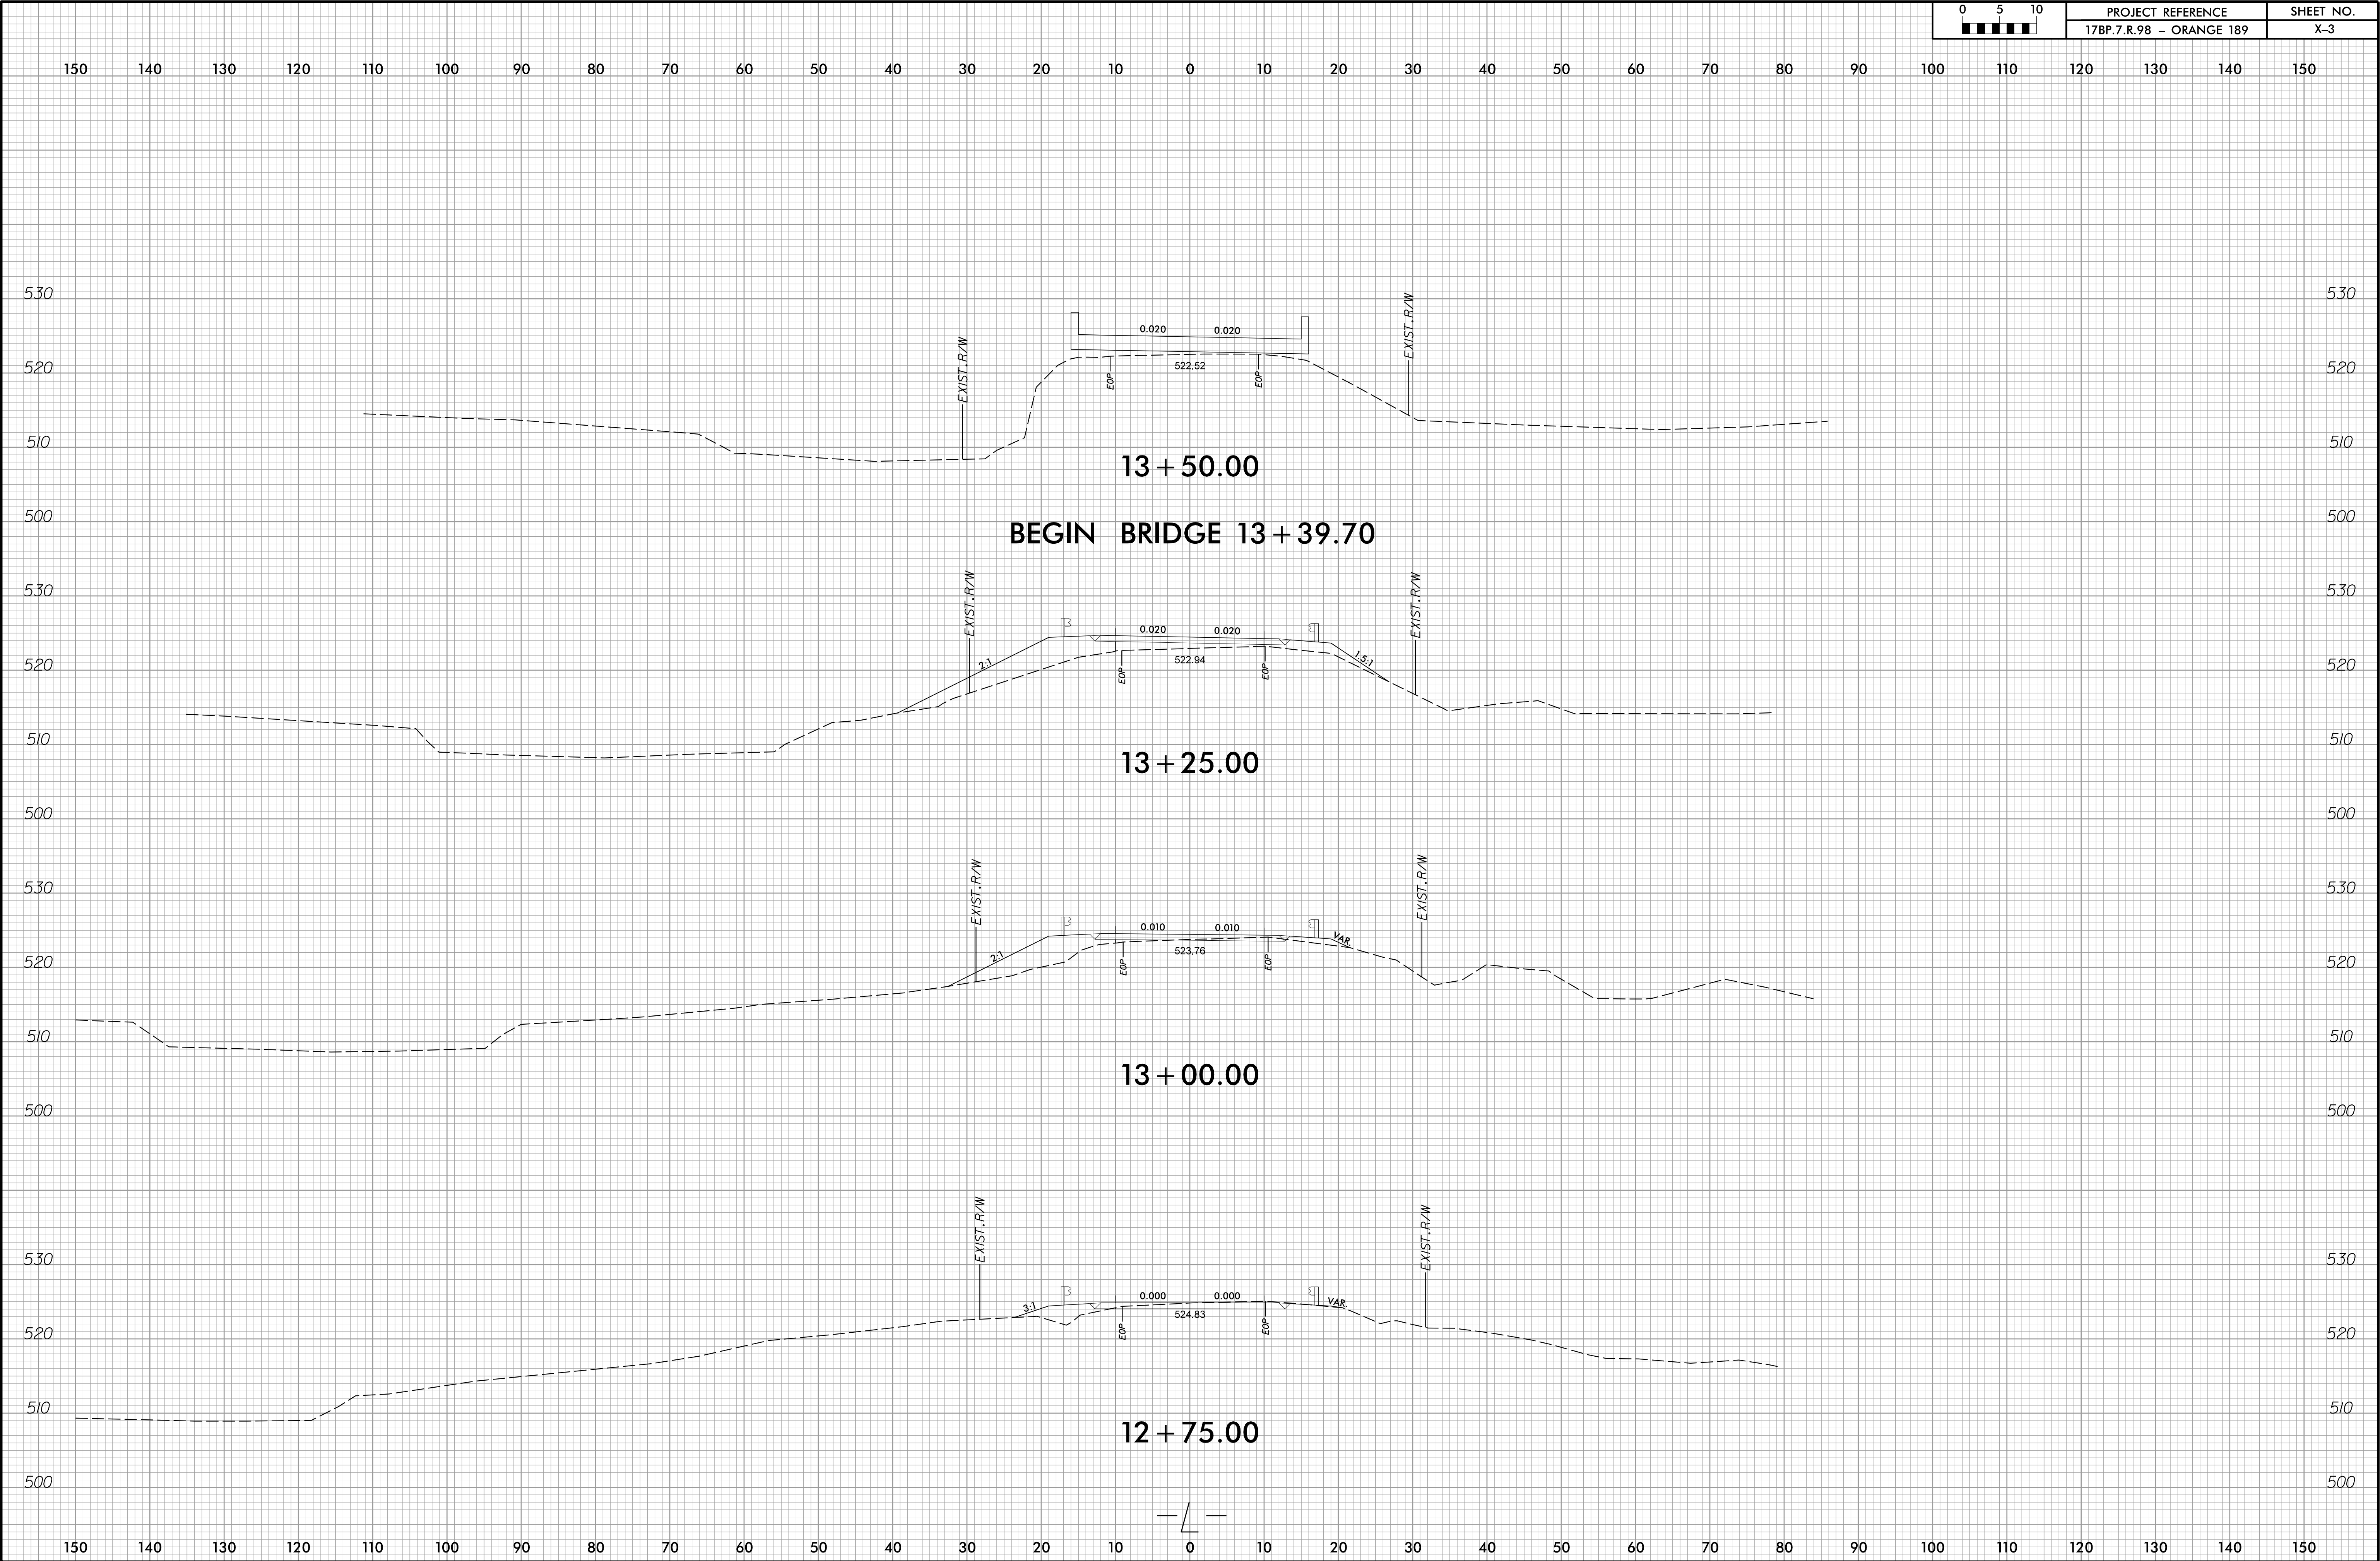


3/28/2017 8:26:36 AM
R:\Corporat\Xsc\Xpl\670189_Fdy_xpl.dgn
0960103

0510 0 5 10 ■■■■■	PROJECT REFERENCE	SHEET NO.
	17BP.7.R.98 - ORANGE 189	X-4

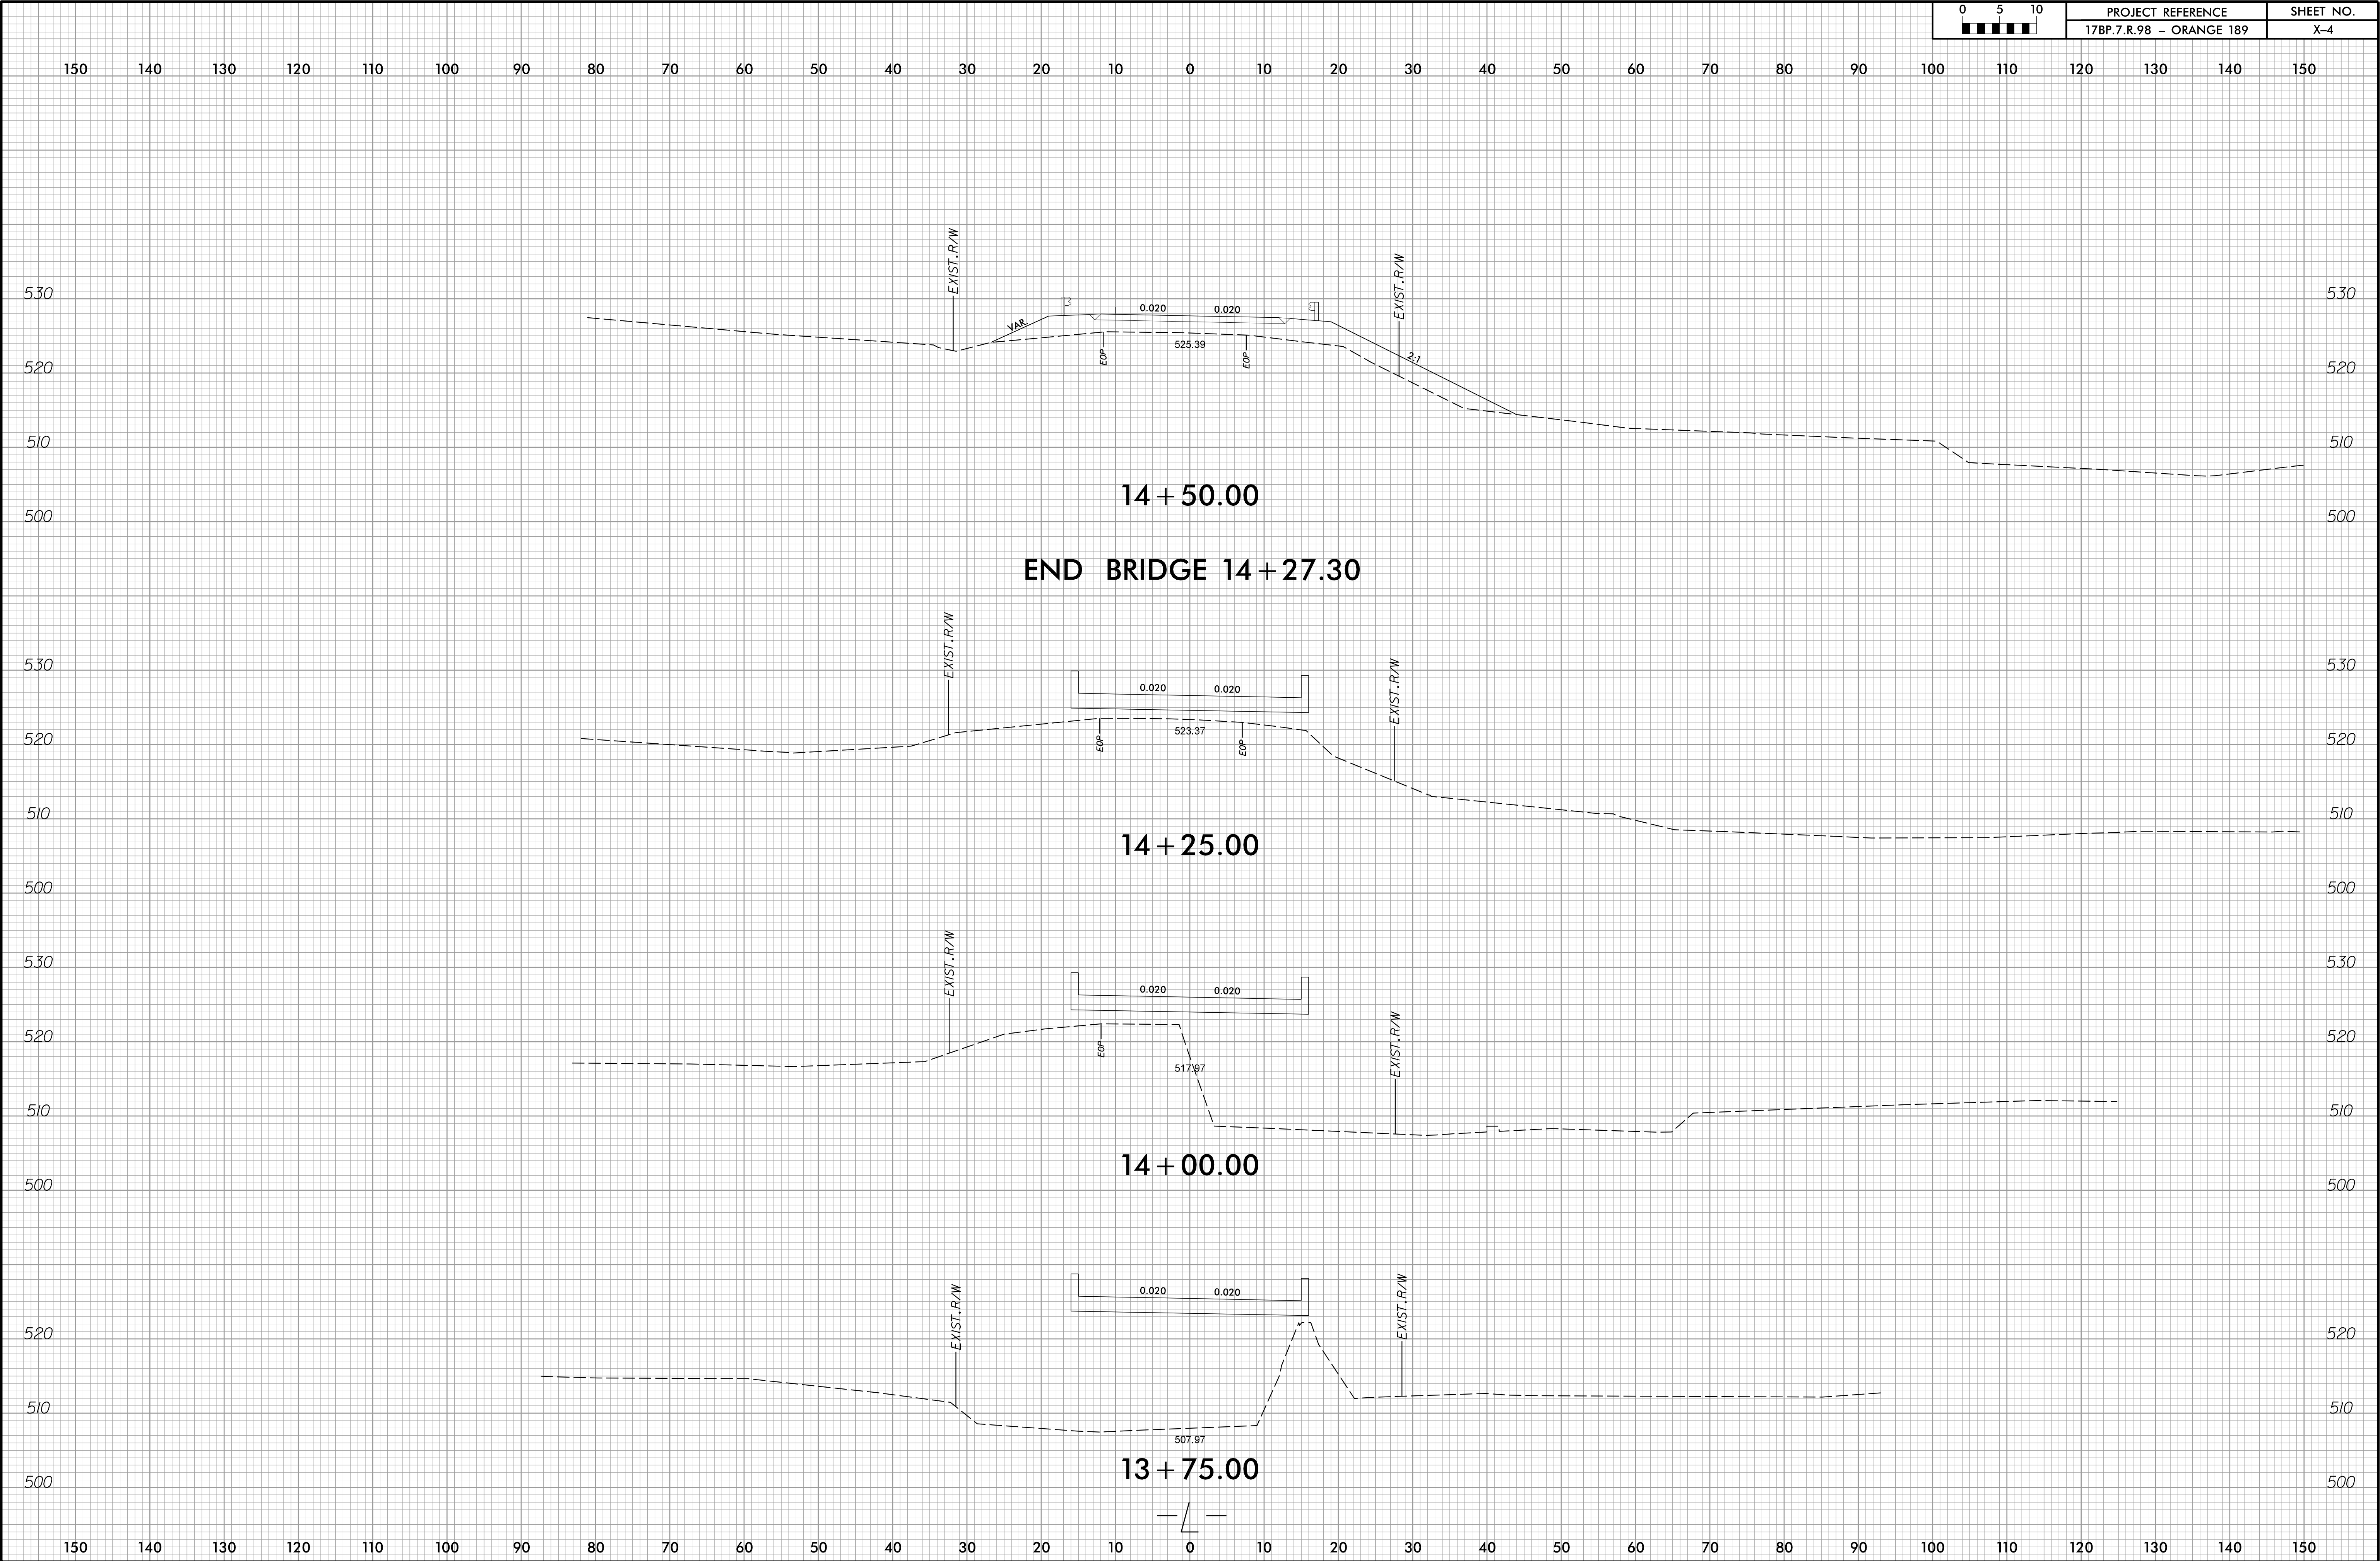


3/28/2017 8:26:36 AM
R:\Corps\ex\Xsc\Xpl\G70189_Fdy_xpl.dgn
0960103


0 5 10 ■■■■■	PROJECT REFERENCE	SHEET NO.
	17BP.7.R.98 - ORANGE 189	X-5

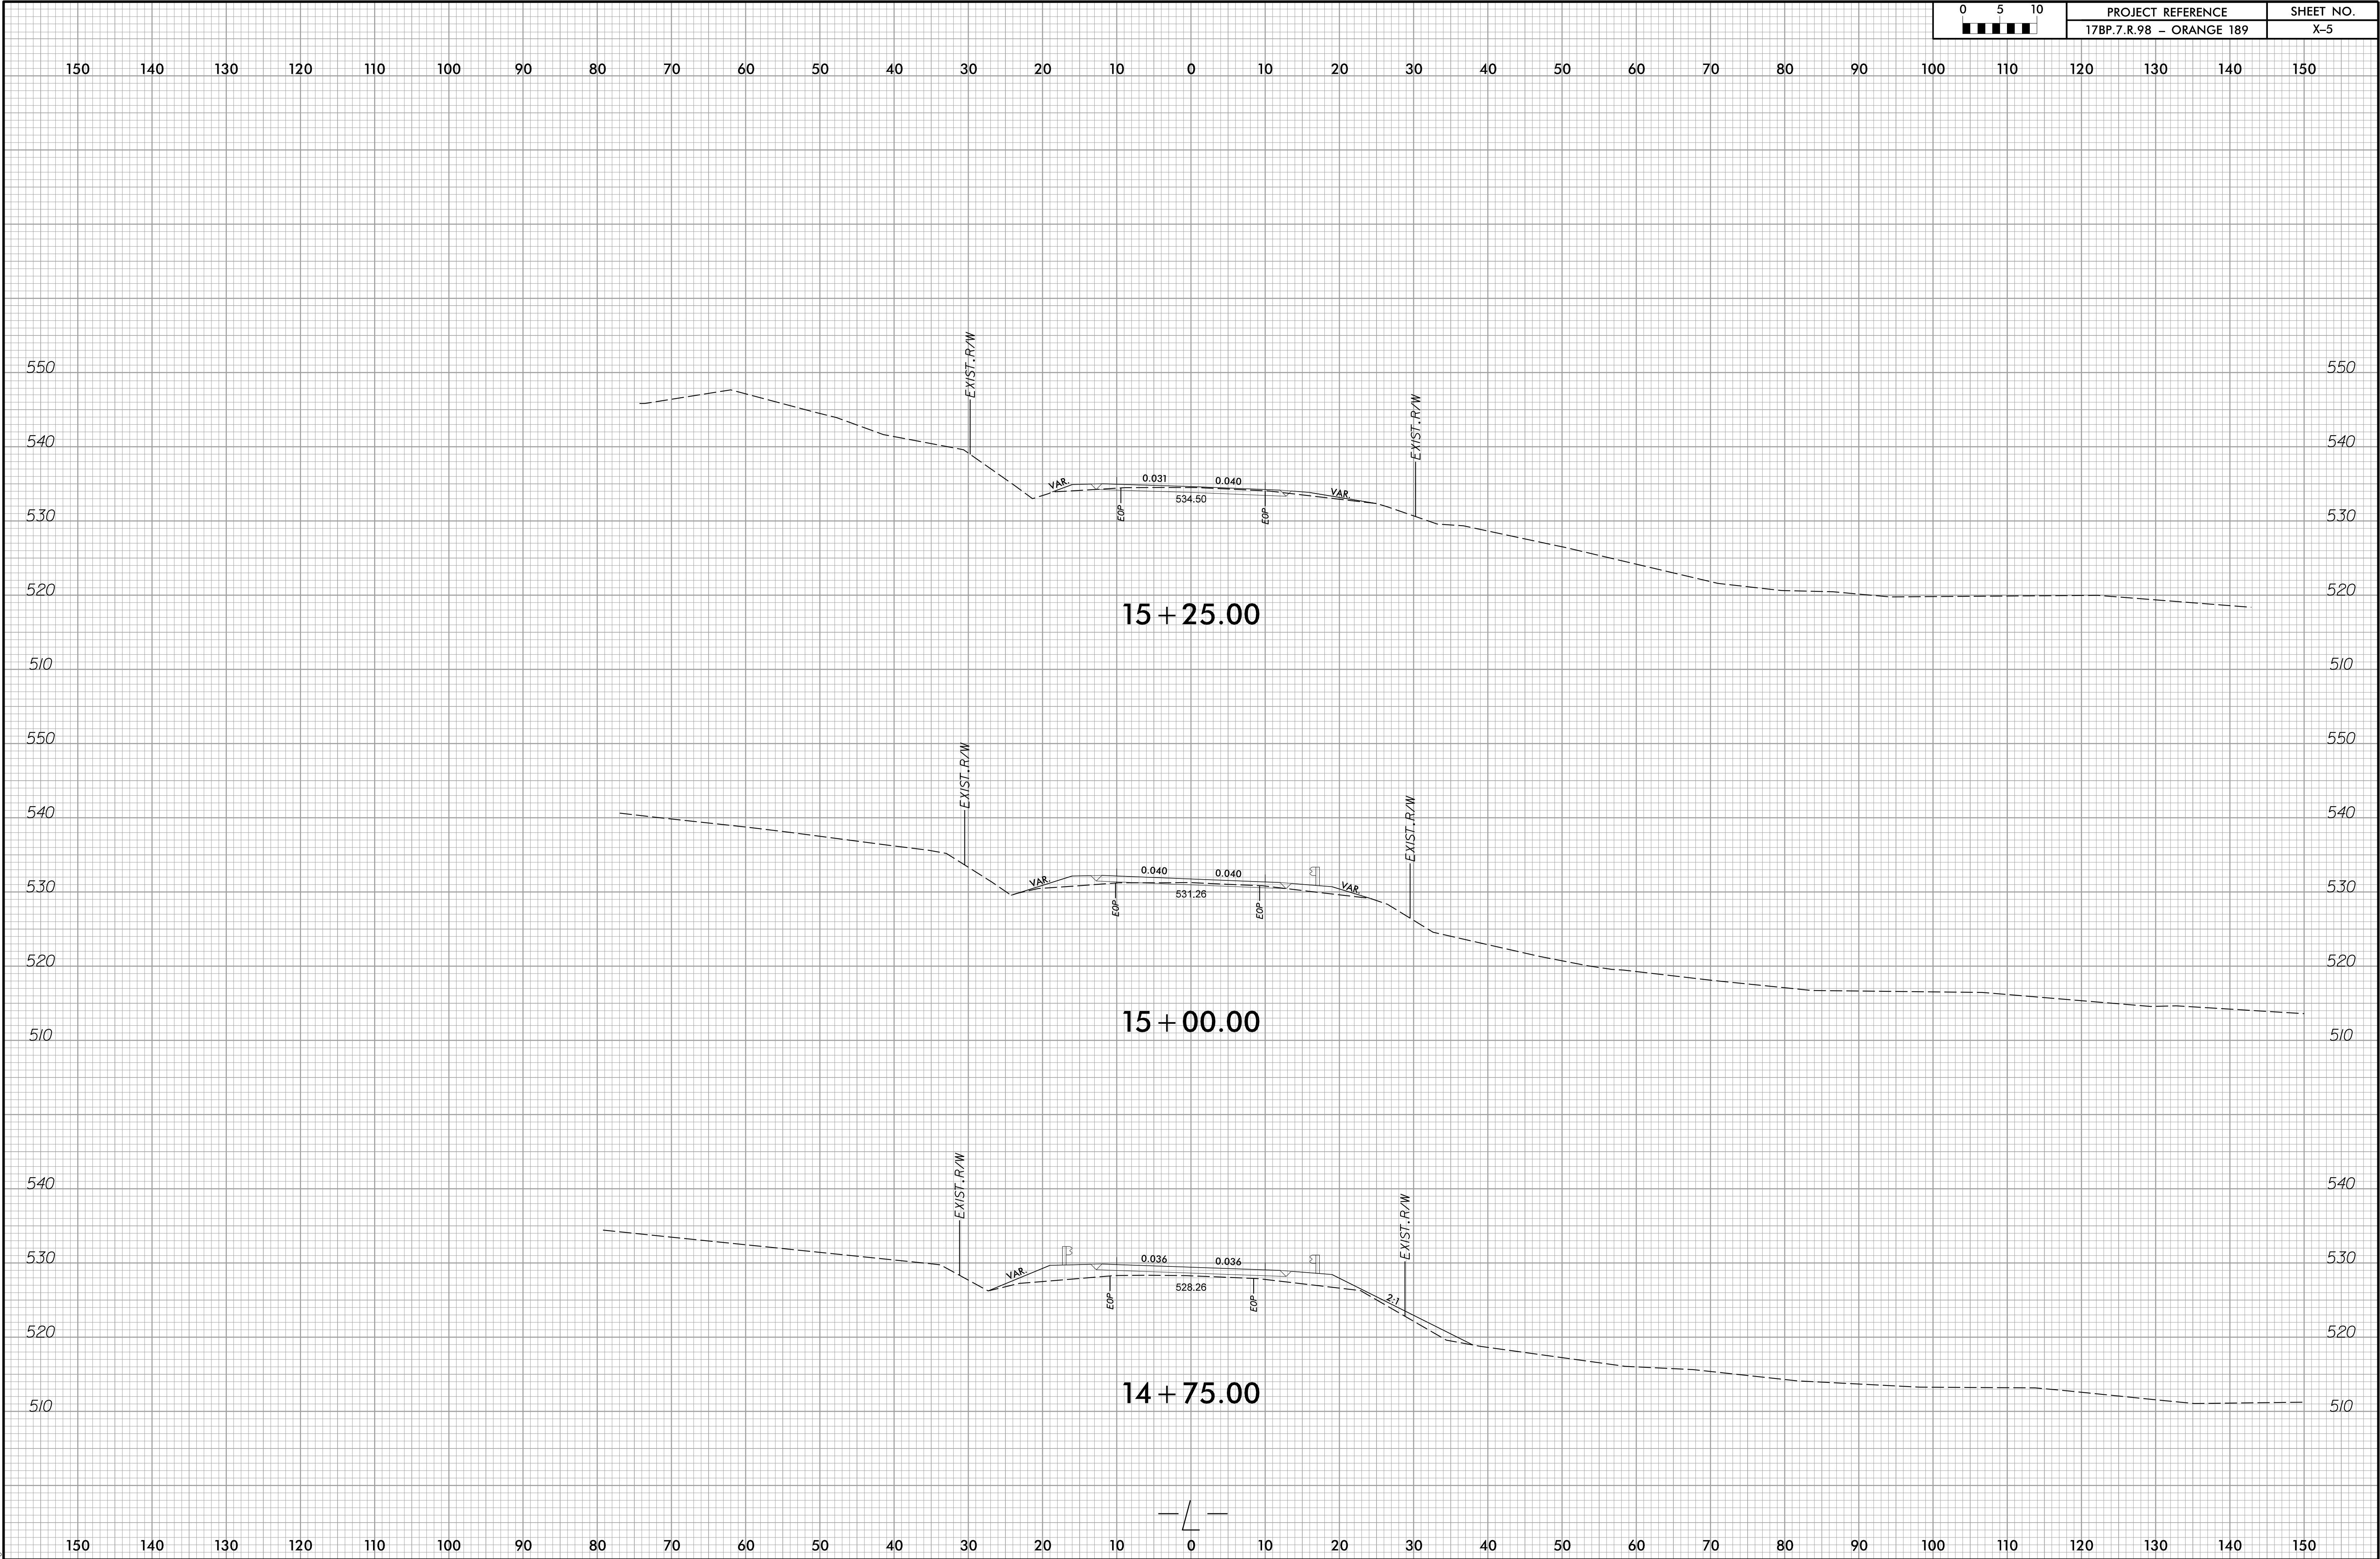

3/28/2017 8:26:36 AM
R:\Corporat\Xsc\Xpl\670189_Fdy_xpl.dgn
0960103

<div><div>0510</div><div><div></div><div></div><div></div><div></div><div></div></div></div>	PROJECT REFERENCE		SHEET NO.
	17BP.7.R.98 - ORANGE 189		X-6

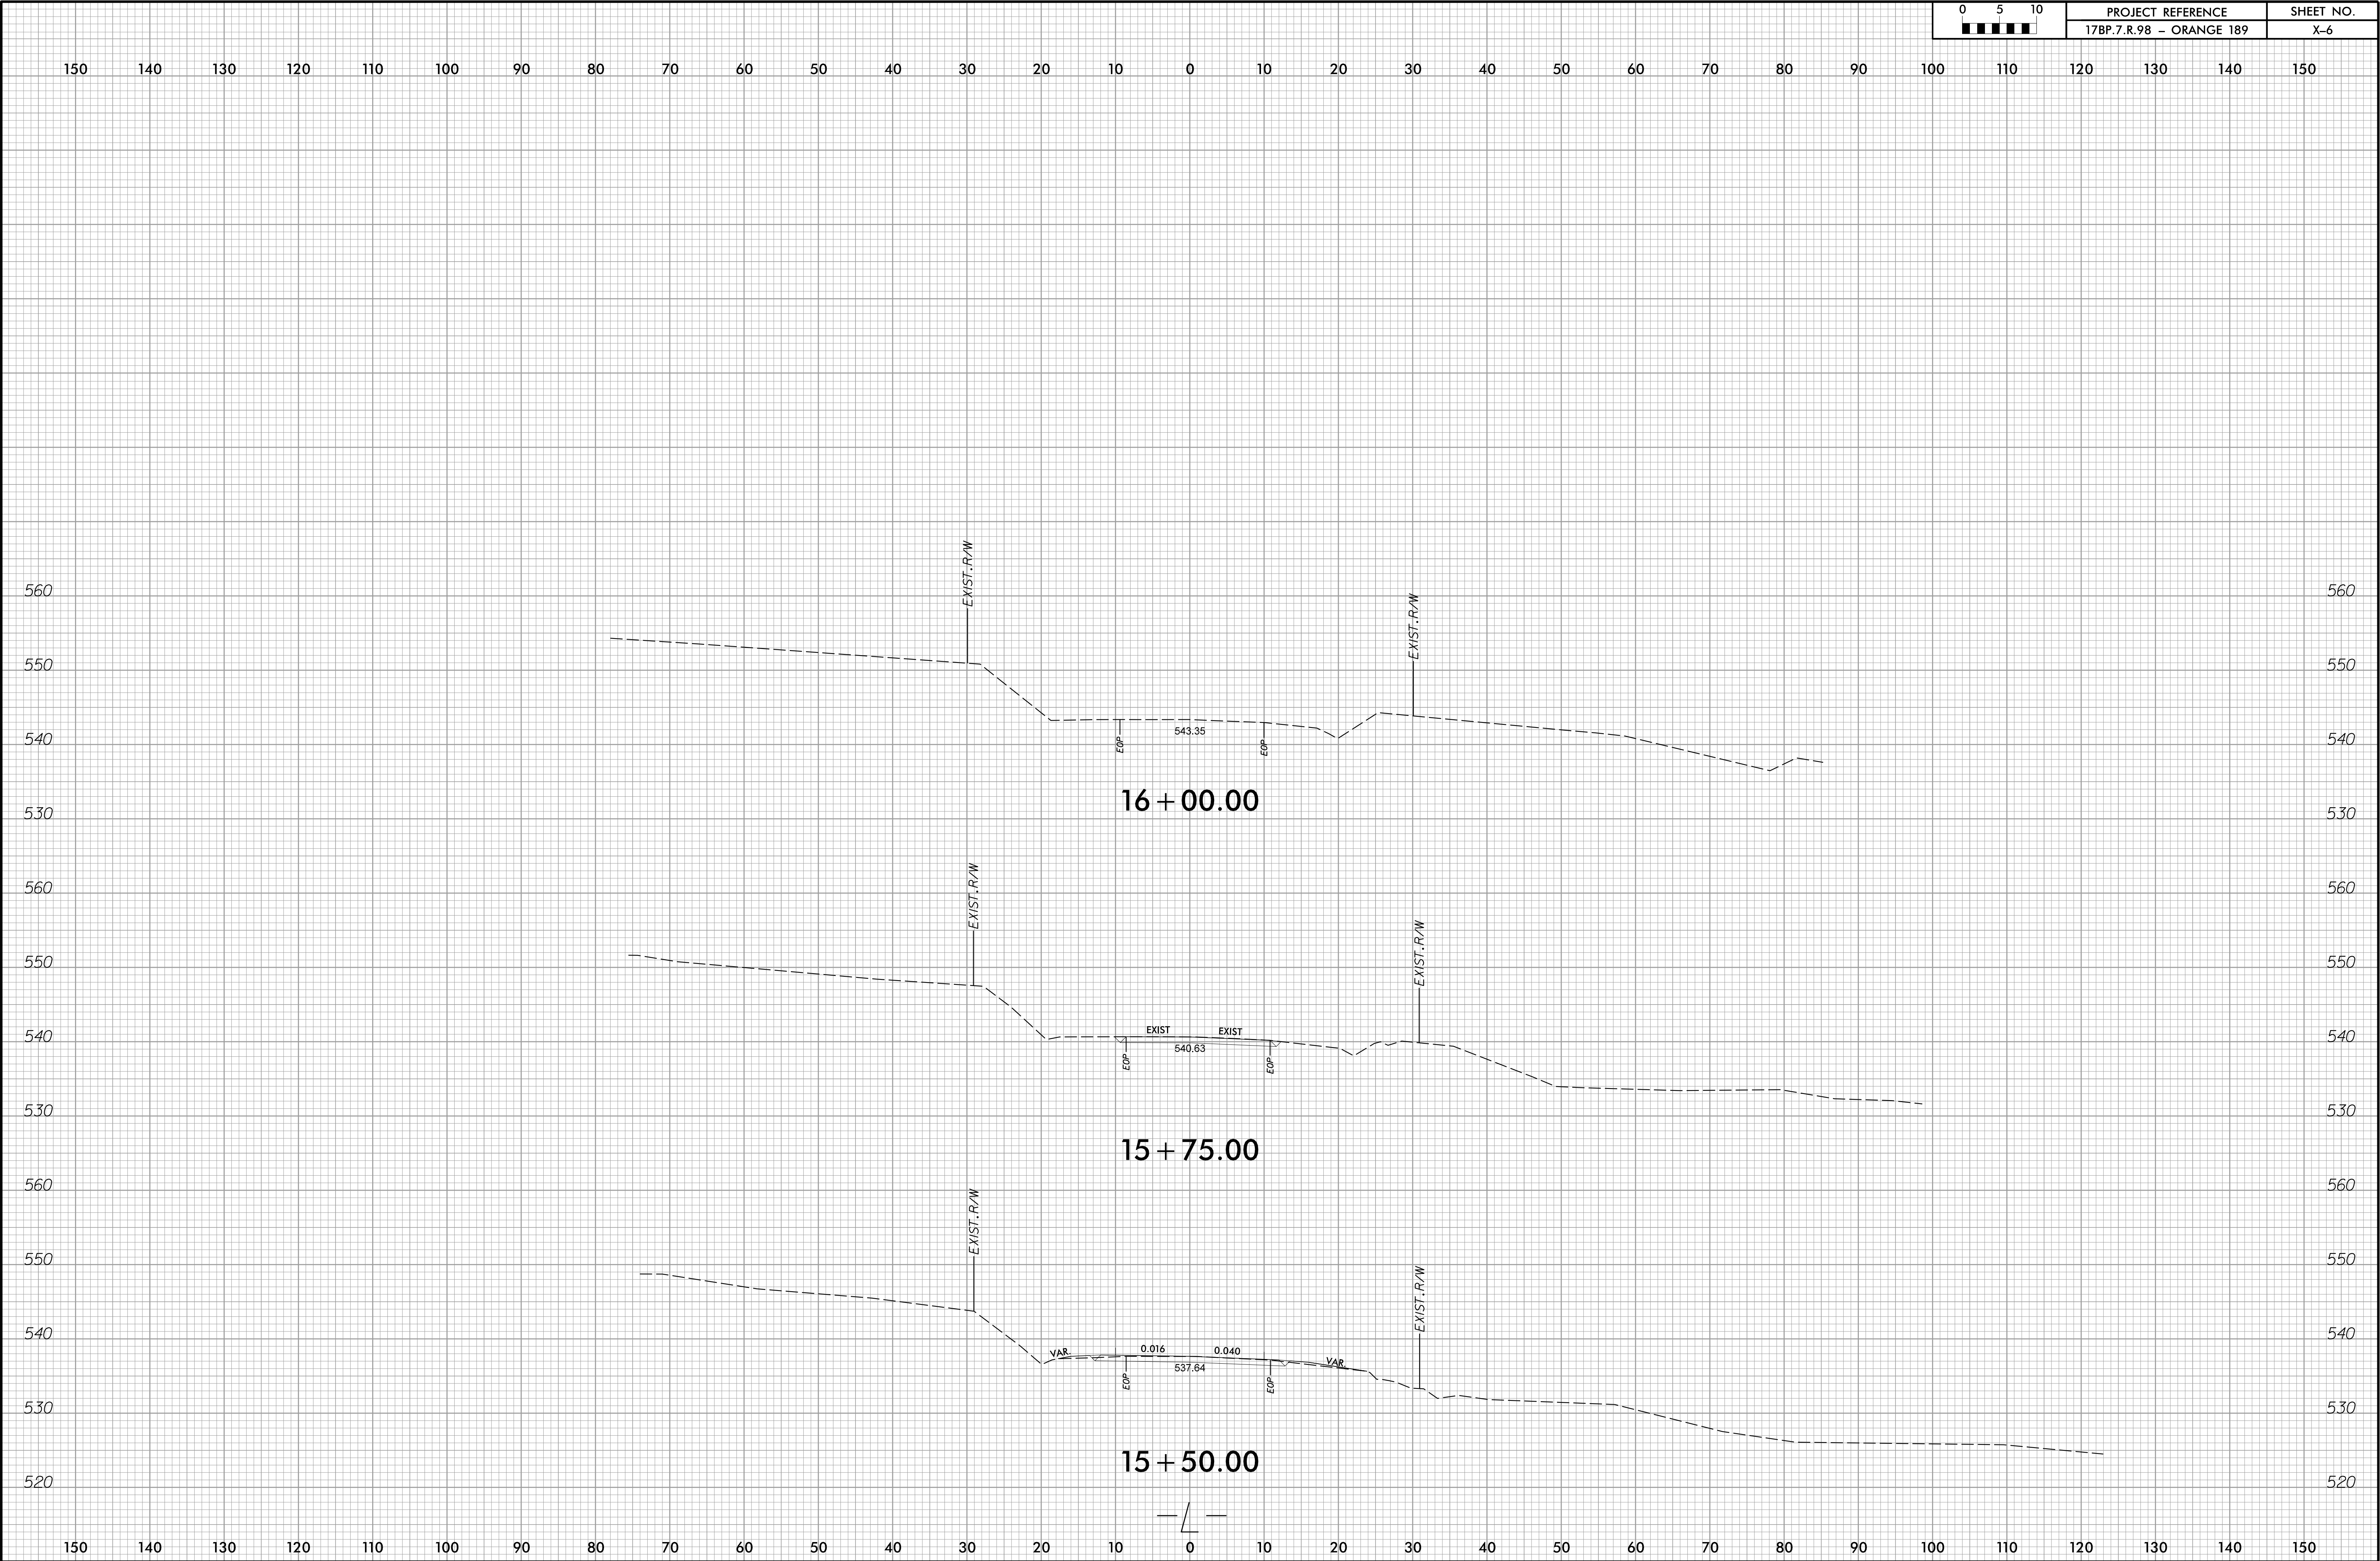

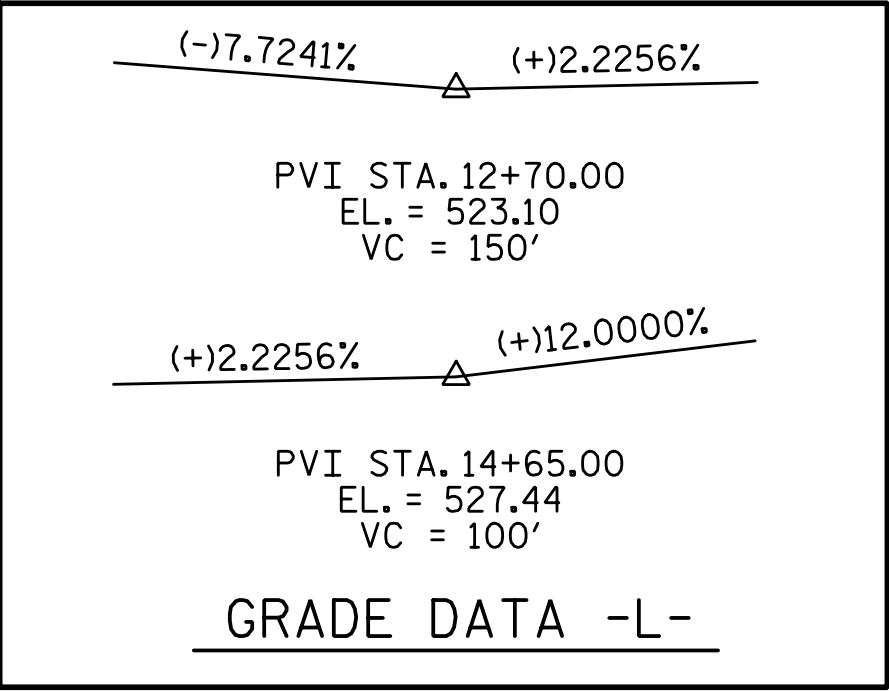


HYDRAULIC DATA:


DESIGN DISCHARGE	= 1800 CFS
FREQUENCY OF DESIGN FLOOD	= 25 YEAR
DESIGN HIGH WATER ELEVATION	= 516.30
DRAINAGE AREA	= 7.6 SQ. MI.
BASE DISCHARGE (Q 100)	= 2810 CFS
BASE HIGH WATER ELEVATION	= 517.74

OVERTOPPING FLOOD DATA:

OVERTOPPING DISCHARGE	= 6800 CFS
FREQUENCY OF OVERTOPPING FLOOD	= 500+ YEAR
OVERTOPPING FLOOD ELEVATION	= 524.50 **
** OVERTOPPING OCCURS AT	
ROADWAY SAG STA. 13+11.00 -L-	
AT ROADWAY SUPER HIGH (LEFT) SIDE	

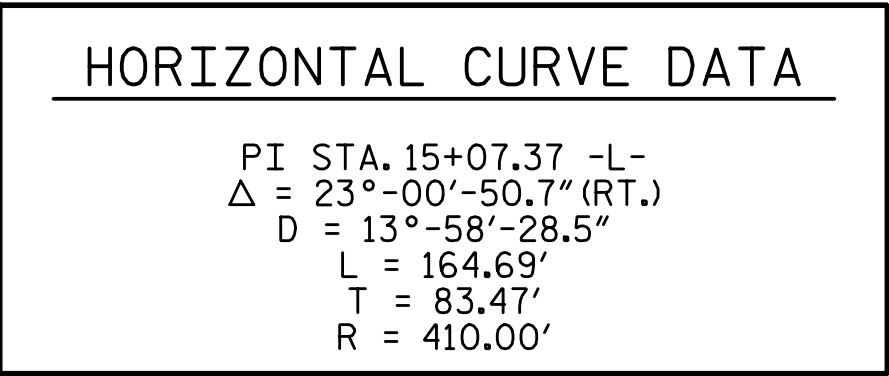

I HEREBY CERTIFY THESE PLANS
ARE THE AS-BUILT PLANS

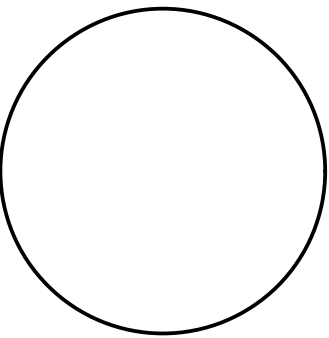

PROJECT NO. 17BP.7.R.98
ORANGE COUNTY
 STATION: 13+83.50 -L-

SHEET 1 OF 2 REPLACES BRIDGE #189

STATE OF NORTH CAROLINA
DEPARTMENT OF TRANSPORTATION
RALEIGH

GENERAL DRAWING

FOR BRIDGE ON SR 1114
(BUCKHORN RD.) OVER

BETWEEN CANE CREEK
SR 1115 AND SR 1006

30'-6" CLEAR ROADWAY - 60° SKEW

REVISIONS						SHEET NO. S-1
NO.	BY:	DATE:	NO.	BY:	DATE:	
1			3			TOTAL SHEETS 19
2			4			



3/29/2017


**DOCUMENT NOT CONSIDERED FINAL
UNLESS ALL SIGNATURES COMPLETED**

PROJ:17BP:7.R.98

DRAWN BY: T. BANKOVICH DATE: 9-16
 CHECKED BY: B.S. COX DATE: 9-16
 DESIGN ENGINEER OF RECORD: B.S. COX DATE: 9-16

PLAN

(PILES NOT SHOWN IN PLAN VIEW)

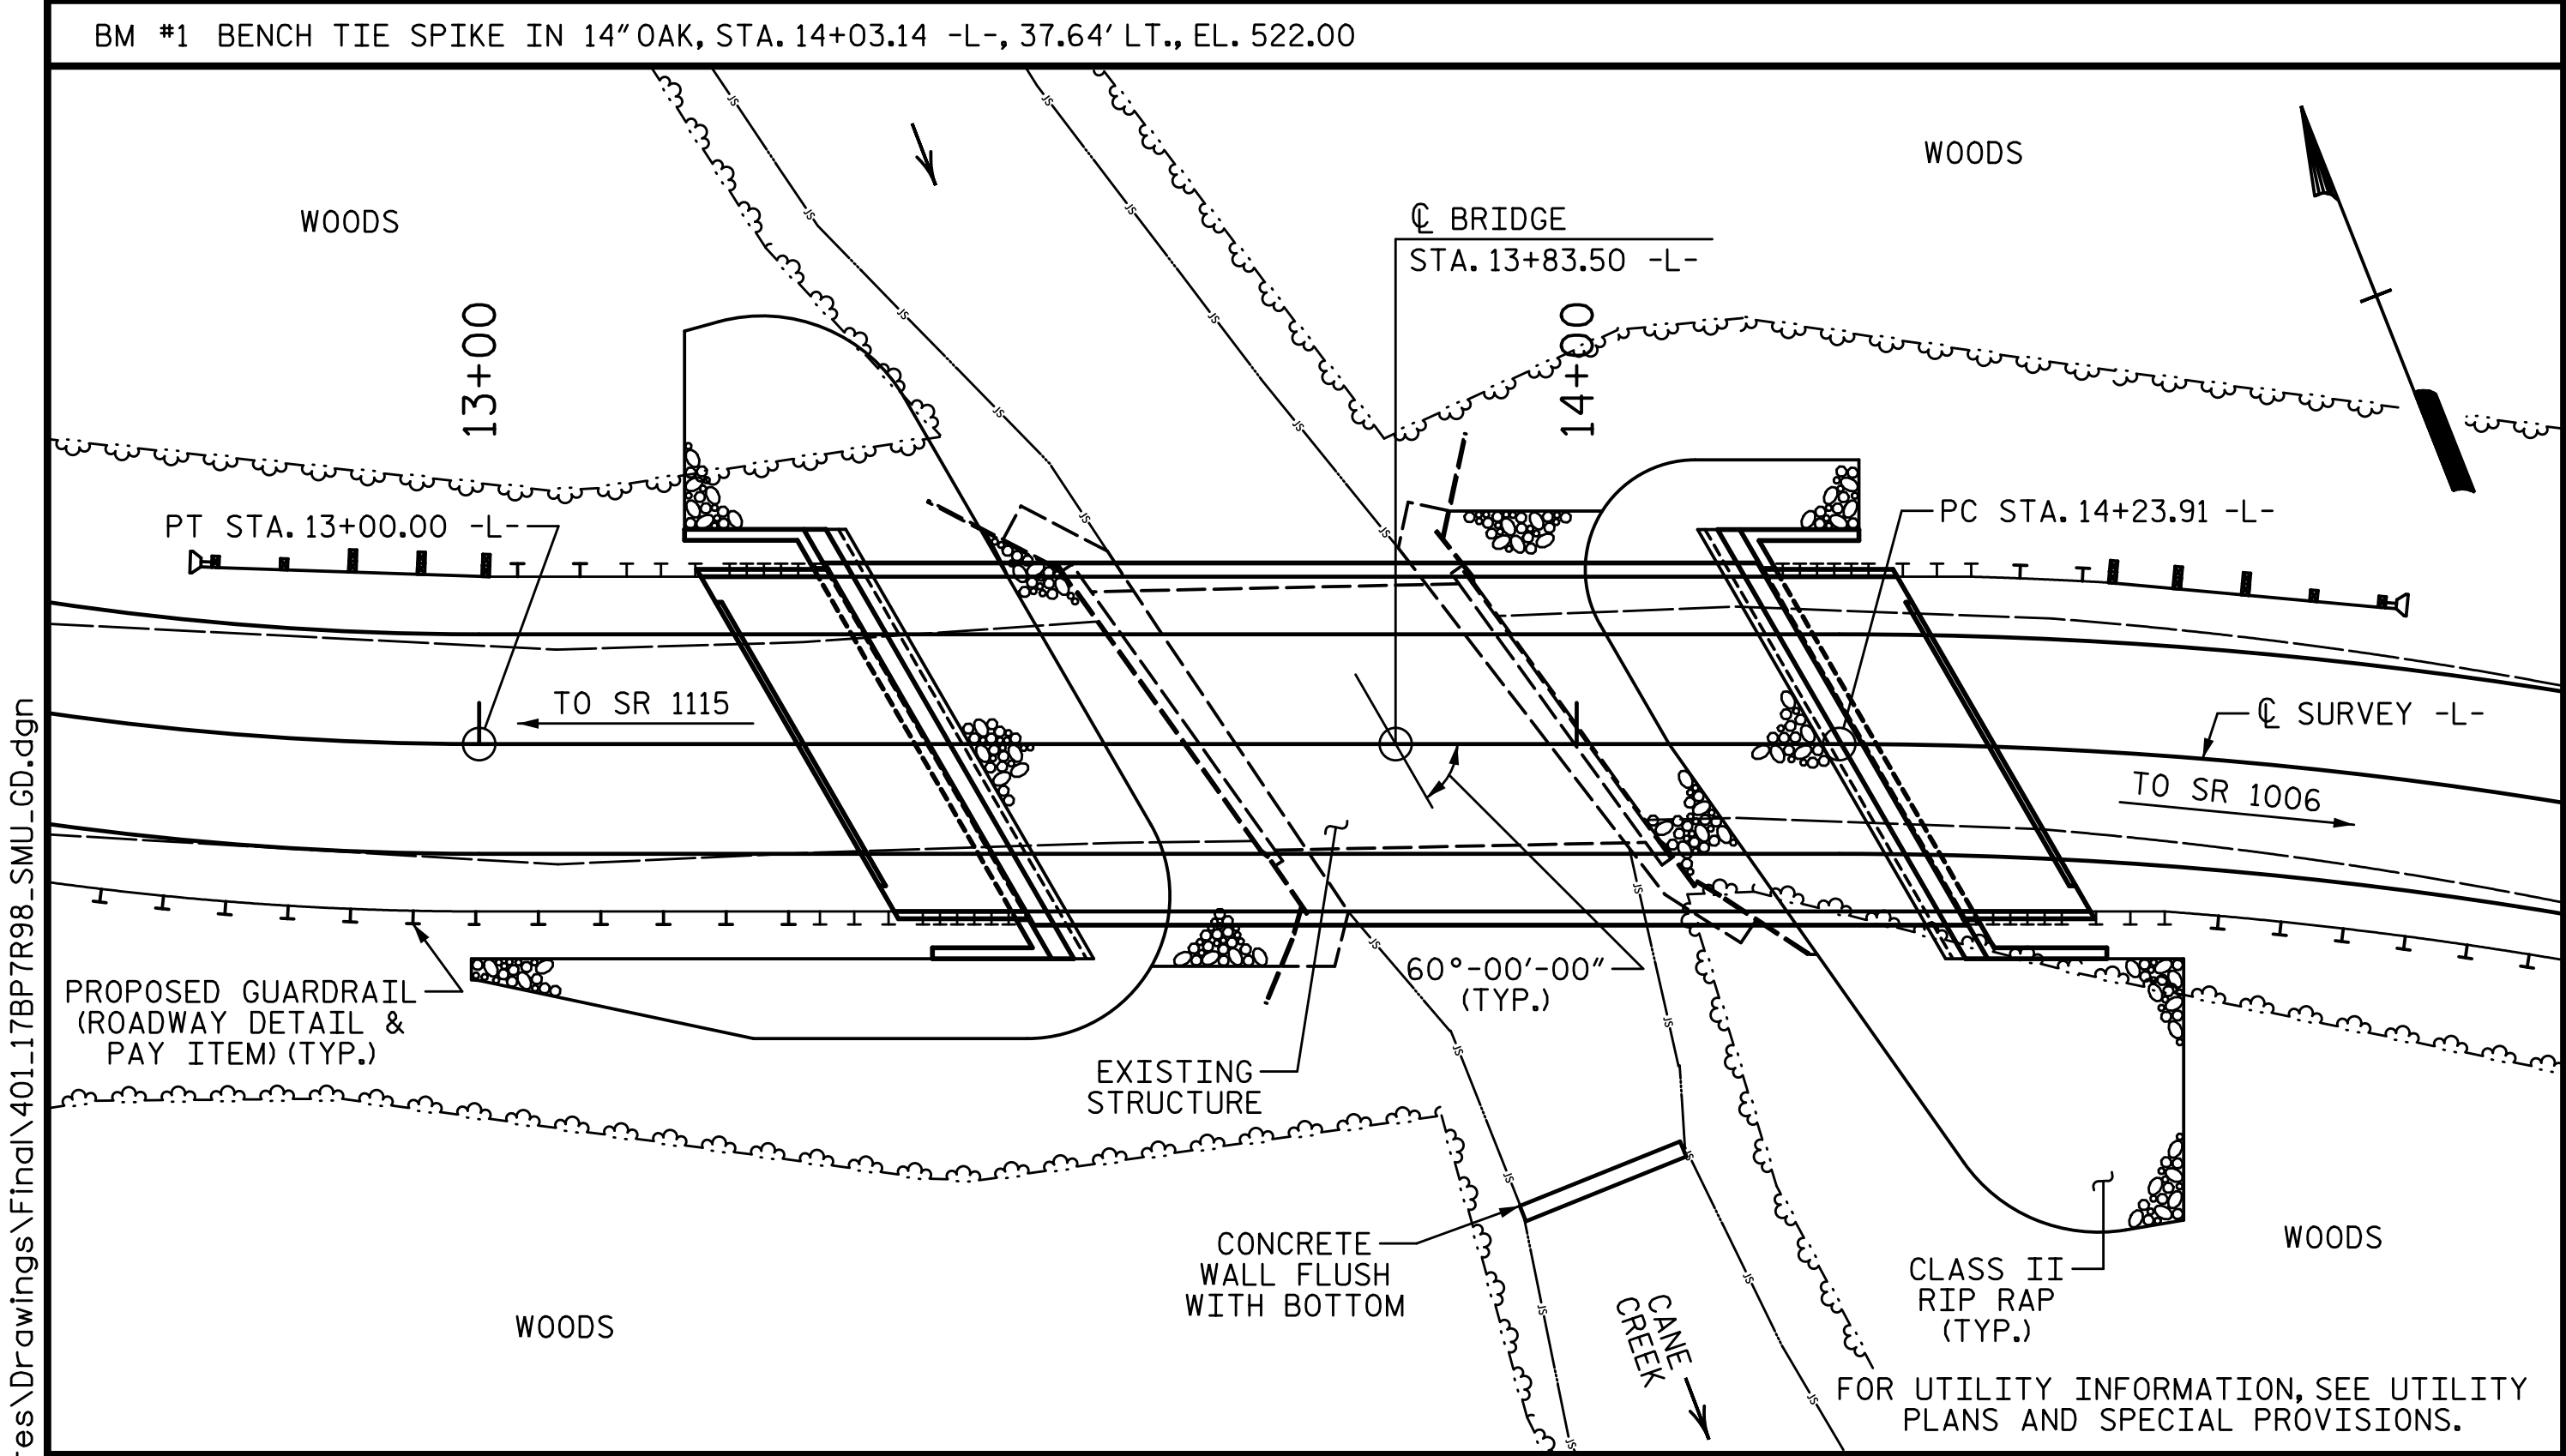

LOCATION SKETCH

NOTES:

ASSUMED LIVE LOAD = HL-93 OR ALTERNATE LOADING.

THIS BRIDGE HAS BEEN DESIGNED IN ACCORDANCE WITH THE AASHTO LRFD BRIDGE DESIGN SPECIFICATIONS.

THIS BRIDGE IS LOCATED IN SEISMIC ZONE 1.

FOR OTHER DESIGN DATA AND GENERAL NOTES, SEE SHEET SN.

FOR EROSION CONTROL MEASURES, SEE EROSION CONTROL PLANS.

REMOVAL OF THE EXISTING BRIDGE SHALL BE PERFORMED SO AS NOT TO ALLOW DEBRIS TO FALL INTO THE WATER. THE CONTRACTOR SHALL REMOVE THE BRIDGE AND SUBMIT PLANS FOR DEMOLITION IN ACCORDANCE WITH ARTICLE 402-2 OF THE STANDARD SPECIFICATIONS.

THE MATERIAL SHOWN IN THE CROSS-HATCHED AREA SHALL BE EXCAVATED FOR A DISTANCE OF 25 FT. LT. AND RT. OF CENTERLINE ROADWAY AS DIRECTED BY THE ENGINEER. THIS WORK WILL BE PAID FOR AT THE CONTRACT LUMP SUM PRICE FOR UNCLASSIFIED STRUCTURE EXCAVATION. SEE SECTION 412 OF THE STANDARD SPECIFICATIONS.

THE EXISTING STRUCTURE CONSISTS OF 1 SPAN @ 37'-0". THE SUPERSTRUCTURE HAS A CLEAR ROADWAY WIDTH OF 23.0' AND HAS A TIMBER DECK ON STEEL I-BEAMS. THE END BENTS CONSIST OF STEEL CAPS WITH TIMBER SUBCAPS ON CONCRETE ENCASED TIMBER PILES WITH TIMBER BULKHEADS. THE EXISTING STRUCTURE, WHICH IS LOCATED AT THE SITE OF THE PROPOSED STRUCTURE, SHALL BE REMOVED EXCEPT AS NOTED. THE EXISTING BRIDGE IS PRESENTLY NOT POSTED FOR LOAD LIMIT. SHOULD THE STRUCTURAL INTEGRITY OF THE BRIDGE DETERIORATE DURING CONSTRUCTION OF THE PROPOSED BRIDGE, THE LOAD LIMIT MAY BE REDUCED AS NECESSARY DURING THE LIFE OF THE PROJECT.

RETAIN EXISTING CONCRETE SILLS.

THE SUBSTRUCTURE OF THE EXISTING BRIDGE INDICATED ON THE PLANS IS FROM THE BEST INFORMATION AVAILABLE. SINCE THIS INFORMATION IS SHOWN FOR THE CONVENIENCE OF THE CONTRACTOR. THE CONTRACTOR SHALL HAVE NO CLAIM WHATSOEVER AGAINST THE DEPARTMENT OF TRANSPORTATION FOR ANY DELAYS OR ADDITIONAL COST INCURRED BASED ON DIFFERENCES BETWEEN THE EXISTING BRIDGE SUBSTRUCTURE SHOWN ON THE PLANS AND THE ACTUAL CONDITIONS AT THE PROJECT SITE.

THIS STRUCTURE HAS BEEN DESIGNED IN ACCORDANCE WITH "HEC 18-EVALUATING SCOUR AT BRIDGES."

FOR SUBMITTAL OF WORKING DRAWINGS, SEE SPECIAL PROVISIONS.

FOR FALSEWORK AND FORMWORK, SEE SPECIAL PROVISIONS.

FOR CRANE SAFETY, SEE SPECIAL PROVISIONS.

FOR GROUT FOR STRUCTURES, SEE SPECIAL PROVISIONS.

ASPHALT WEARING SURFACE IS INCLUDED IN ROADWAY QUANTITY ON ROADWAY PLANS.

INASMUCH AS THE PAINT SYSTEM ON THE EXISTING STRUCTURAL STEEL CONTAINS LEAD, THE CONTRACTOR'S ATTENTION IS DIRECTED TO ARTICLE 107-1 OF THE STANDARD SPECIFICATIONS. ANY COSTS RESULTING FROM COMPLIANCE WITH APPLICABLE STATE OR FEDERAL REGULATIONS PERTAINING TO HANDLING OF MATERIALS CONTAINING LEAD BASED PAINT SHALL BE INCLUDED IN THE BID PRICE FOR "REMOVAL OF EXISTING STRUCTURE AT STATION 13+83.50 -L-."

FOR ASBESTOS ASSESSMENT FOR BRIDGE DEMOLITION AND RENOVATION ACTIVITIES, SEE SPECIAL PROVISIONS.

TOTAL BILL OF MATERIAL

	REMOVAL OF EXISTING STRUCTURE	UNCLASSIFIED STRUCTURE EXCAVATION	CLASS A CONCRETE	BRIDGE APPROACH SLABS	REINFORCING STEEL	HP 12 X 53 STEEL PILES		STEEL PILE POINTS	TWO BAR METAL RAIL	1'-2" X 2'-11 1/4" CONCRETE PARAPET	RIP RAP CLASS II (2'-0" THICK)	GEOTEXTILE FOR DRAINAGE	ELASTOMERIC BEARINGS	3'-0" X 2'-9" PRESTRESSED CONCRETE BOX BEAMS	ASBESTOS ASSESSMENT
	LS	LS	CY	LS	LB	NO.	LF	EA	LF	LF	TON	SY	LS	NO.	LF
SUPERSTRUCTURE				LS					153.66	170.00			LS	11	935.00
END BENT 1		LS	28.5		3,934	7	125	7			315	350			
END BENT 2		LS	28.5		3,934	7	125	7			310	345			
TOTAL	LS	LS	57.0	LS	7,868	14	250	14	153.66	170.00	625	695	LS	11	935.00

FOUNDATION NOTES:

FOR PILES, SEE SECTION 450 OF THE STANDARD SPECIFICATIONS.

PILES AT END BENT 1 ARE DESIGNED FOR A FACTORED RESISTANCE OF 100 TONS PER PILE.


DRIVE PILES AT END BENT 1 TO A REQUIRED DRIVING RESISTANCE OF 170 TONS PER PILE.

STEEL H-PILE POINTS ARE REQUIRED FOR STEEL H-PILES AT END BENT 1. FOR THE STEEL PILE POINTS, SEE SECTION 450 OF THE STANDARD SPECIFICATIONS.

PILES AT END BENT 2 ARE DESIGNED FOR A FACTORED RESISTANCE OF 100 TONS PER PILE.

DRIVE PILES AT END BENT 2 TO A REQUIRED DRIVING RESISTANCE OF 170 TONS PER PILE.

STEEL H-PILE POINTS ARE REQUIRED FOR STEEL H-PILES AT END BENT 2. FOR THE STEEL PILE POINTS, SEE SECTION 450 OF THE STANDARD SPECIFICATIONS.

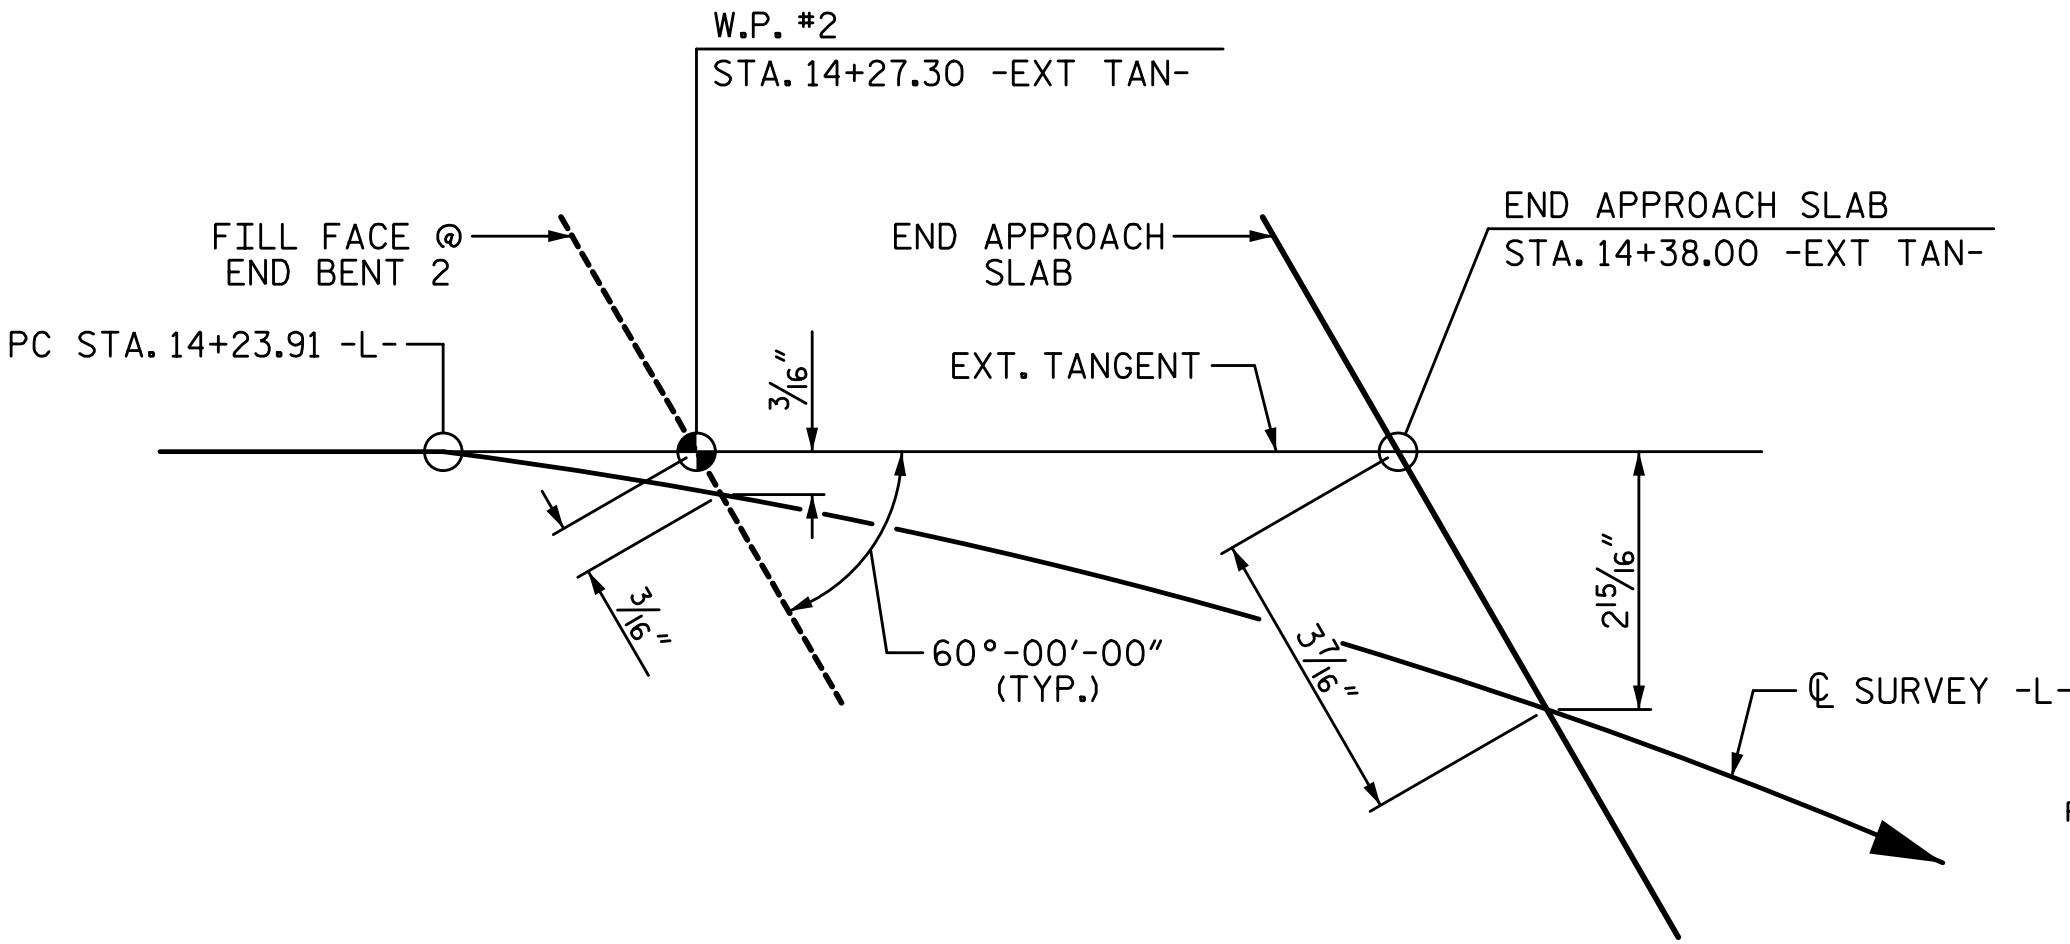

EXTENDED TANGENT LAYOUT

NOTE: THE EFFECTS OF THE HORIZONTAL CURVE SHALL BE NEGLECTED IN THE CONSTRUCTION OF THIS BRIDGE. THIS BRIDGE IS TO BE BUILT ALONG -L- AND THE EXTENDED TANGENT BETWEEN THE WORK POINTS AT THE FILL FACES. THE APPROACH SLAB AT END BENT 2 IS TO BE CONSTRUCTED ALONG THE EXTENDED TANGENT.

PLANS PREPARED BY:

SEA & A
SIMPSON ENGINEERS & ASSOCIATES
5640 Dillard Drive
Suite 200
Cary, NC 27518
(919) 852-0468
(919) 852-0598 (Fax)
www.simpsonengr.com
LICENSURE NO. C-2521



PROJECT NO. 17BP.7.R.98
ORANGE COUNTY
STATION: 13+83.50 -L-

SHEET 2 OF 2

STATE OF NORTH CAROLINA
DEPARTMENT OF TRANSPORTATION
RALEIGH

GENERAL DRAWING

FOR BRIDGE ON SR 1114
(BUCKHORN RD.) OVER
CANE CREEK
BETWEEN SR 1115 AND SR 1006
30'-6" CLEAR ROADWAY - 60° SKEW


REVISIONS

NO.	BY:	DATE:	NO.	BY:	DATE:	SHEET NO.
1			3			S-2
2			4			TOTAL SHEETS 19

DOCUMENT NOT CONSIDERED FINAL
UNLESS ALL SIGNATURES COMPLETED

3/29/2017 7:54:51 AM G:\Projects\2015\Division 7 (Hatch Mot+)\17BP7R98 (Orange 189) (60 33BB 2BMR)\Structures\Drawings\Final\401.17BP7R98_SMJ_LRFR.dgn

LOAD AND RESISTANCE FACTOR RATING (LRFD) SUMMARY FOR PRESTRESSED CONCRETE GIRDERS																								
LEVEL		VEHICLE	WEIGHT (W) (TONS)	CONTROLLING LOAD RATING	MINIMUM RATING FACTORS (RF)	TONS = W X RF	STRENGTH I LIMIT STATE										SERVICE III LIMIT STATE						COMMENT NUMBER	
							LIVELOAD FACTORS	MOMENT					SHEAR					LIVELOAD FACTORS	MOMENT					
								DISTRIBUTION FACTORS (DF)	RATING FACTOR	SPAN	GIRDER LOCATION	DISTANCE FROM LEFT END OF SPAN (ft)	DISTRIBUTION FACTORS (DF)	RATING FACTOR	SPAN	GIRDER LOCATION	DISTANCE FROM LEFT END OF SPAN (ft)		DISTRIBUTION FACTORS (DF)	RATING FACTOR	SPAN	GIRDER LOCATION		DISTANCE FROM LEFT END OF SPAN (ft)
DESIGN LOAD RATING		HL-93(Inv)	N/A	1	1.117	--	1.75	0.247	1.93	A	EL	41.634	0.625	1.12	A	EL	8.327	0.80	0.247	1.56	A	EL	41.634	
		HL-93(0pr)	N/A	--	1.448	--	1.35	0.247	2.5	A	EL	41.634	0.625	1.45	A	EL	8.327	N/A	--	--	--	--	--	
		HS-20(Inv)	36.000	2	1.448	52.14	1.75	0.247	2.59	A	EL	41.634	0.625	1.45	A	EL	8.327	0.80	0.247	2.09	A	EL	41.634	
		HS-20(0pr)	36.000	--	1.877	67.589	1.35	0.247	3.35	A	EL	41.634	0.625	1.88	A	EL	8.327	N/A	--	--	--	--	--	
LEGAL LOAD RATING	SV	SNSH	13.500	--	4.378	59.102	1.4	0.247	7.48	A	EL	41.634	0.625	4.38	A	EL	8.327	0.80	0.247	4.84	A	EL	41.634	
		SNGARBS2	20.000	--	3.091	61.822	1.4	0.247	5.5	A	EL	41.634	0.625	3.09	A	EL	8.327	0.80	0.247	3.56	A	EL	41.634	
		SNAGRIS2	22.000	--	2.861	62.937	1.4	0.247	5.17	A	EL	41.634	0.625	2.86	A	EL	8.327	0.80	0.247	3.35	A	EL	41.634	
		SNCOTTS3	27.250	--	2.183	59.498	1.4	0.247	3.72	A	EL	41.634	0.625	2.18	A	EL	8.327	0.80	0.247	2.41	A	EL	41.634	
		SNAGGRS4	34.925	--	1.797	62.749	1.4	0.247	3.08	A	EL	41.634	0.625	1.8	A	EL	8.327	0.80	0.247	1.99	A	EL	41.634	
		SNS5A	35.550	--	1.812	64.409	1.4	0.247	3.01	A	EL	41.634	0.625	1.81	A	EL	8.327	0.80	0.247	1.95	A	EL	41.634	
		SNS6A	39.950	--	1.647	65.797	1.4	0.247	2.75	A	EL	41.634	0.625	1.65	A	EL	8.327	0.80	0.247	1.78	A	EL	41.634	
		SNS7B	42.000	--	1.61	67.634	1.4	0.247	2.62	A	EL	41.634	0.625	1.61	A	EL	8.327	0.80	0.247	1.70	A	EL	41.634	
	TTST	TNAGRIT3	33.000	--	1.965	64.845	1.4	0.247	3.35	A	EL	41.634	0.625	1.97	A	EL	8.327	0.80	0.247	2.17	A	EL	41.634	
		TNT4A	33.075	--	1.922	63.556	1.4	0.247	3.36	A	EL	41.634	0.625	1.92	A	EL	8.327	0.80	0.247	2.18	A	EL	41.634	
		TNT6A	41.600	--	1.701	70.755	1.4	0.247	2.74	A	EL	41.634	0.625	1.7	A	EL	8.327	0.80	0.247	1.77	A	EL	41.634	
		TNT7A	42.000	--	1.67	70.125	1.4	0.247	2.75	A	EL	41.634	0.625	1.67	A	EL	8.327	0.80	0.247	1.78	A	EL	41.634	
		TNT7B	42.000	--	1.578	66.274	1.4	0.247	2.83	A	EL	41.634	0.625	1.58	A	EL	8.327	0.80	0.247	1.83	A	EL	41.634	
		TNAGRIT4	43.000	--	1.53	65.773	1.4	0.247	2.7	A	EL	41.634	0.625	1.53	A	EL	8.327	0.80	0.247	1.75	A	EL	41.634	
		TNAGT5A	45.000	--	1.511	68.008	1.4	0.247	2.55	A	EL	41.634	0.625	1.51	A	EL	8.327	0.80	0.247	1.65	A	EL	41.634	
		TNAGT5B	45.000	3	1.456	65.508	1.4	0.247	2.52	A	EL	41.634	0.625	1.46	A	EL	8.327	0.80	0.247	1.63	A	EL	41.634	

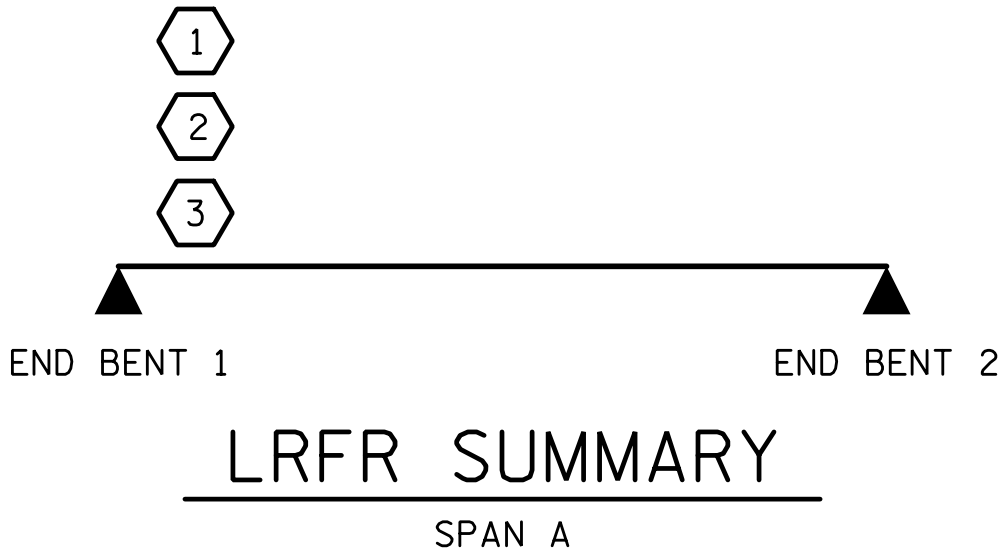

LOAD FACTORS:

DESIGN LOAD RATING FACTORS	LIMIT STATE	γ _{DC}	γ _{DW}
	STRENGTH I	1.25	1.50
	SERVICE III	1.00	1.00

NOTES:

MINIMUM RATING FACTORS ARE BASED ON THE STRENGTH I AND SERVICE III LIMIT STATES.

ALLOWABLE STRESSES FOR SERVICE III LIMIT STATE ARE AS REQUIRED FOR DESIGN.

DISTANCE FROM LEFT END OF SPAN IS MEASURED FROM \varnothing BEARING.

CONTROLLING LOAD RATING

1 DESIGN LOAD RATING (HL-93)

2 DESIGN LOAD RATING (HS-20)

3 LEGAL LOAD RATING **

** SEE CHART FOR VEHICLE TYPE

GIRDER LOCATION

I - INTERIOR GIRDER
EL - EXTERIOR LEFT GIRDER
ER - EXTERIOR RIGHT GIRDER


PROJECT NO. 17BP.7.R.98
ORANGE COUNTY
STATION: 13+83.50 -L-

DRAWN BY: T. BANKOVICH	DATE: 9-16
CHECKED BY: B.S. COX	DATE: 9-16
DESIGN ENGINEER OF RECORD: B.S. COX	DATE: 9-16

PLANS PREPARED BY:

SE & A
SIMPSON ENGINEERS & ASSOCIATES
5640 Dillard Drive
Suite 200
Cary, NC 27518
(919) 852-0468
(919) 852-0598 (Fax)
www.simpsonengr.com


LICENSURE NO. C-2521

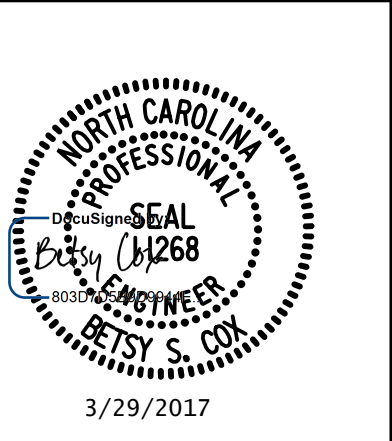

STATE OF NORTH CAROLINA DEPARTMENT OF TRANSPORTATION RALEIGH						SHEET NO. S-3		
LRFR SUMMARY FOR 85'-0" BOX BEAM UNIT 60° SKEW (NON-INTERSTATE TRAFFIC)						TOTAL SHEETS 19		
REVISIONS								
NO.	BY:	DATE:	NO.	BY:	DATE:			
1			3					
2			4					

DOCUMENT NOT CONSIDERED FINAL
UNLESS ALL SIGNATURES COMPLETED

3/29/2017 7:54:51 AM G:\Projects\2015\Division 7 (Hatch Mot+T)\17BP7R98 (Orange 189) (60 33BB 2BMR)\Structures\Drawings\Final\401.17BP7R98_SMU_SUPER.dgn

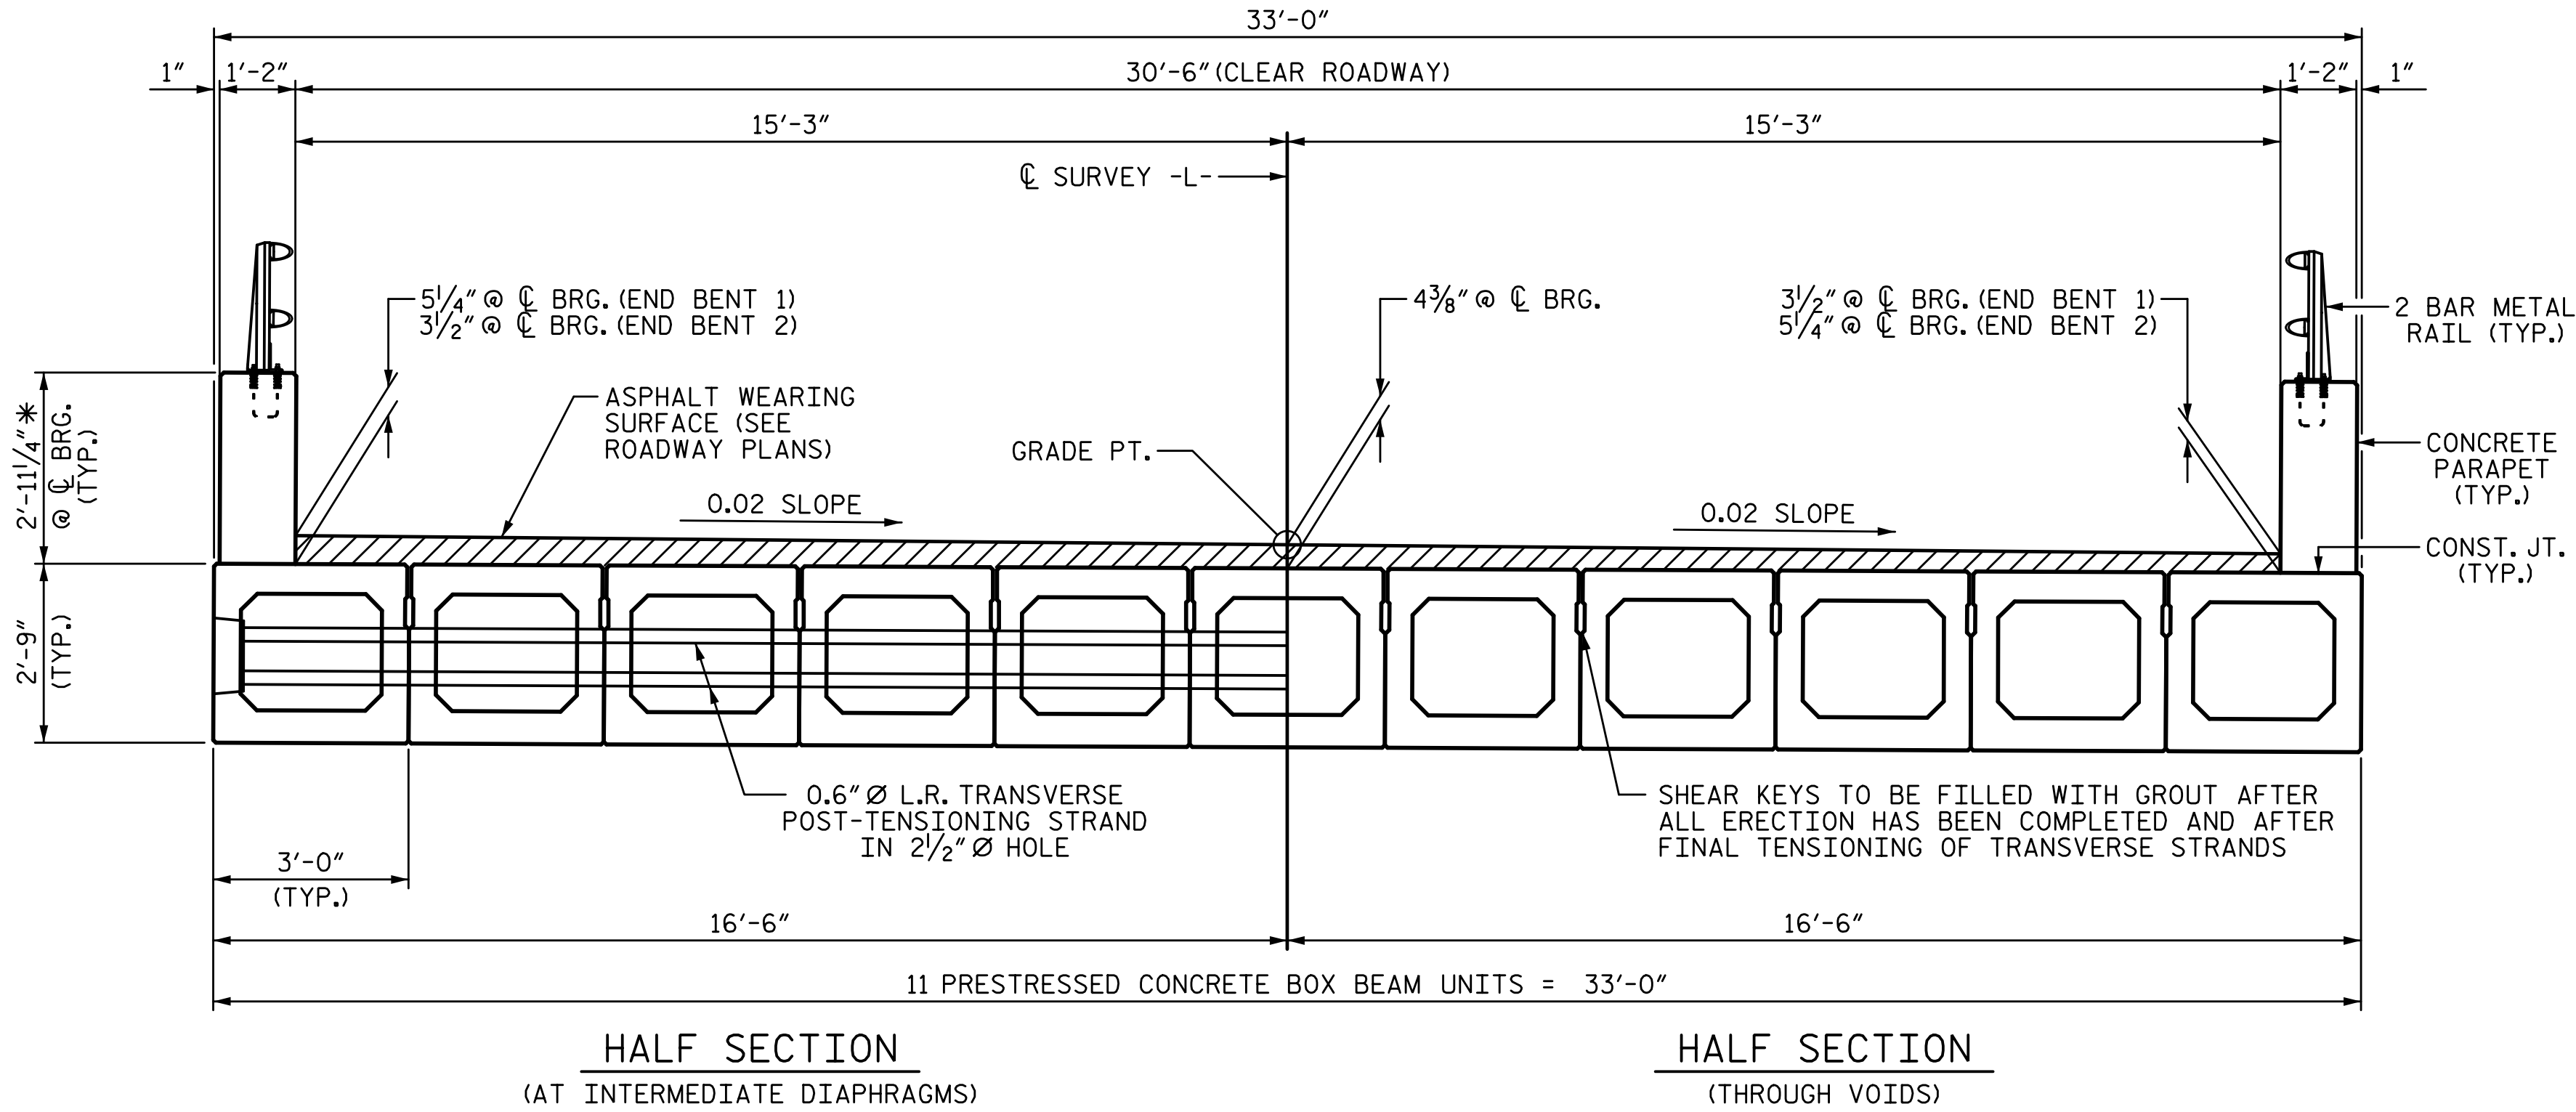


HALF SECTION
(AT INTERMEDIATE DIAPHRAGMS)

HALF SECTION
(THROUGH VOIDS)

TYPICAL SECTION


* - THE MAXIMUM CONCRETE PARAPET HEIGHTS AND ASPHALT THICKNESS ARE SHOWN. THE HEIGHT OF THE CONCRETE PARAPET AND ASPHALT THICKNESS VARIES WHILE THE TOP OF THE CONCRETE PARAPET FOLLOWS THE PROFILE OF THE GUTTERLINE.

FIXED END

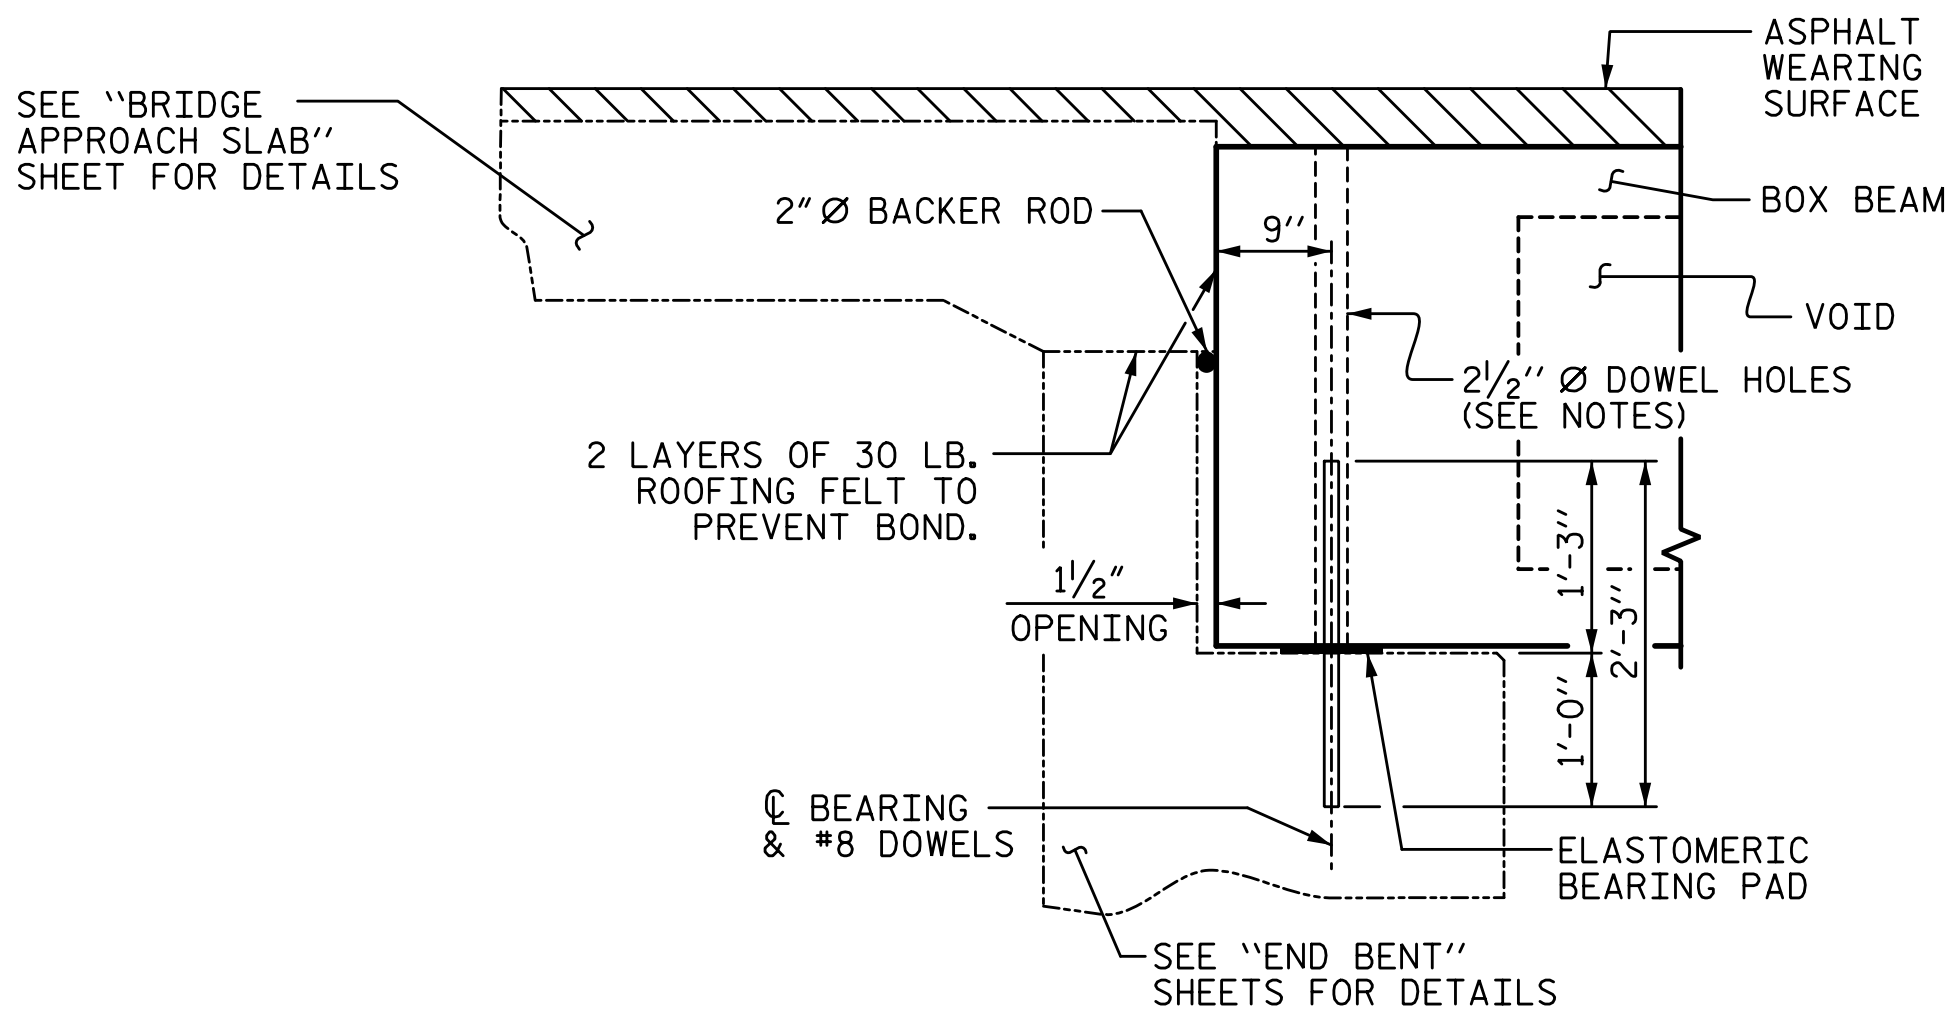


SECTION AT END BENT

PERMITTED THREADED INSERT
CAST IN OUTSIDE FACE OF
EXTERIOR UNIT AND
RECESSED 3/8" SIZE TO BE
DETERMINED
BY CONTRACTOR.

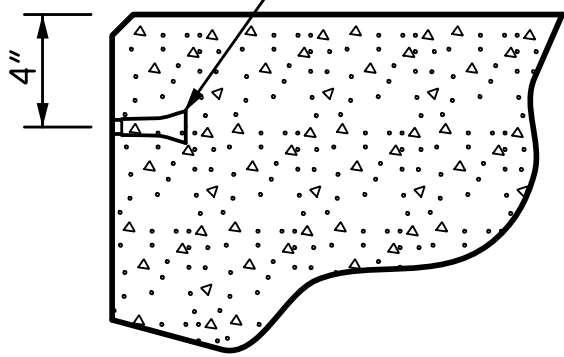

THREADED INSERT DETAIL

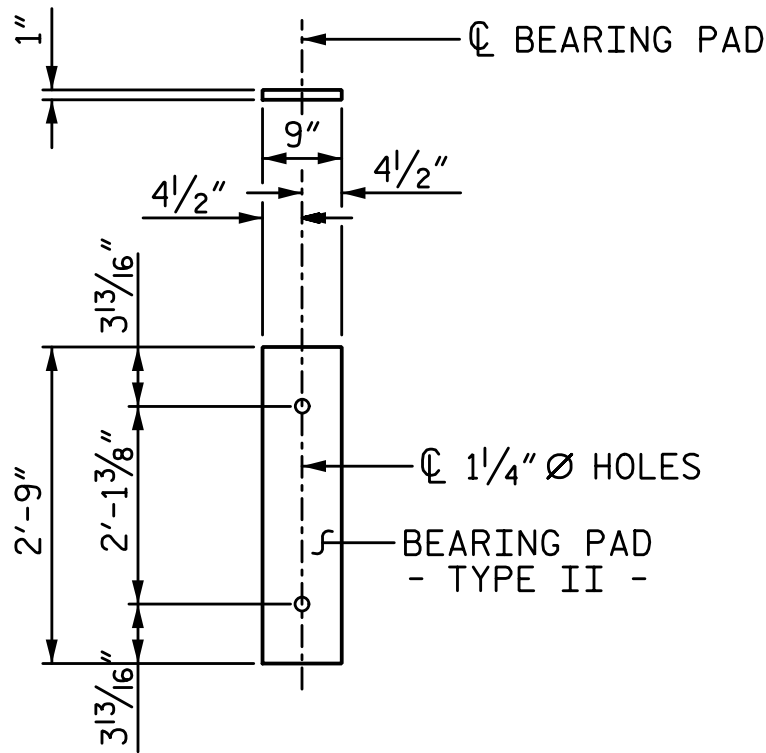

FIXED END

(TYPE II - 22 REQ'D)

ELASTOMERIC BEARING DETAILS

ELASTOMER IN ALL BEARINGS SHALL
BE 60 DUROMETER HARDNESS.

PLANS PREPARED BY:

SE & A
SIMPSON
ENGINEERS
& ASSOCIATES

5640 Dillard Drive
Suite 200
Cary, NC 27518
(919) 852-0468
(919) 852-0598 (Fax)
www.simpsonengr.com

LICENSURE NO. C-2521



PROJECT NO. 17BP.7.R.98

ORANGE COUNTY

STATION: 13+83.50 -L-

SHEET 1 OF 4

STATE OF NORTH CAROLINA
DEPARTMENT OF TRANSPORTATION

RALEIGH

SUPERSTRUCTURE

3'-0" X 2'-9"
PRESTRESSED CONCRETE
BOX BEAM UNIT


60° SKEW

REVISIONS


NO.	BY:	DATE:	NO.	BY:	DATE:	SHEET NO.
1			3			S-4
2			4			TOTAL SHEETS 19

DOCUMENT NOT CONSIDERED FINAL
UNLESS ALL SIGNATURES COMPLETED

3/29/2017 7:54:51 AM G:\Projects\2015\Division 7 (Hatch Mot+T)\17BP7R98 (Orange 189) (60 33BB 2BMR)\Structures\Drawings\Final\401.17BP7R98_SMJ_SUPER.dgn

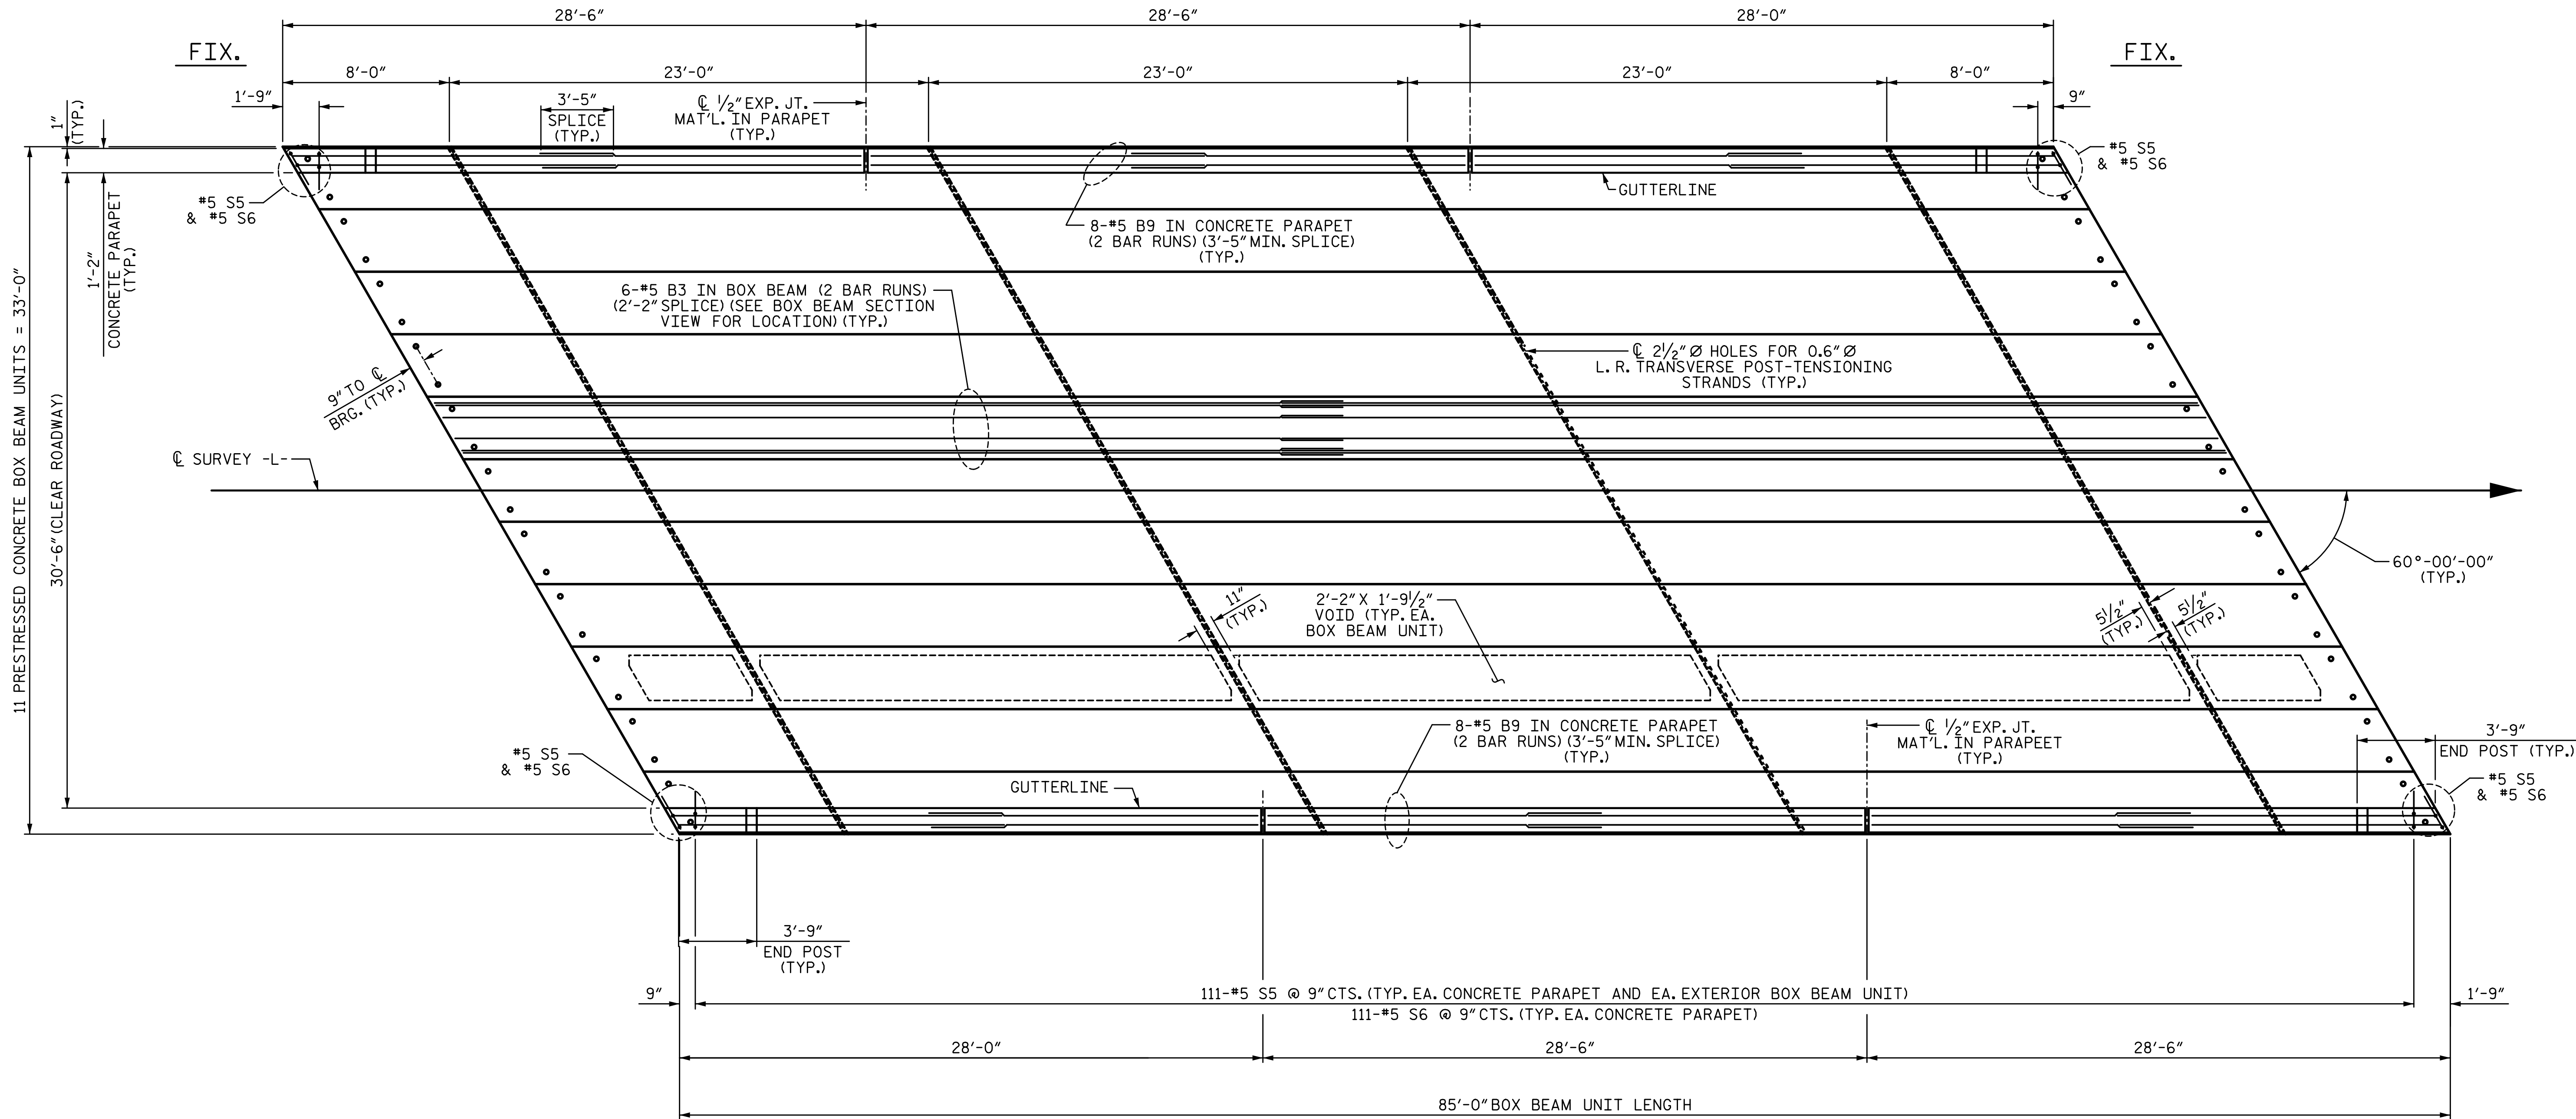

PLAN OF SPAN A

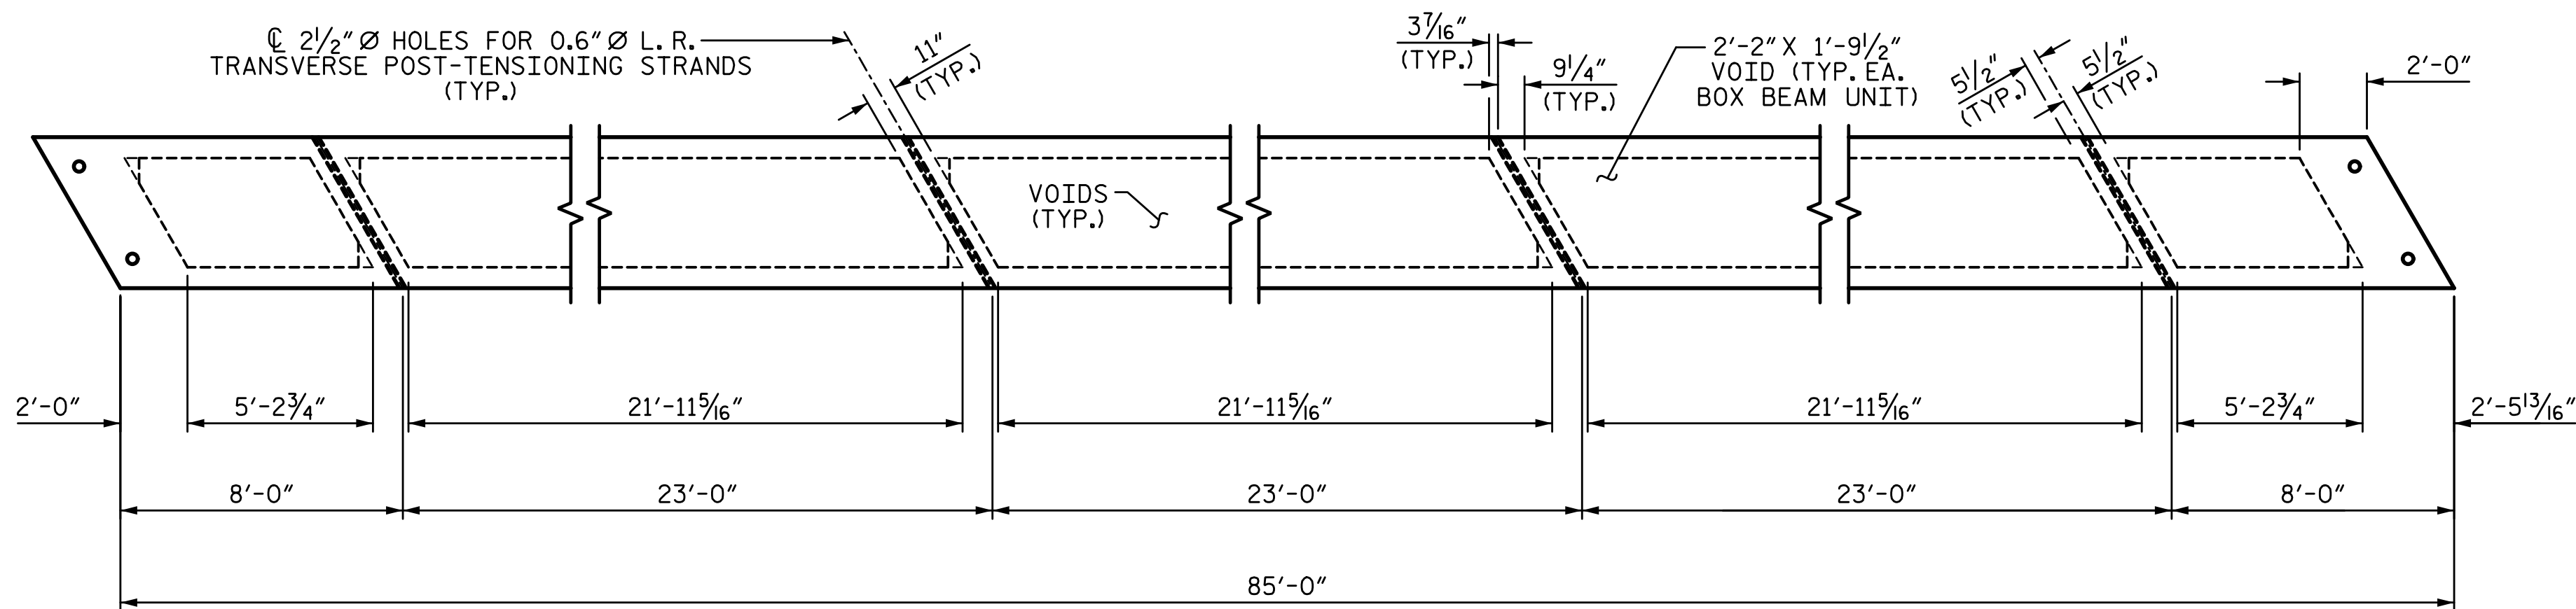

DIAPHRAGM AND VOID LAYOUT

PROJECT NO. 17BP.7.R.98
ORANGE COUNTY
STATION: 13+83.50 -L-

SHEET 2 OF 4

DRAWN BY: T. BANKOVICH DATE: 9-16
CHECKED BY: B.S. COX DATE: 9-16
DESIGN ENGINEER OF RECORD: B.S. COX DATE: 9-16


PLANS PREPARED BY:
SE & A
SIMPSON ENGINEERS & ASSOCIATES
5640 Dillard Drive
Suite 200
Cary, NC 27518
(919) 852-0468
(919) 852-0598 (Fax)
www.simpsonengr.com
LICENSURE NO. C-2521



REVISIONS						SHEET NO. S-5
NO.	BY:	DATE:	NO.	BY:	DATE:	
1			3			TOTAL SHEETS 19
2			4			


DOCUMENT NOT CONSIDERED FINAL
UNLESS ALL SIGNATURES COMPLETED

3/29/2017 7:54:52 AM G:\Projects\2015\Division 7 (Hatch Mot)\17BP7R98 (Orange 189) (60 33BB 2BMR)\Structures\Drawings\Final\401.17BP7R98_SMU_SUPER.dgn

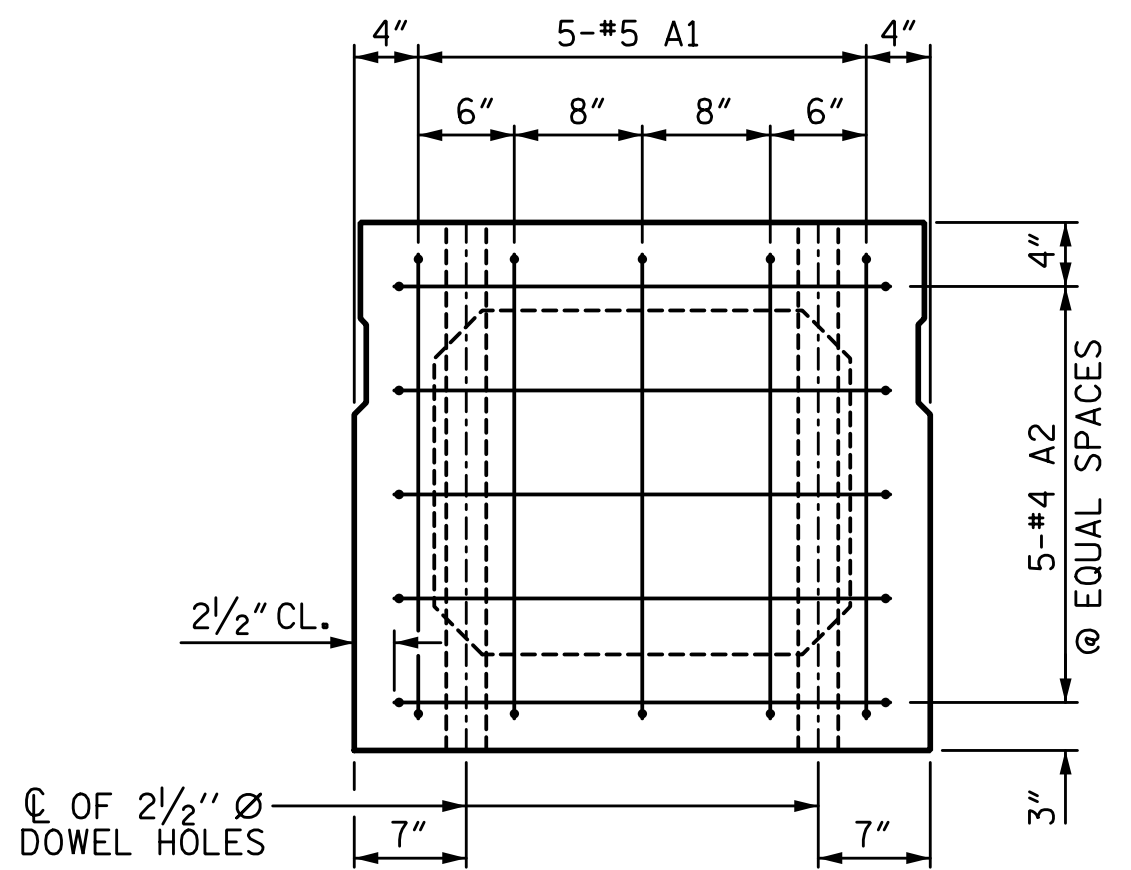


END ELEVATION

SHOWING PLACEMENT OF #5 & #4 "A" BARS AND LOCATION OF DOWEL HOLES. (INTERIOR BOX BEAM SECTION SHOWN-EXTERIOR SECTION SIMILAR EXCEPT SHEAR KEY LOCATION. STRAND LAYOUT NOT SHOWN.)

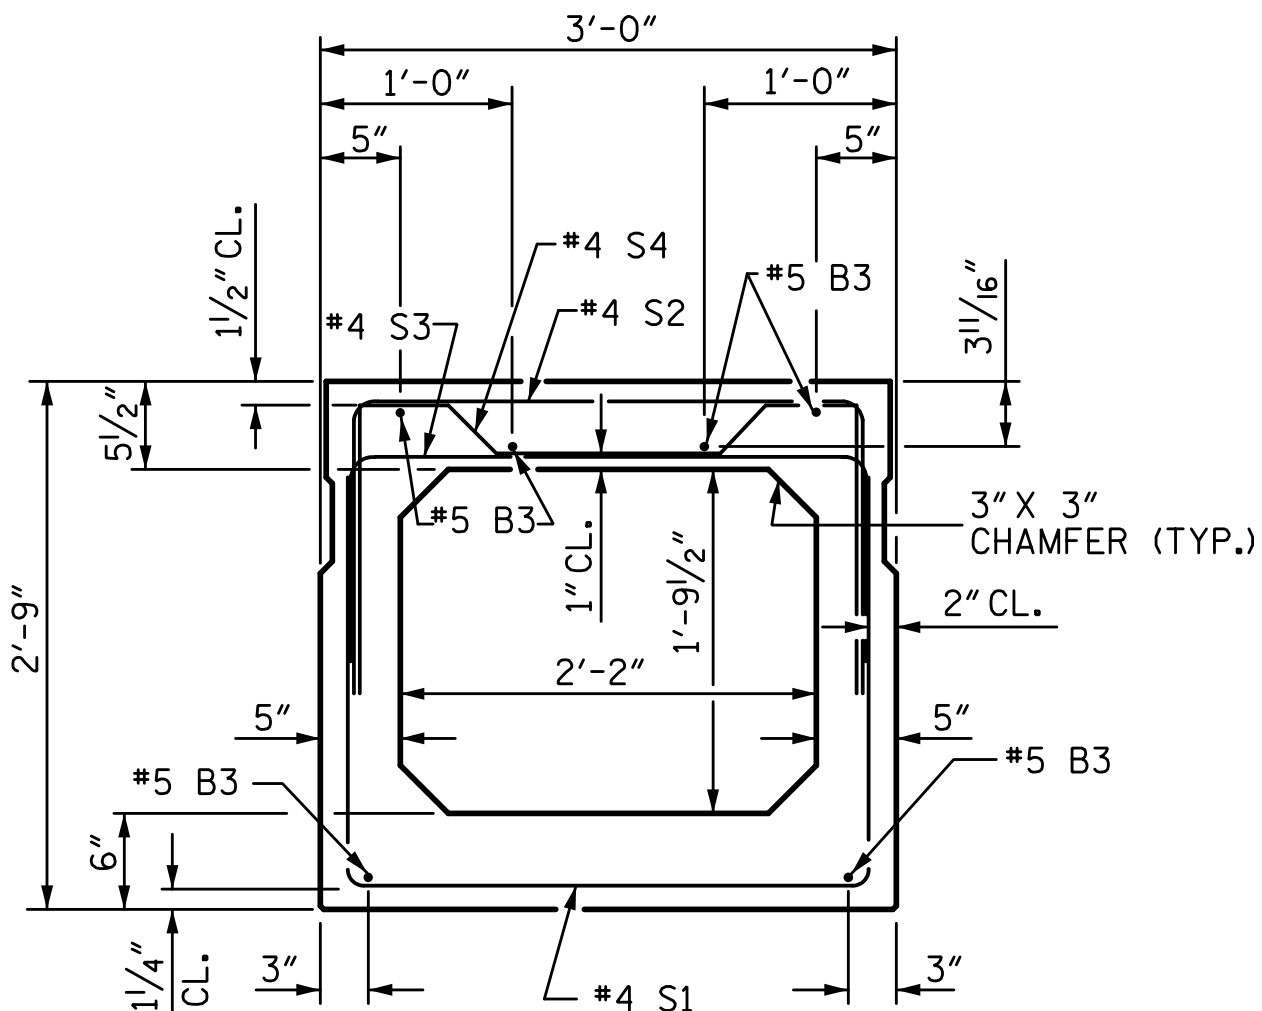


INTERIOR BOX BEAM SECTION

(STRAND LAYOUT NOT SHOWN)

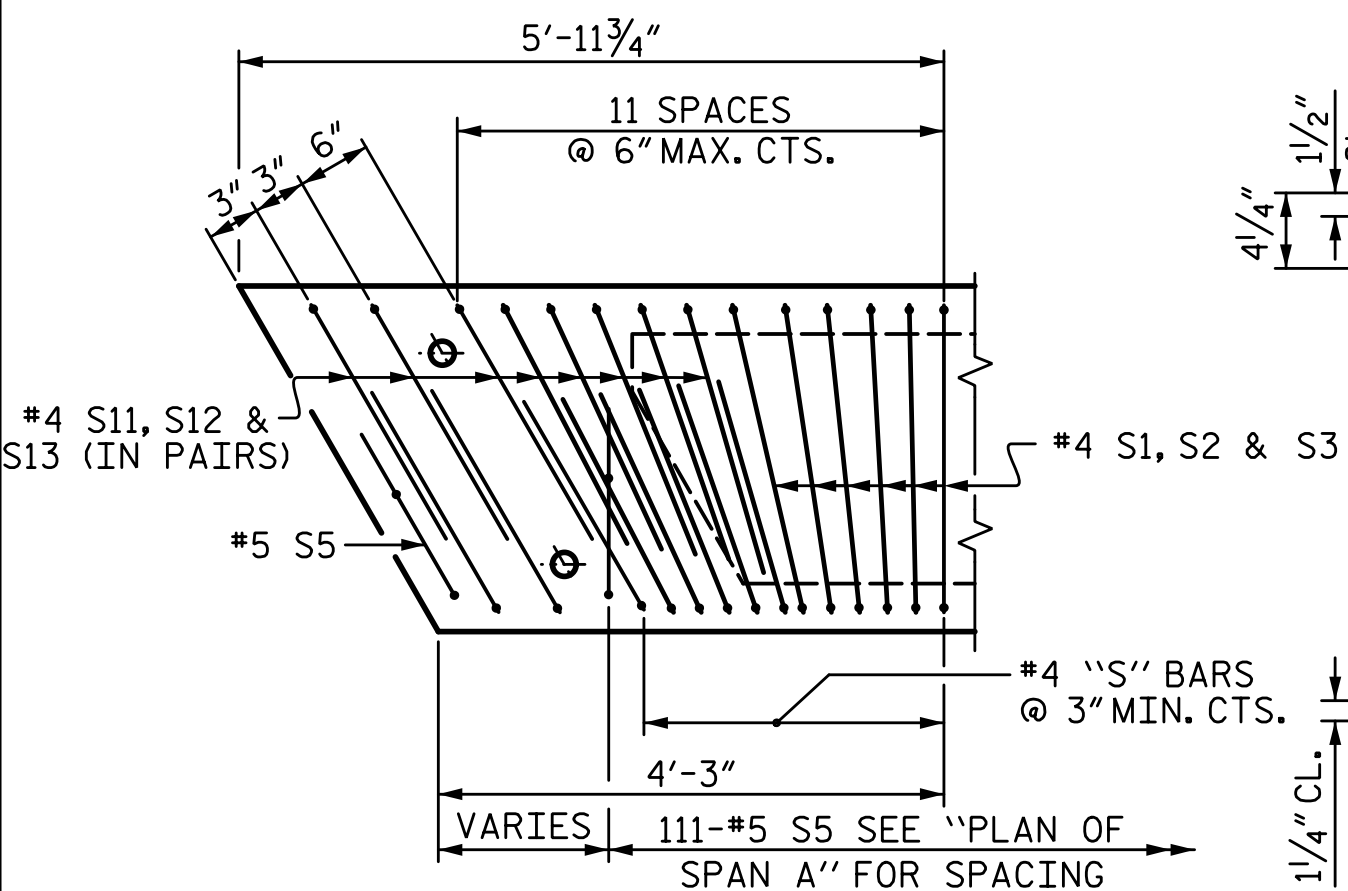


DETAIL "B"

EXTERIOR UNIT SHOWN, INTERIOR UNIT SIMILAR EXCEPT OMIT #5 S5 BARS. "B" BARS AND "A" BARS NOT SHOWN.

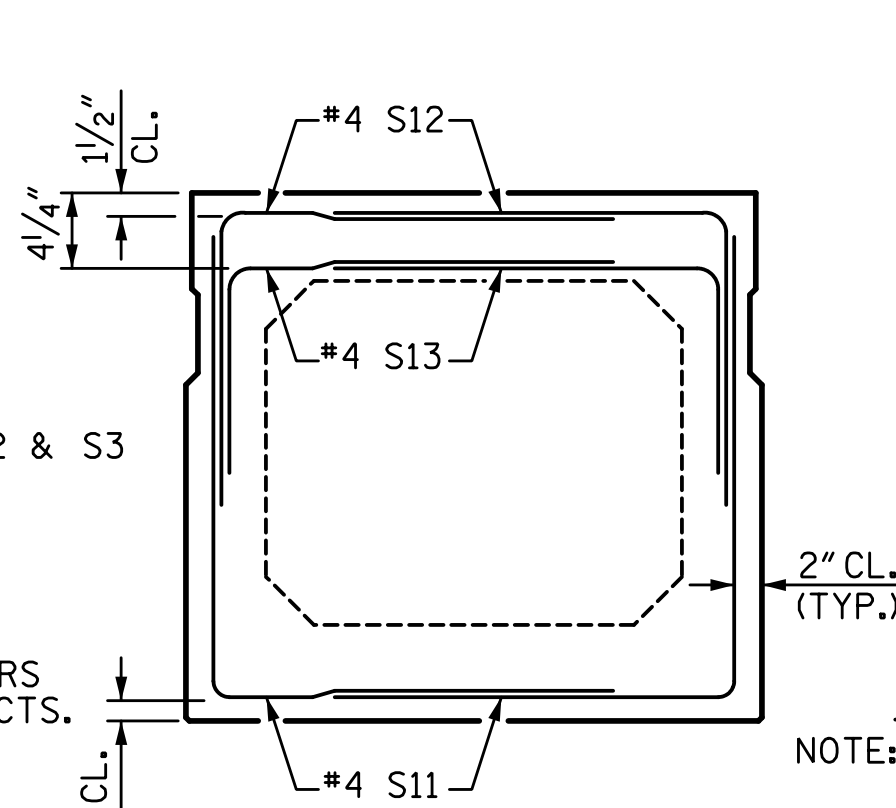


END VIEW

(SHOWING #4 "S" BARS IN END OF BEAM)

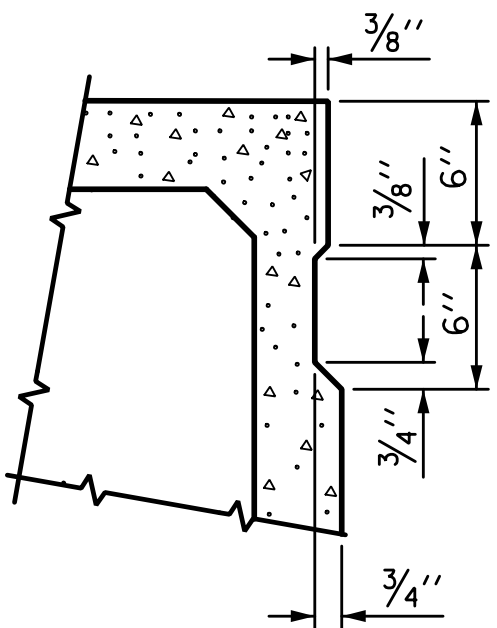


SHEAR KEY DETAIL

NOTE: OMIT SHEAR KEY ON OUTSIDE FACE OF EXTERIOR BOX BEAMS.

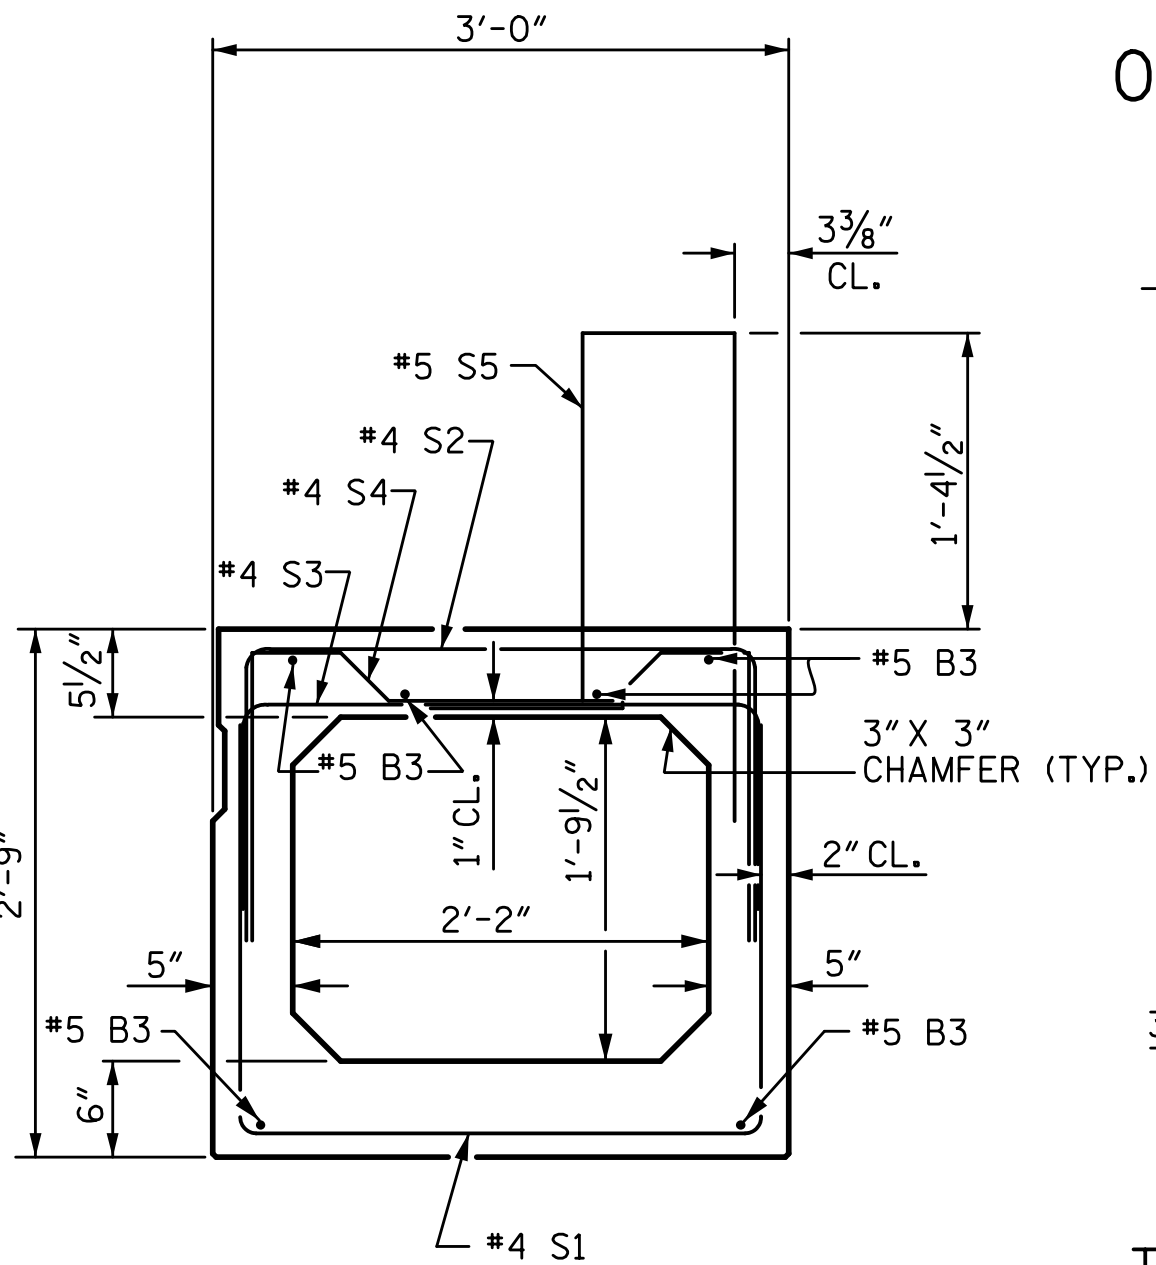

EXTERIOR BOX BEAM SECTION


(STRAND LAYOUT NOT SHOWN)

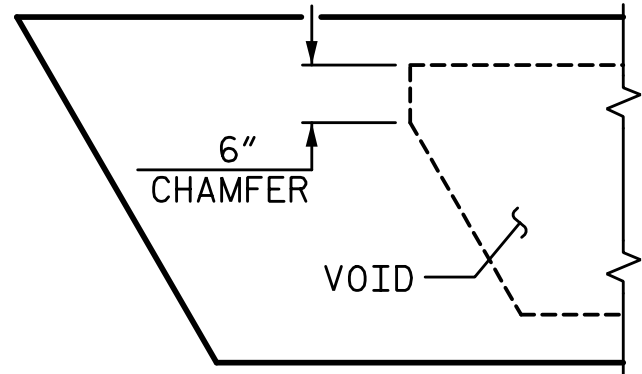

CHAMFER DETAIL

SHOWING 6" VOID CHAMFER

0.6" Ø LOW RELAXATION STRAND LAYOUT

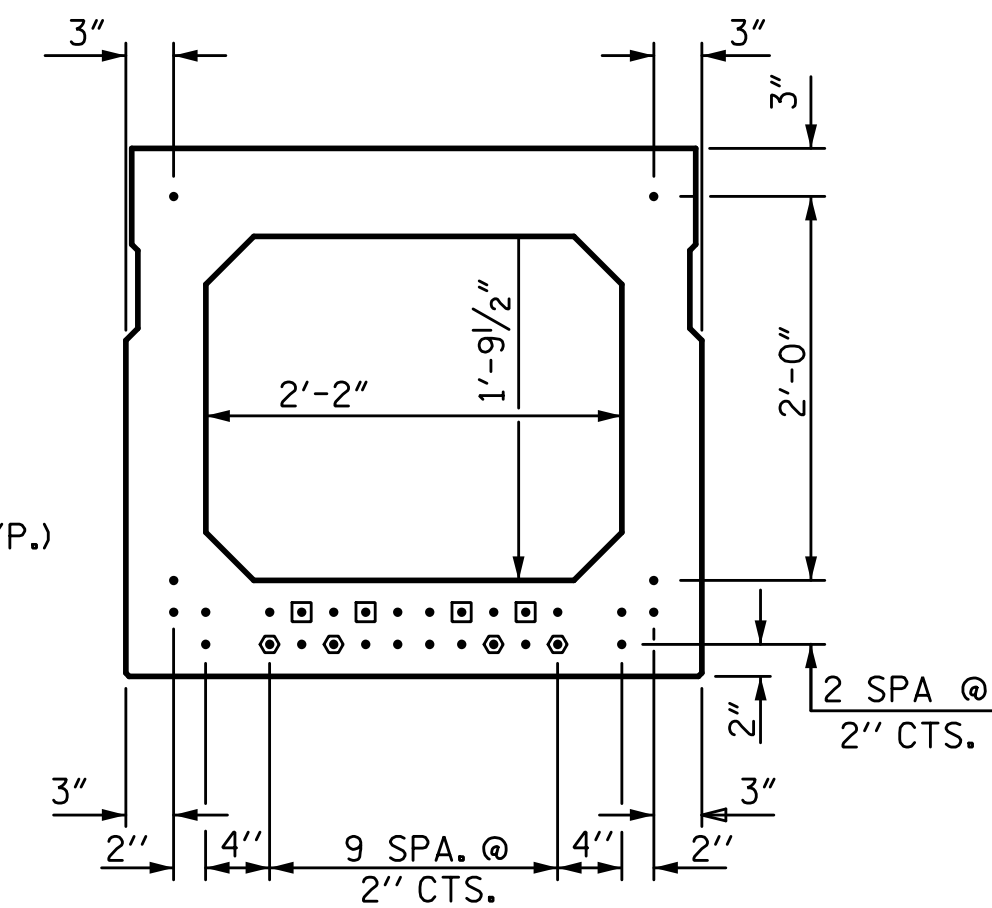

TYPICAL STAND LOCATION

(30 STRANDS REQUIRED)


DEBONDING LEGEND

- FULLY BONDED STRANDS
- STRANDS DEBONDED FOR 4'-0" FROM END OF GIRDER
- STRANDS DEBONDED FOR 12'-0" FROM END OF GIRDER

BOND SHALL BE BROKEN ON STRANDS AS SHOWN FOR THE SPECIFIED LENGTH FROM EACH END OF THE BOX BEAM. SEE STANDARD SPECIFICATIONS ARTICLE 1078-7.

GRADE 270 STRANDS

	0.6" Ø L.R.
AREA (SQUARE INCHES)	0.217
ULTIMATE STRENGTH (LBS. PER STRAND)	58,600
APPLIED PRESTRESS (LBS. PER STRAND)	43,950

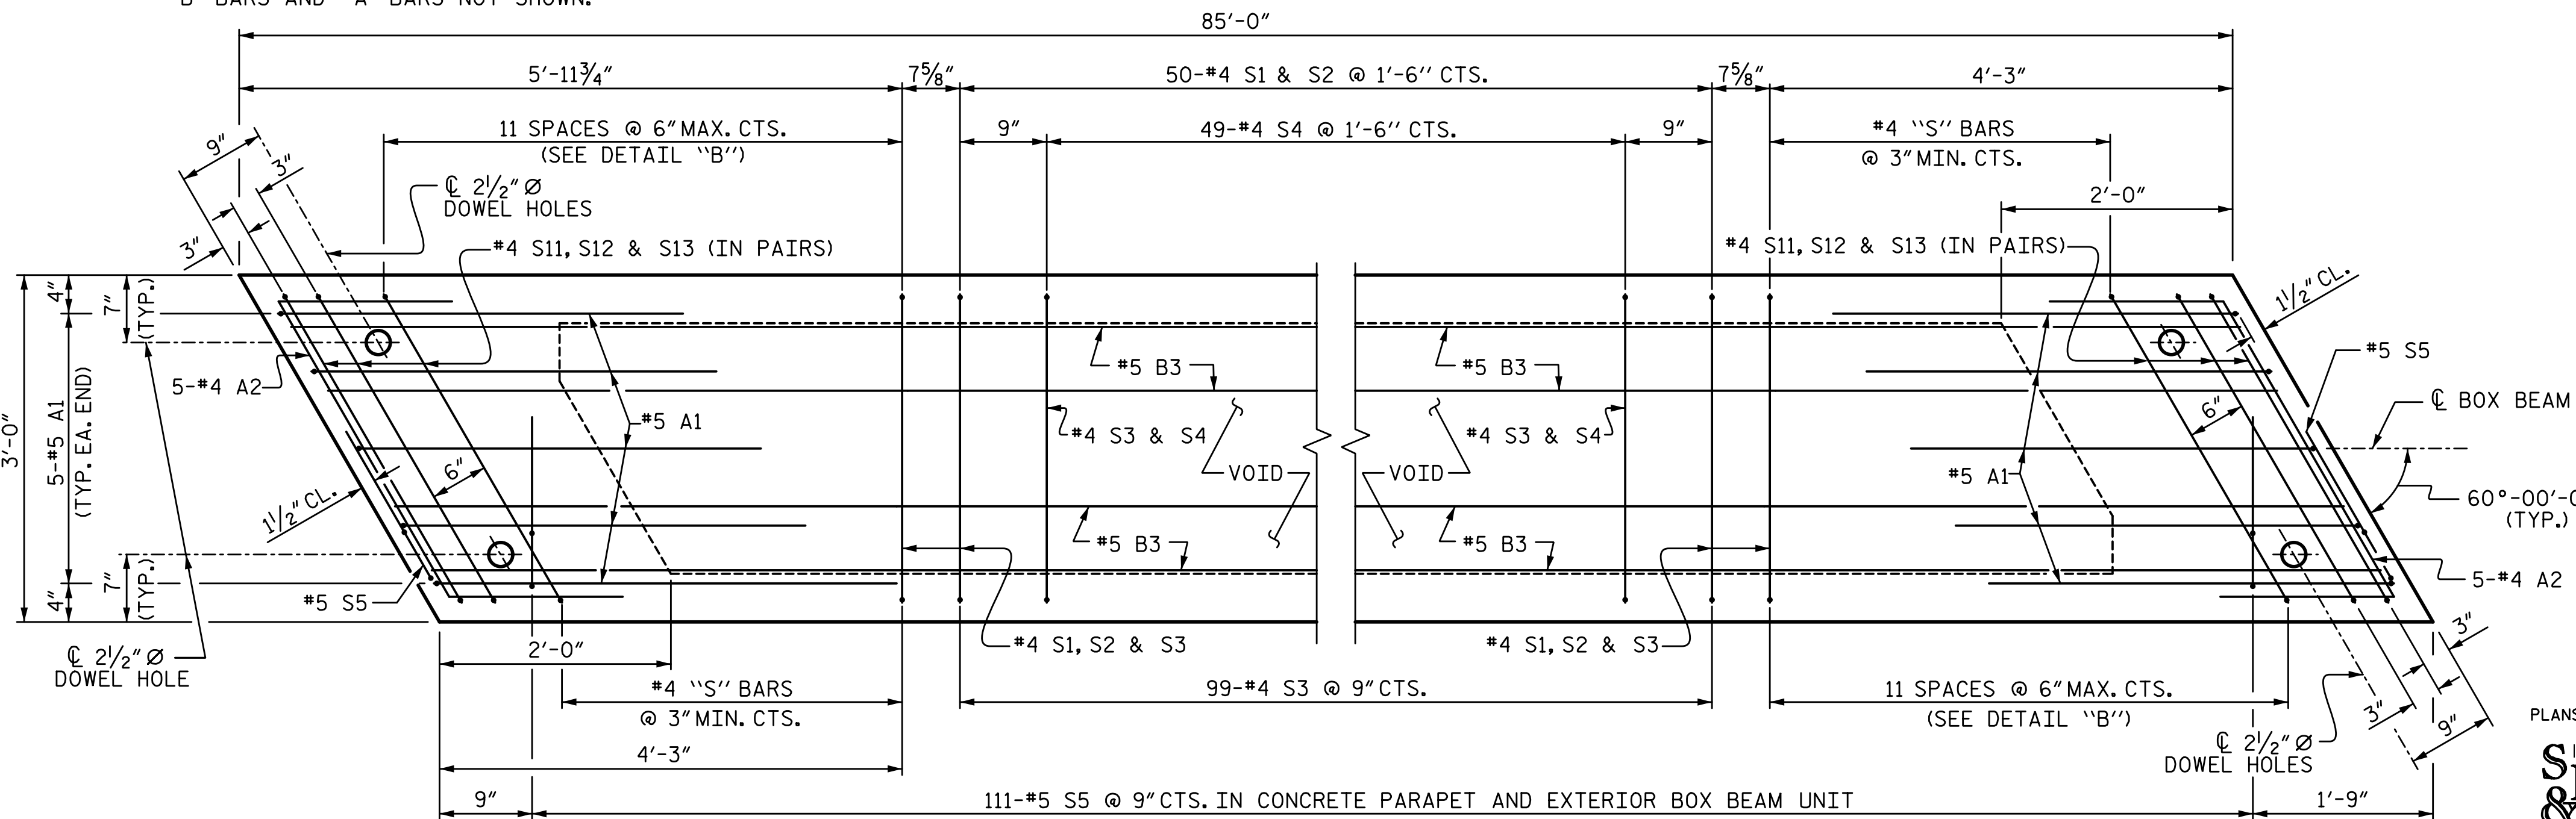

PLAN OF BOX BEAM


EXTERIOR UNIT SHOWN, INTERIOR UNIT SIMILAR EXCEPT OMIT #5 S5 BARS. FOR LOCATION OF DIAPHRAGMS, SEE "PLAN OF UNIT". FOR THREADED INSERTS, SEE "THREADED INSERT DETAIL". FOR REINFORCING STEEL IN DIAPHRAGMS, SEE "DOUBLE DIAPHRAGM DETAILS".

DRAWN BY: T. BANKOVICH	DATE: 9-16
CHECKED BY: B.S. COX	DATE: 9-16
DESIGN ENGINEER OF RECORD: B.S. COX	DATE: 9-16

PLANS PREPARED BY:

SIMPSON ENGINEERS & ASSOCIATES
5640 Dillard Drive
Suite 200
Cary, NC 27518
(919) 852-0468
(919) 852-0598 (Fax)
www.simpsonengr.com

LICENSURE NO. C-2521

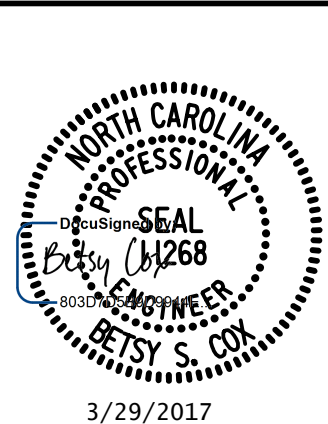

PROJECT NO. 17BP.7.R.98
ORANGE COUNTY
STATION: 13+83.50 -L-



SHEET 3 OF 4

STATE OF NORTH CAROLINA
DEPARTMENT OF TRANSPORTATION
RALEIGH
SUPERSTRUCTURE
3'-0" X 2'-9"
PRESTRESSED CONCRETE
BOX BEAM UNIT

REVISIONS						SHEET NO.
NO.	BY:	DATE:	NO.	BY:	DATE:	
1			3			S-6
2			4			
TOTAL SHEETS						19


DOCUMENT NOT CONSIDERED FINAL
UNLESS ALL SIGNATURES COMPLETED

3/29/2017 7:54:52 AM G:\Projects\2015\Division 7 (Hatch Mot)\17BP7R98 (Orange 189) (60 33BB 2BMR)\Structures\Drawings\Final\401.17BP7R98_SMJ_SUPER.dgn

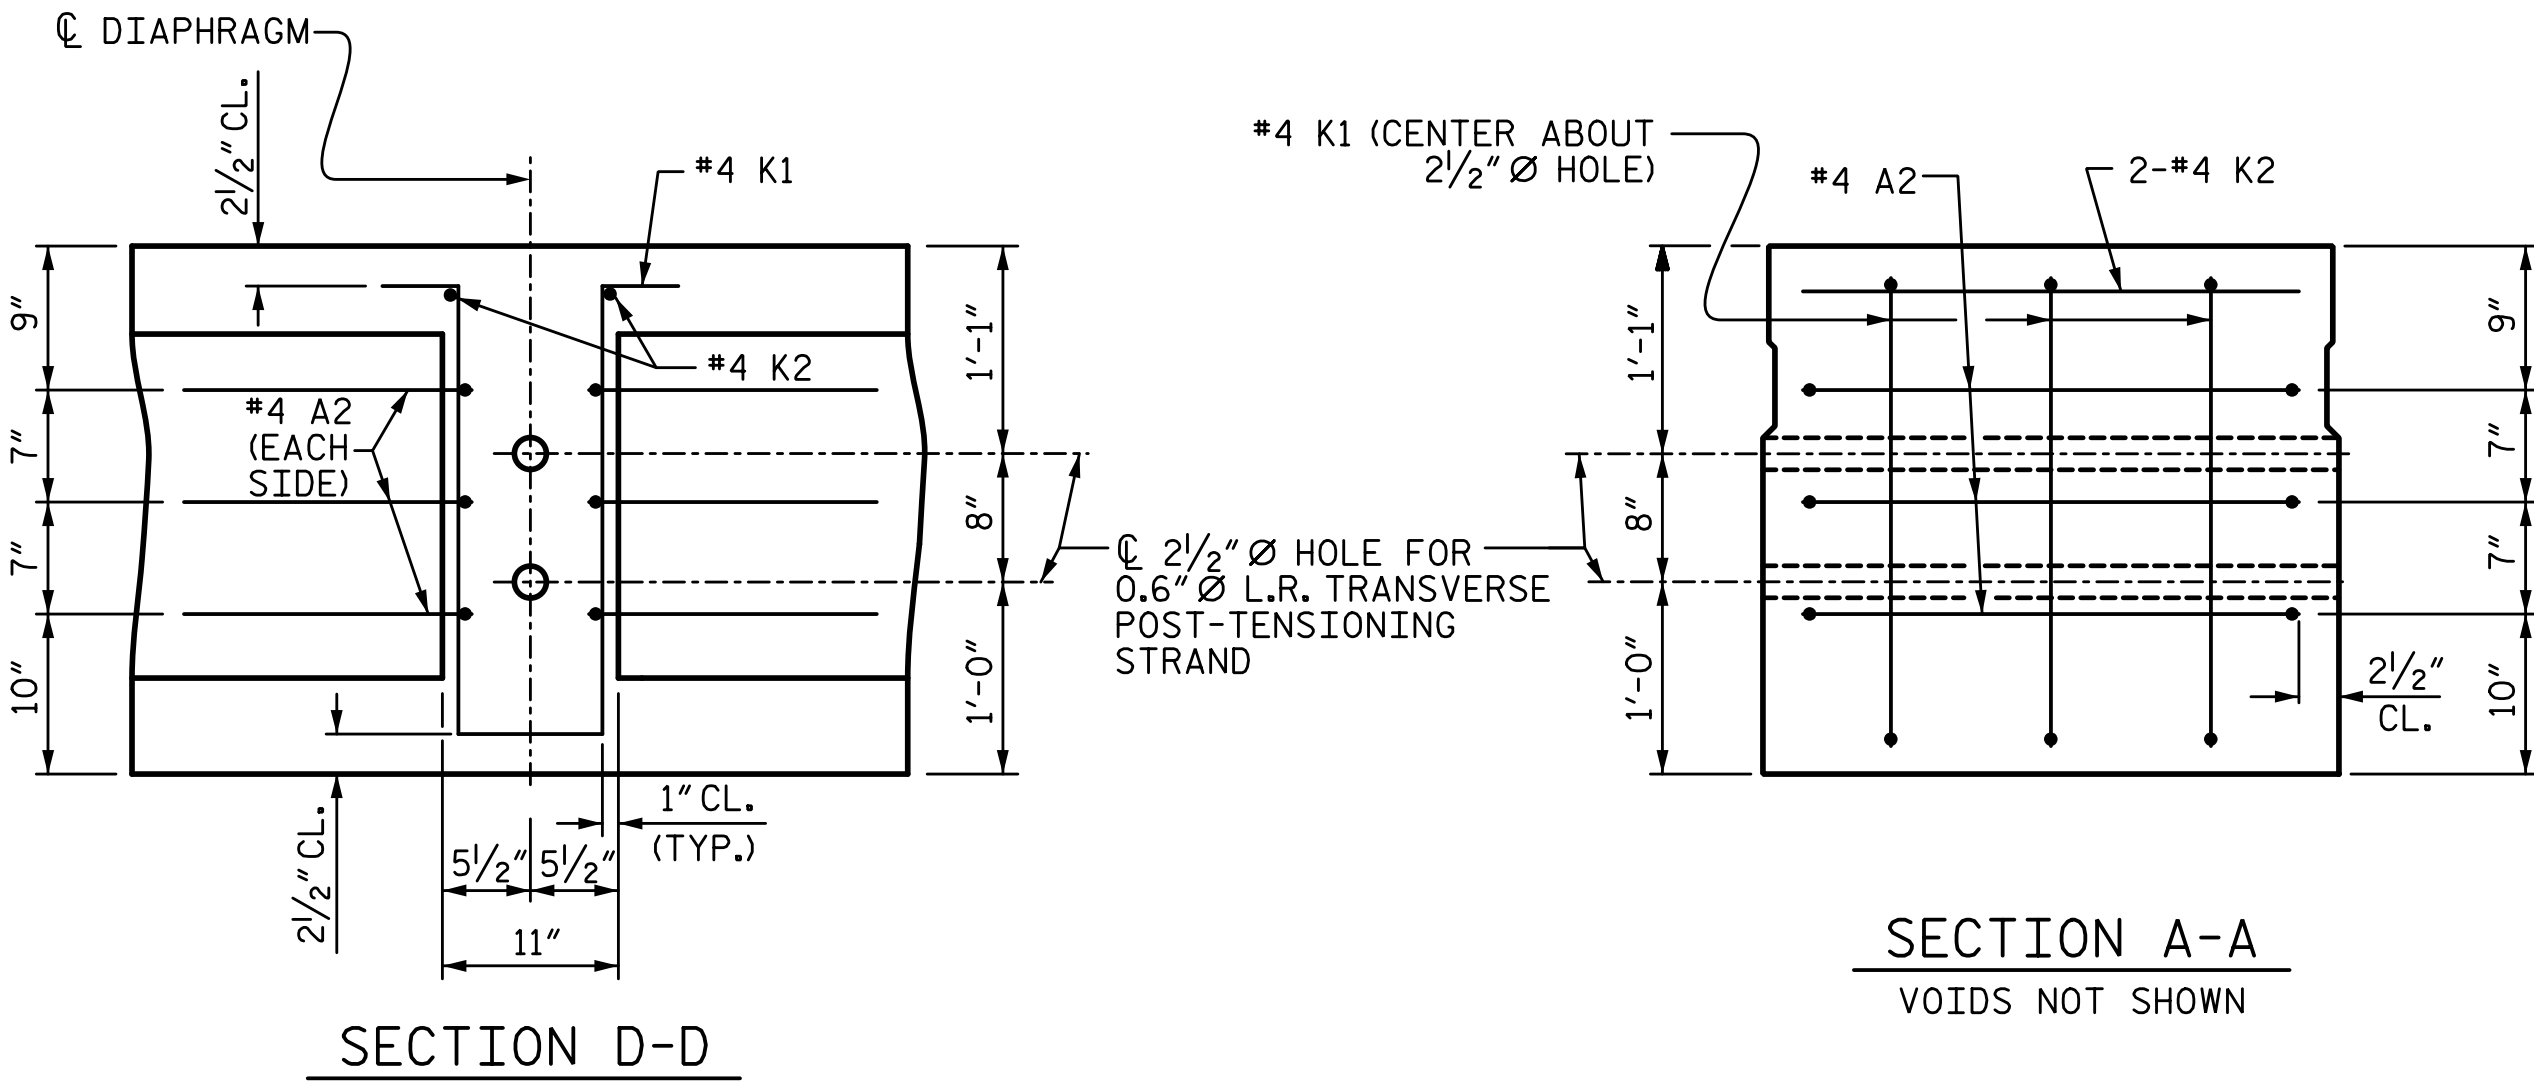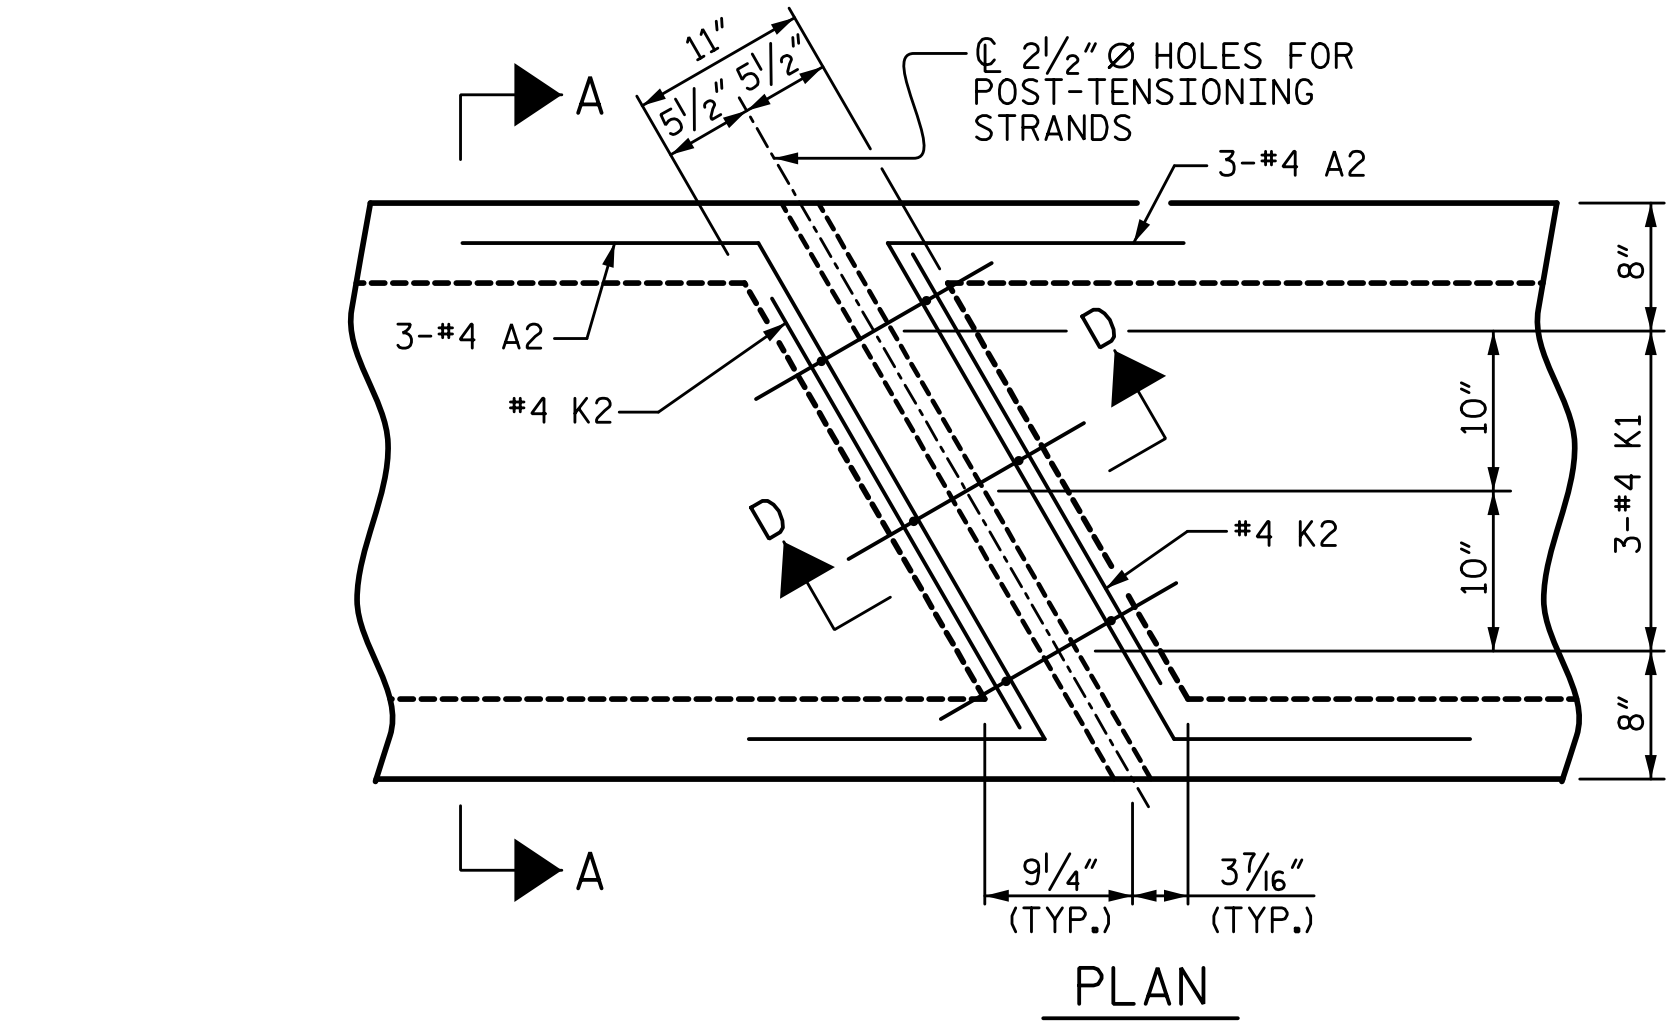

DOUBLE DIAPHRAGM DETAILS

#4 "S" BARS NOT SHOWN. #4 "S" BARS MAY BE SHIFTED SLIGHTLY TO CLEAR 2 1/2" Ø HOLE.

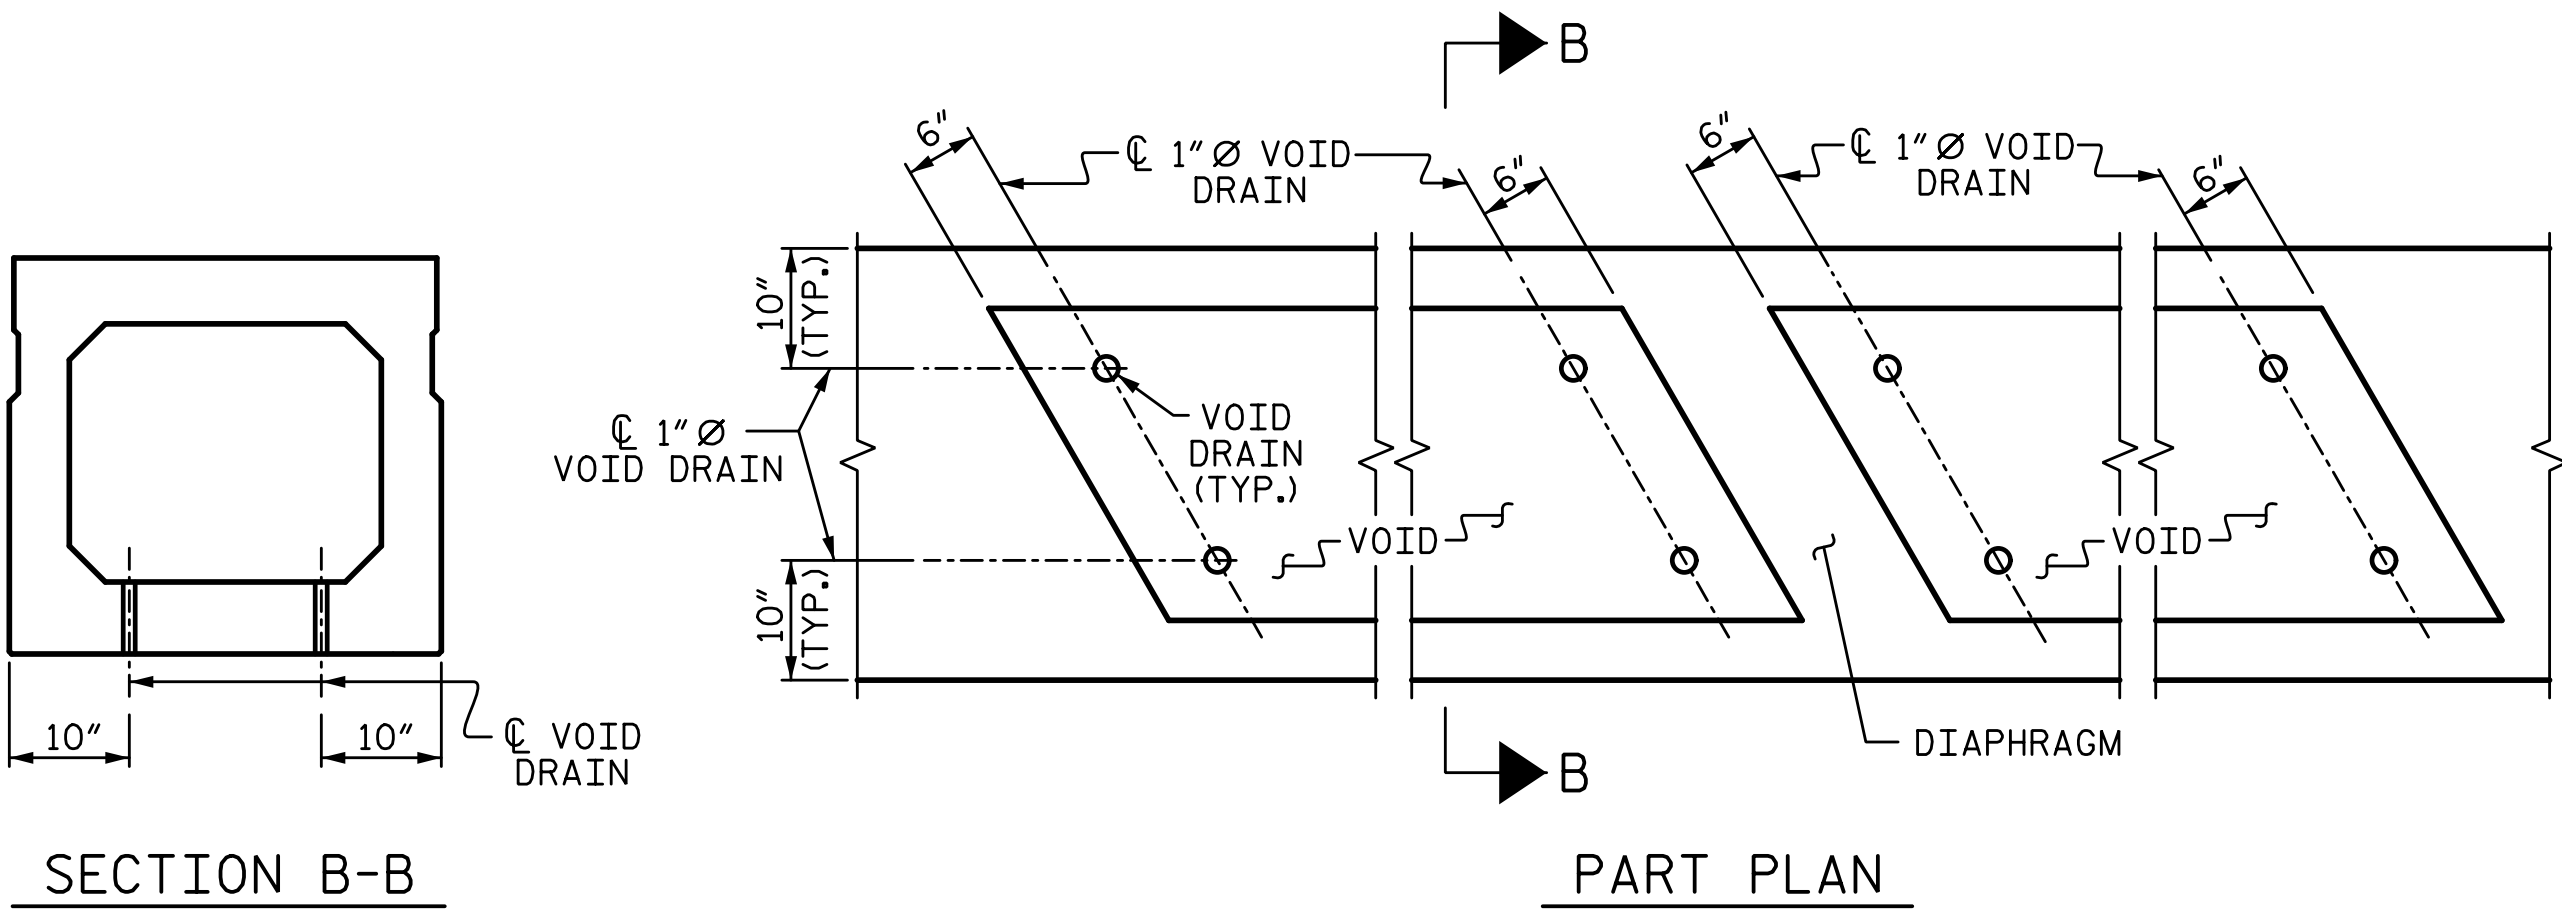

VOID DRAIN DETAILS

(DIMENSIONS SHOWN ARE TYPICAL FOR EACH VOID)

DRAWN BY:	T. BANKOVICH	DATE:	9-16
CHECKED BY:	B.S. COX	DATE:	9-16
DESIGN ENGINEER OF RECORD:	B.S. COX	DATE:	9-16

BOX BEAM UNITS REQUIRED			
	NUMBER	LENGTH	TOTAL LENGTH
EXTERIOR B.B.	2	85'-0"	170'-0"
INTERIOR B.B.	9	85'-0"	765'-0"
TOTAL	11		935'-0"

PLANS PREPARED BY:

S&A
SLIMPSON ENGINEERS & ASSOCIATES
5640 Dillard Drive
Suite 200
Cary, NC 27518
(919) 852-0468
(919) 852-0598 (Fax)
www.slimpsonengr.com
LICENSURE NO. C-2521



DEAD LOAD DEFLECTION AND CAMBER	
	3'-0" x 2'-9"
85' BOX BEAM UNIT	0.6" Ø L.R. STRAND
CAMBER (SLAB ALONE IN PLACE)	2 3/4" ↑
DEFLECTION DUE TO SUPERIMPOSED DEAD LOAD**	3/4" ↓
FINAL CAMBER	2" ↑


** INCLUDES FUTURE WEARING SURFACE

PROJECT NO. 17BP.7.R.98
ORANGE COUNTY
STATION: 13+83.50 -L-


SHEET 4 OF 4

STATE OF NORTH CAROLINA DEPARTMENT OF TRANSPORTATION RALEIGH SUPERSTRUCTURE 3'-0" X 2'-9" PRESTRESSED CONCRETE BOX BEAM UNIT					
REVISIONS					SHEET NO.
NO.	BY:	DATE:	NO.	BY:	DATE:
1			3		
2			4		
TOTAL SHEETS					19


DOCUMENT NOT CONSIDERED FINAL
UNLESS ALL SIGNATURES COMPLETED

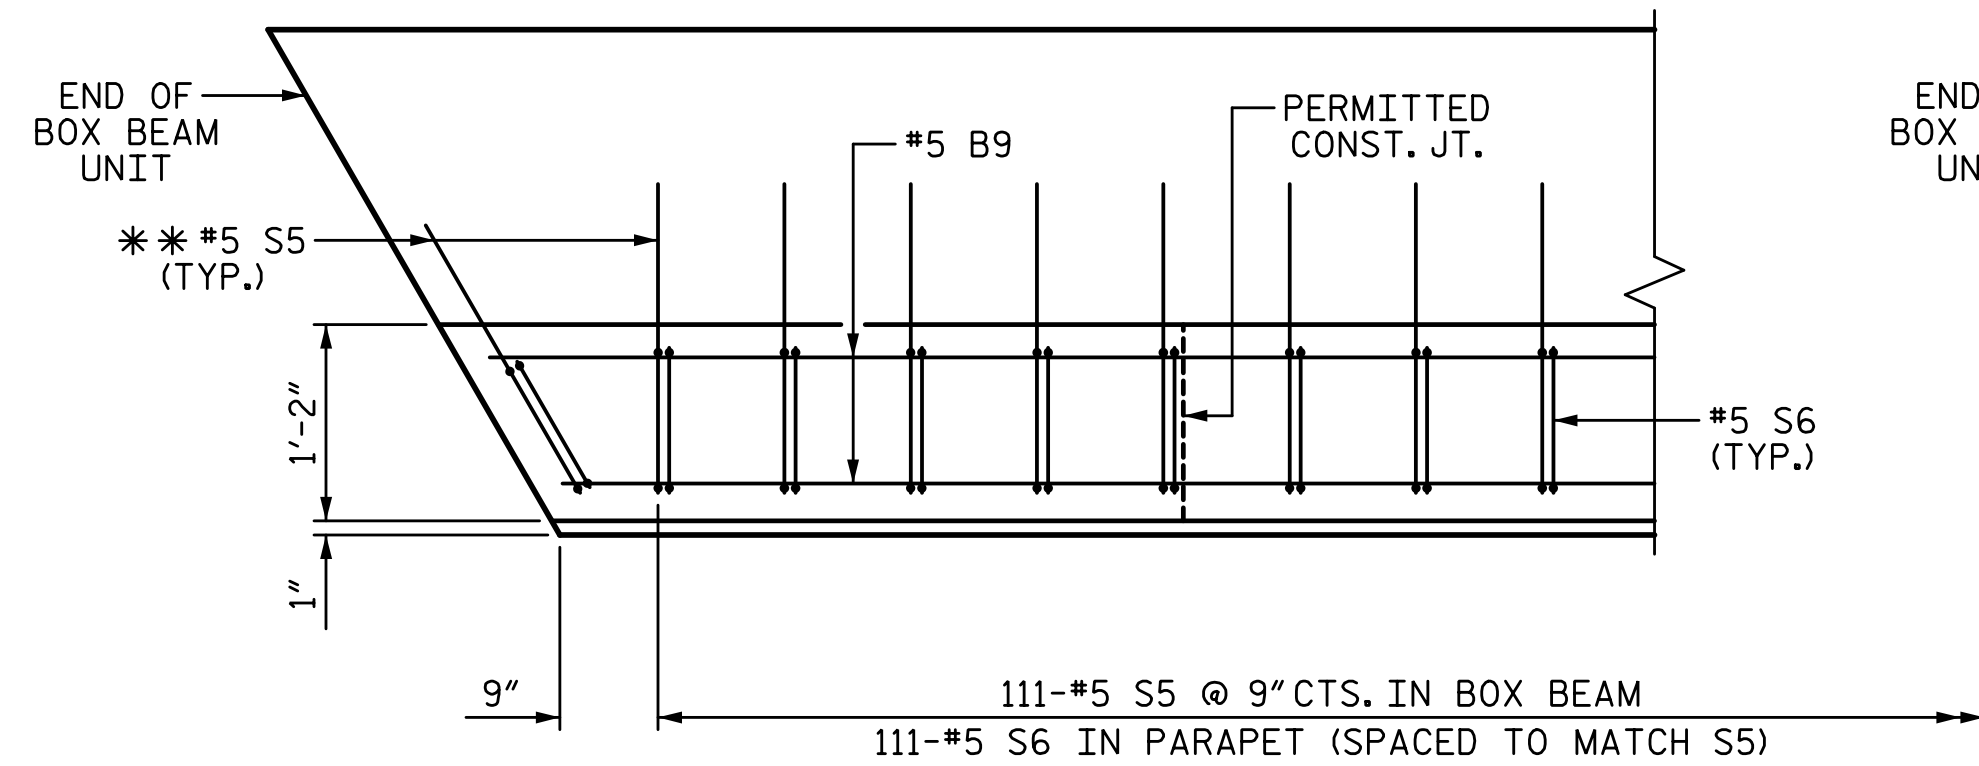


PLAN OF PARAPET

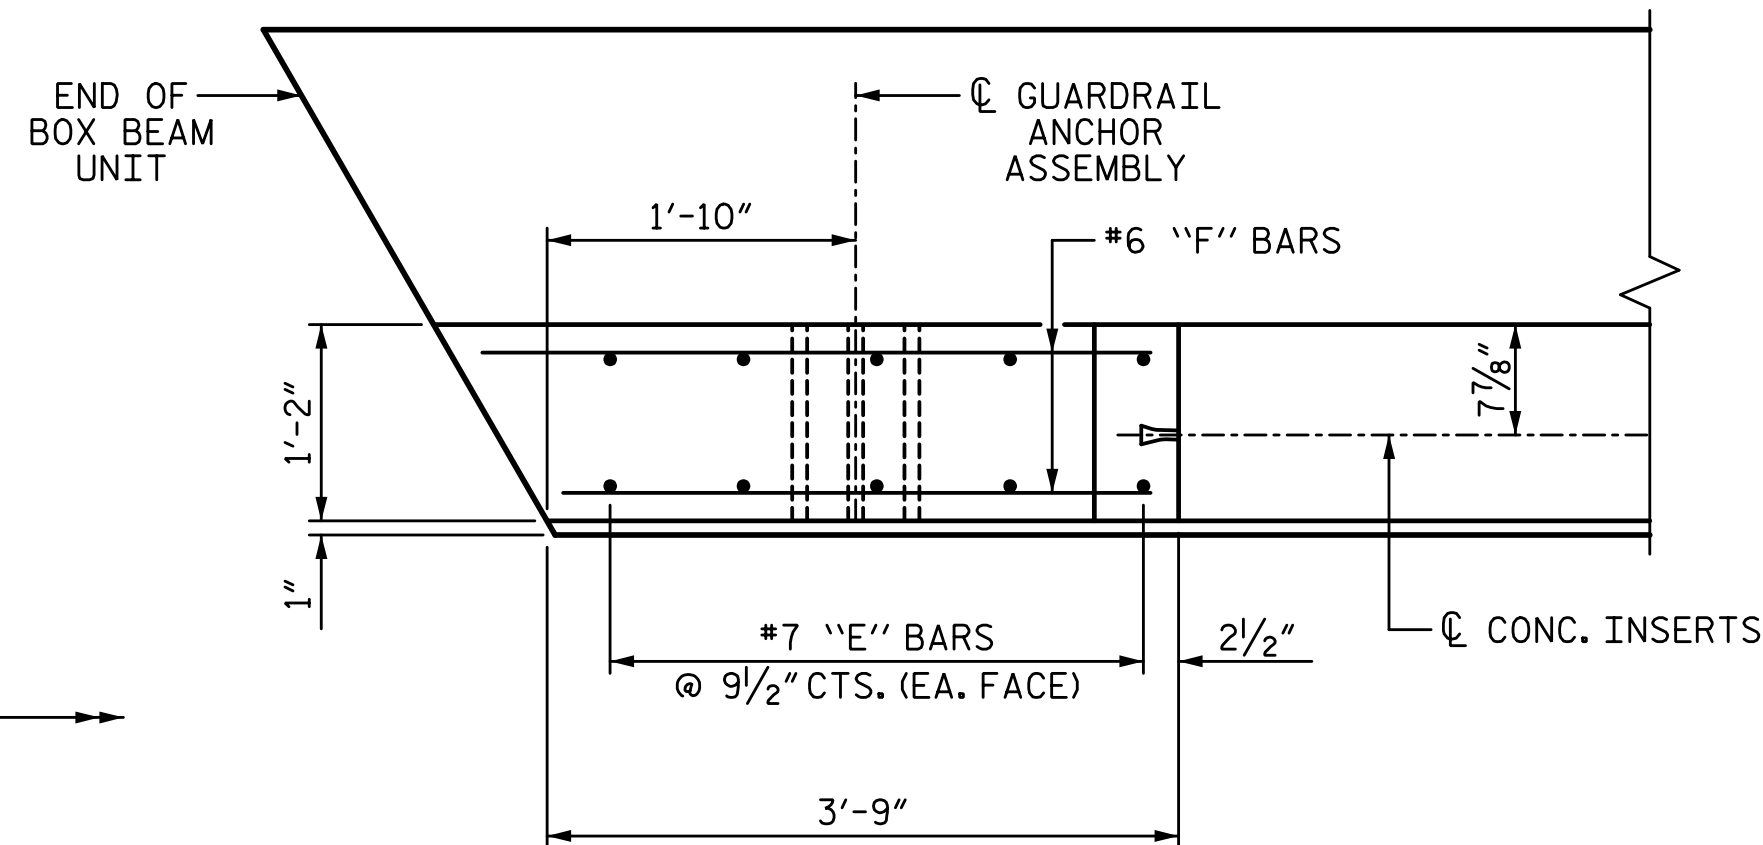

PLAN OF END POST

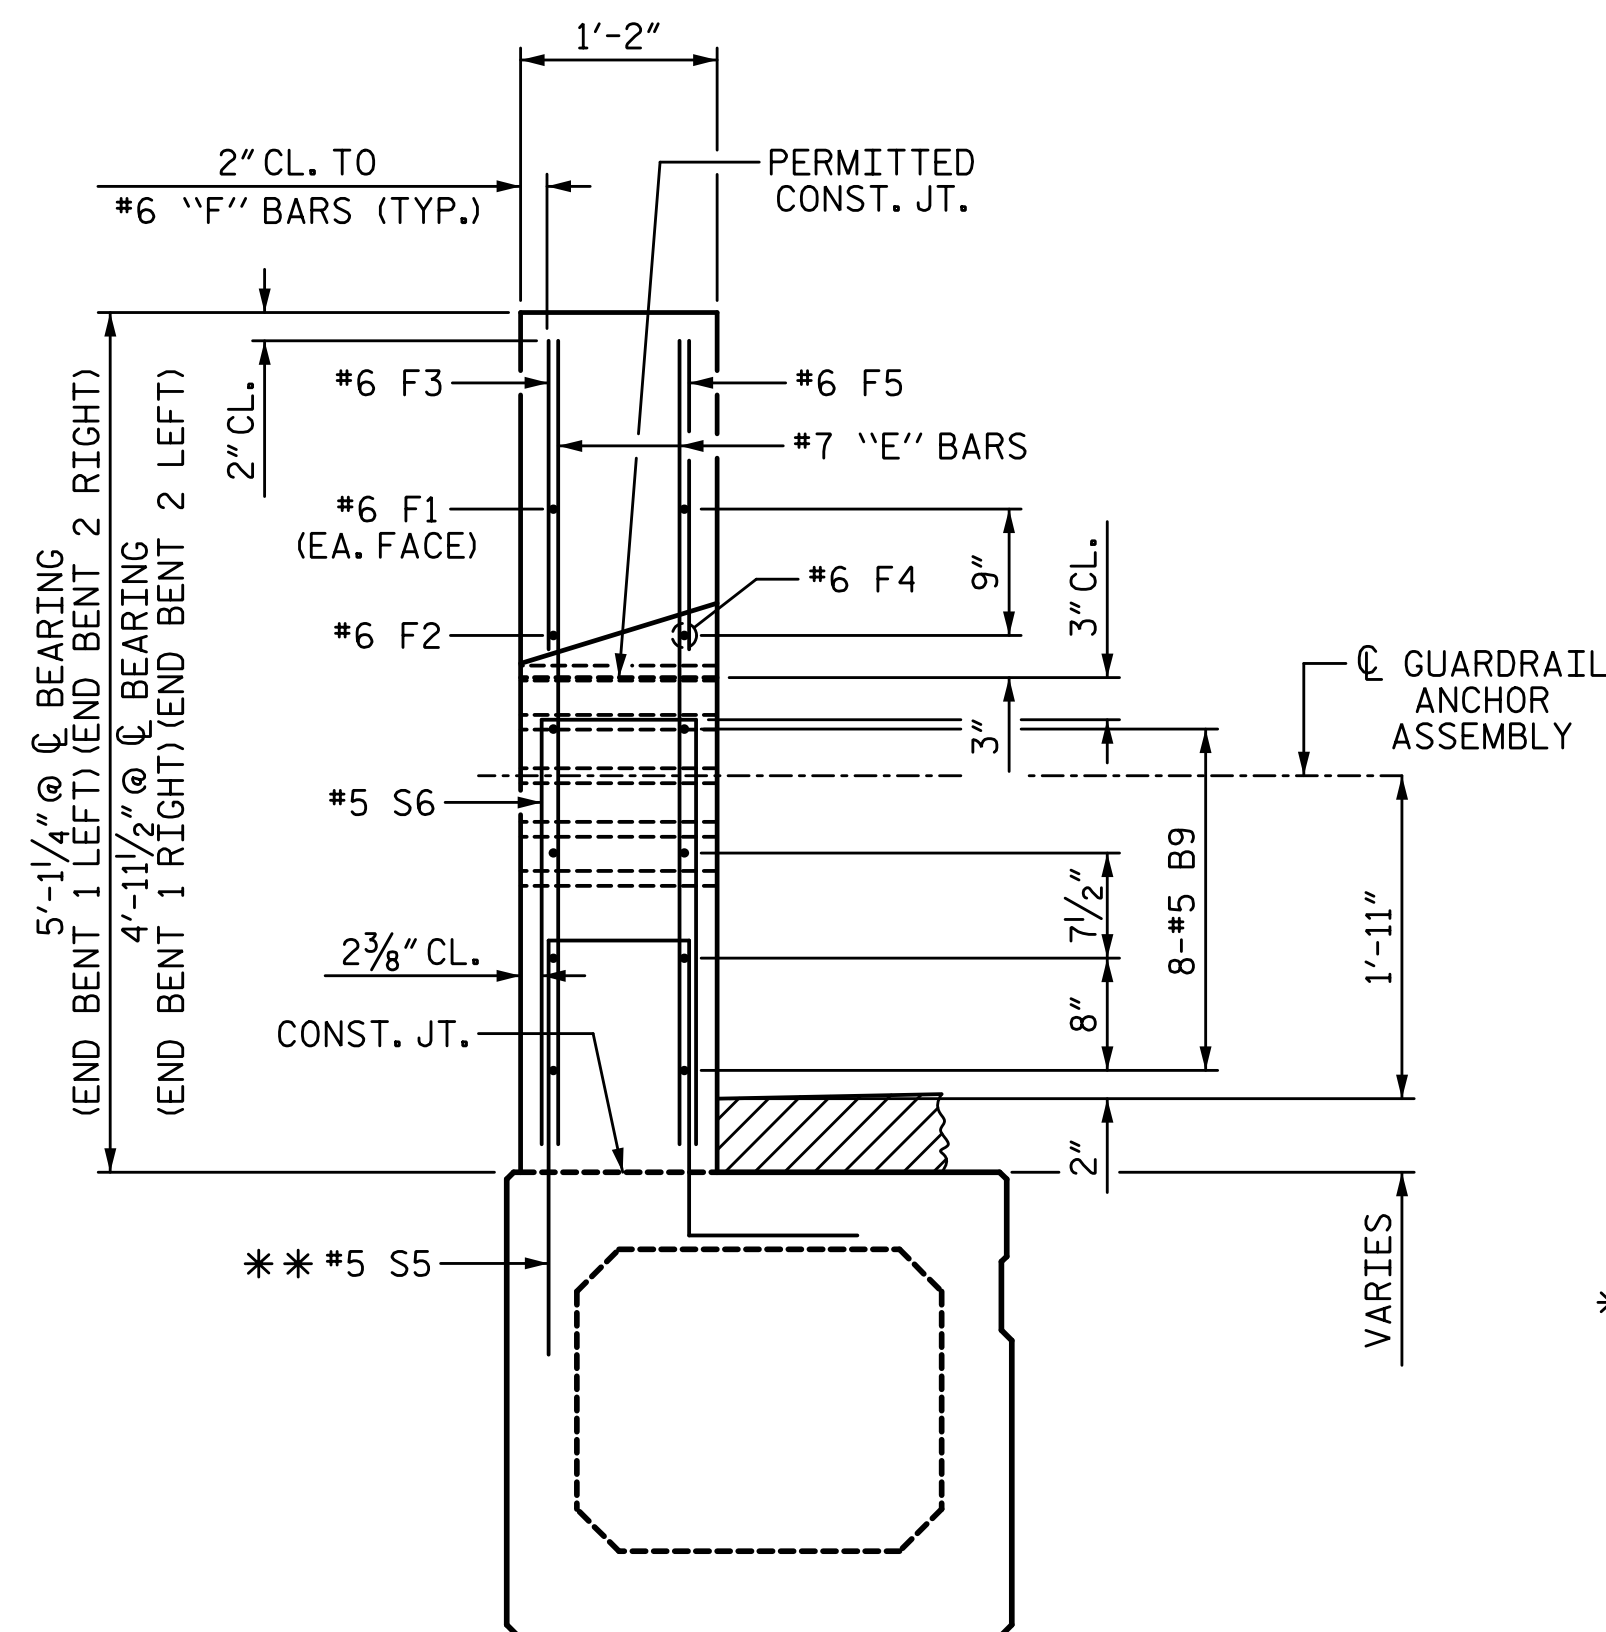


END VIEW

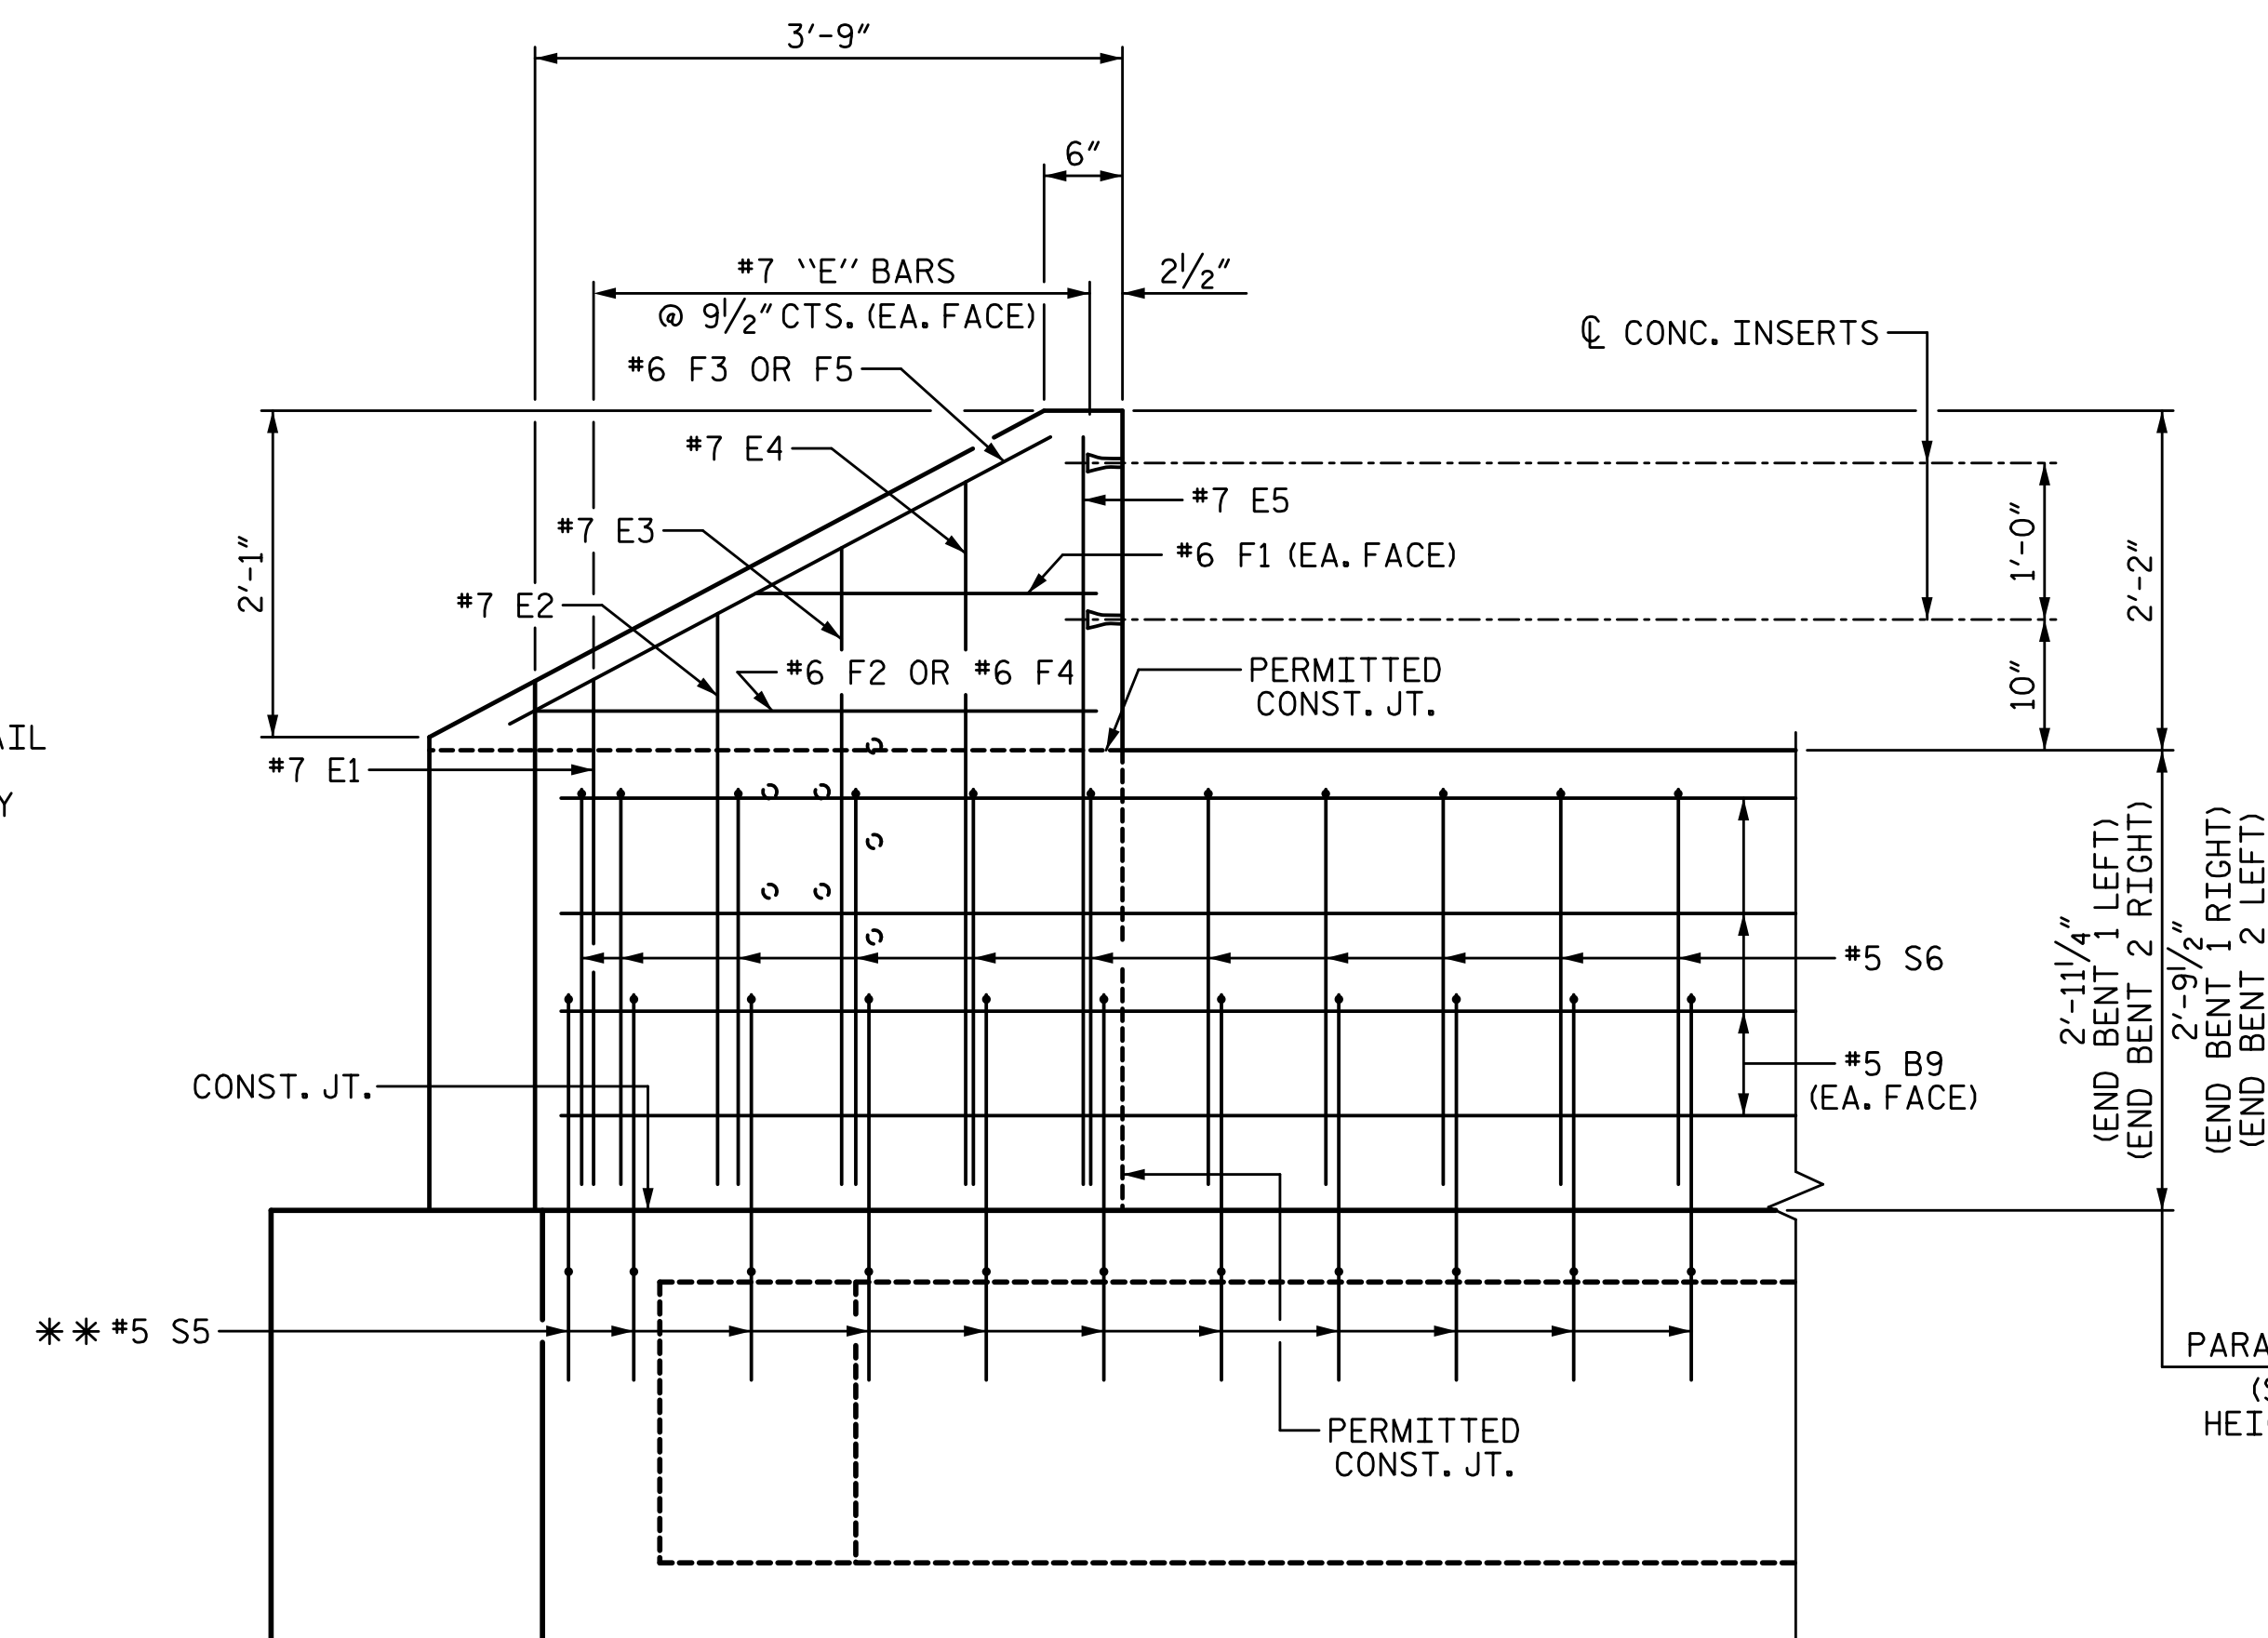


ELEVATION

④ 1/2" EXP. JT. MAT'L
HELD IN PLACE WITH
GALVANIZED NAILS.—
(NOTE: OMIT EXP. JT.
MAT'L. WHEN SLIP FORM
IS USED)

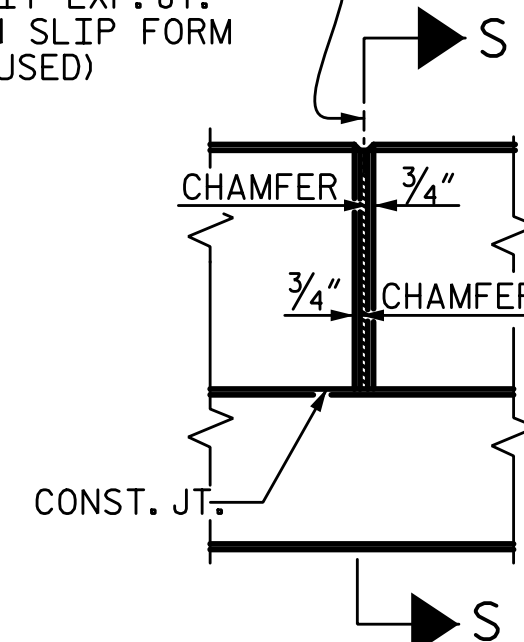

ELEVATION AT EXPANSION JOINTS

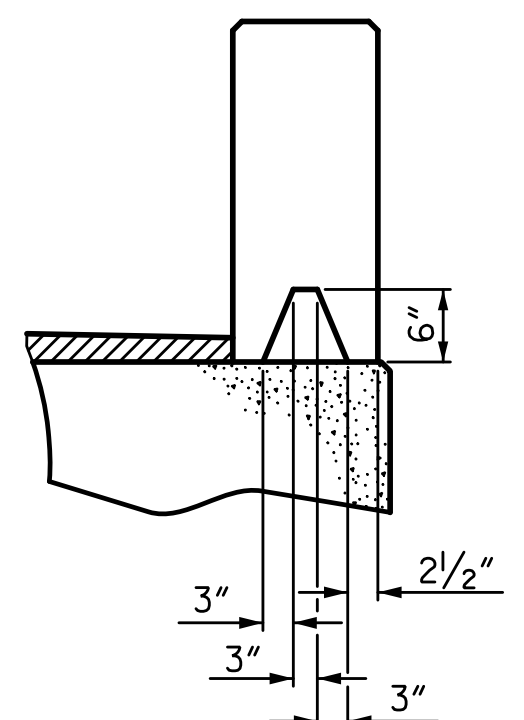

SECTION S-S

AT DAM IN OPEN JOINT
(THIS IS TO BE USED ONLY
WHEN SLIP FORM IS USED)

PARAPET AND END POST FOR TWO BAR METAL RAIL

***#5 S5 BARS ARE INCLUDED IN BILL OF MATERIAL FOR BOX BEAM

GUTTERLINE ASPHALT THICKNESS & PARAPET HEIGHT				
	ASPHALT OVERLAY THICKNESS @ MID-SPAN		PARAPET HEIGHT @ MID-SPAN	
	LEFT	RIGHT	LEFT	RIGHT
85' UNITS	2 $\frac{3}{8}$ "	2 $\frac{3}{8}$ "	2'-8 $\frac{3}{8}$ "	2'-8 $\frac{3}{8}$ "

BILL OF MATERIAL					
PARAPET AND END POSTS					
BAR	NO.	SIZE	TYPE	LENGTH	WEIGHT
* B9	96	#5	STR	15'-10"	1585
* E1	8	#7	STR	2'-11"	48
* E2	8	#7	STR	3'-5"	56
* E3	8	#7	STR	3'-11"	64
* E4	8	#7	STR	4'-5"	72
* E5	8	#7	STR	4'-9"	78
* F1	8	#6	STR	1'-11"	23
* F2	4	#6	STR	3'-2"	19
* F3	4	#6	STR	3'-6"	21
* F4	4	#6	STR	3'-8"	22
* F5	4	#6	STR	3'-10"	23
* S6	226	#5	1	5'-10"	1375
* EPOXY COATED REINFORCING STEEL					3386 LB
CLASS AA CONCRETE					21.9 CY
1'-2" X 2'-11 1/4" CONCRETE PARAPET					170.0 LF

DRAWN BY: <u>T. BANKOVICH</u>	DATE: <u>9-16</u>
CHECKED BY: <u>B.S. COX</u>	DATE: <u>9-16</u>
DESIGN ENGINEER OF RECORD: <u>B.S. COX</u>	DATE: <u>9-16</u>

PLANS PREPARED BY:

**SIMPSON
& SE ENGINEERS
& A ASSOCIATES**

5640 Dillard Drive
Suite 200
Cary, NC 27518
(919) 852-0468
(919) 852-0598 (Fax)
www.simpsonengr.com

LICENSURE NO. C-2521




PROJECT NO. 17BP.7.R.98
ORANGE COUNTY
 STATION: 13+83.50 -L-

STATE OF NORTH CAROLINA
DEPARTMENT OF TRANSPORTATION
RALEIGH
SUPERSTRUCTURE
CONCRETE PARAPET
DETAILS
FOR 2 BAR METAL RAIL

REVISIONS						SHEET NO. S-8
NO.	BY:	DATE:	NO.	BY:	DATE:	
1			3			TOTAL SHEETS 19
2			4			


**DOCUMENT NOT CONSIDERED FINAL
UNLESS ALL SIGNATURES COMPLETED**

3/29/2017 7:54:52 AM G:\Projects\2015\Division 7 (Hatch Mot)\17BP7R98 (Orange 189) (60 33BB 2BMR)\Structures\Drawings\Final\401.17BP7R98_SMJ_SUPER.dgn

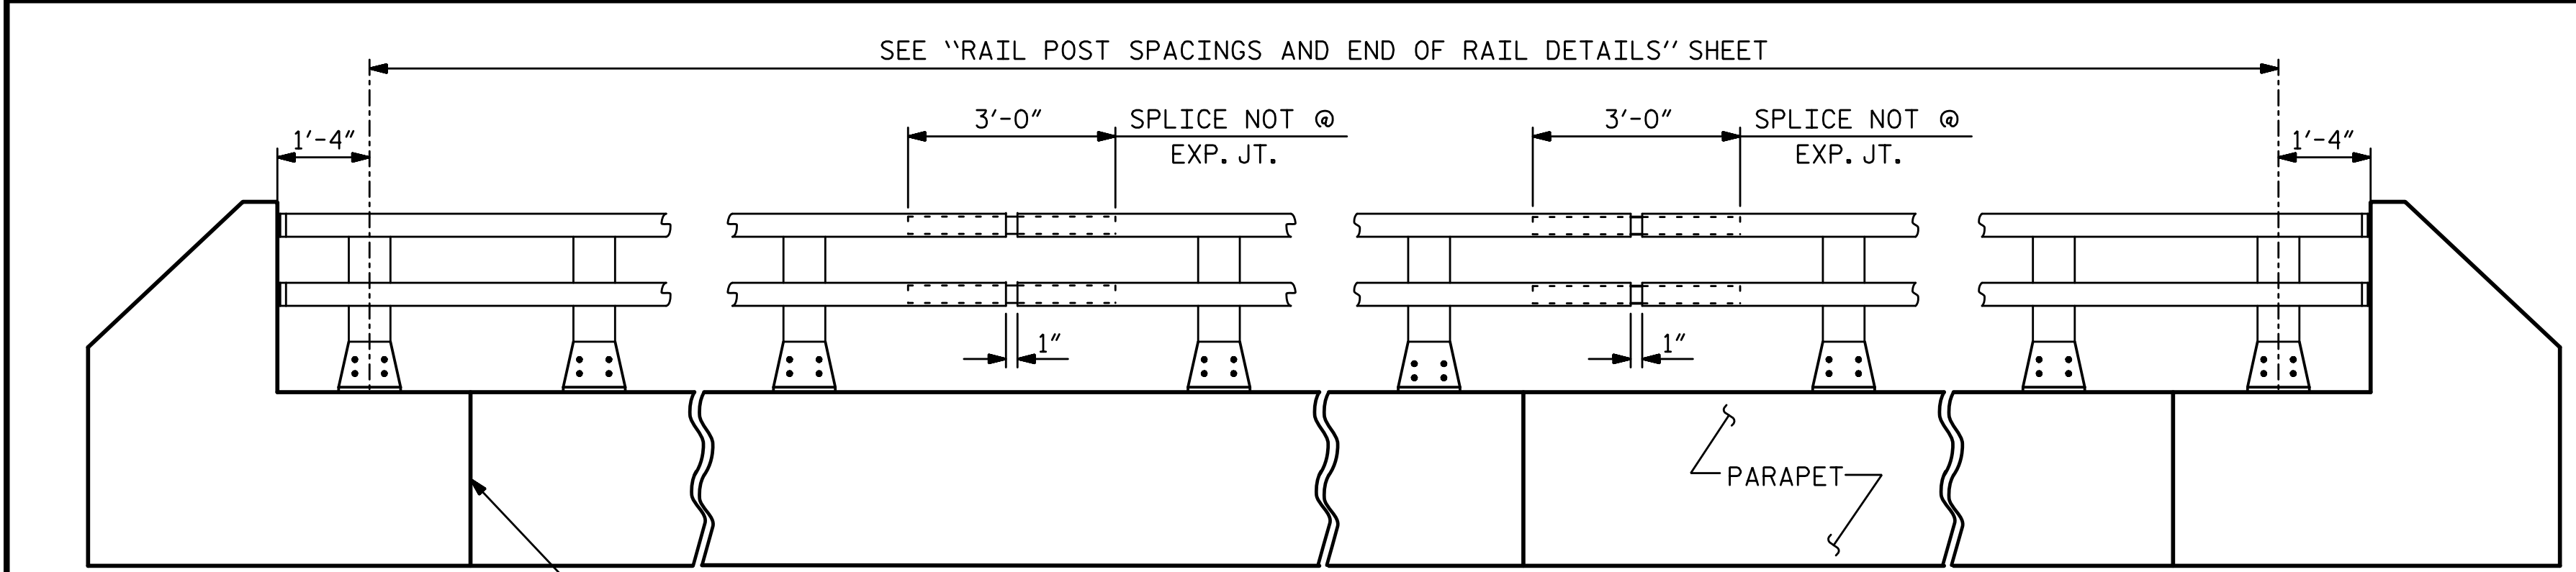


ELEVATION

NOTE : FOR ATTACHMENT OF METAL RAIL TO END POST, SEE "RAIL POST SPACING AND END OF RAIL DETAILS" SHEET.

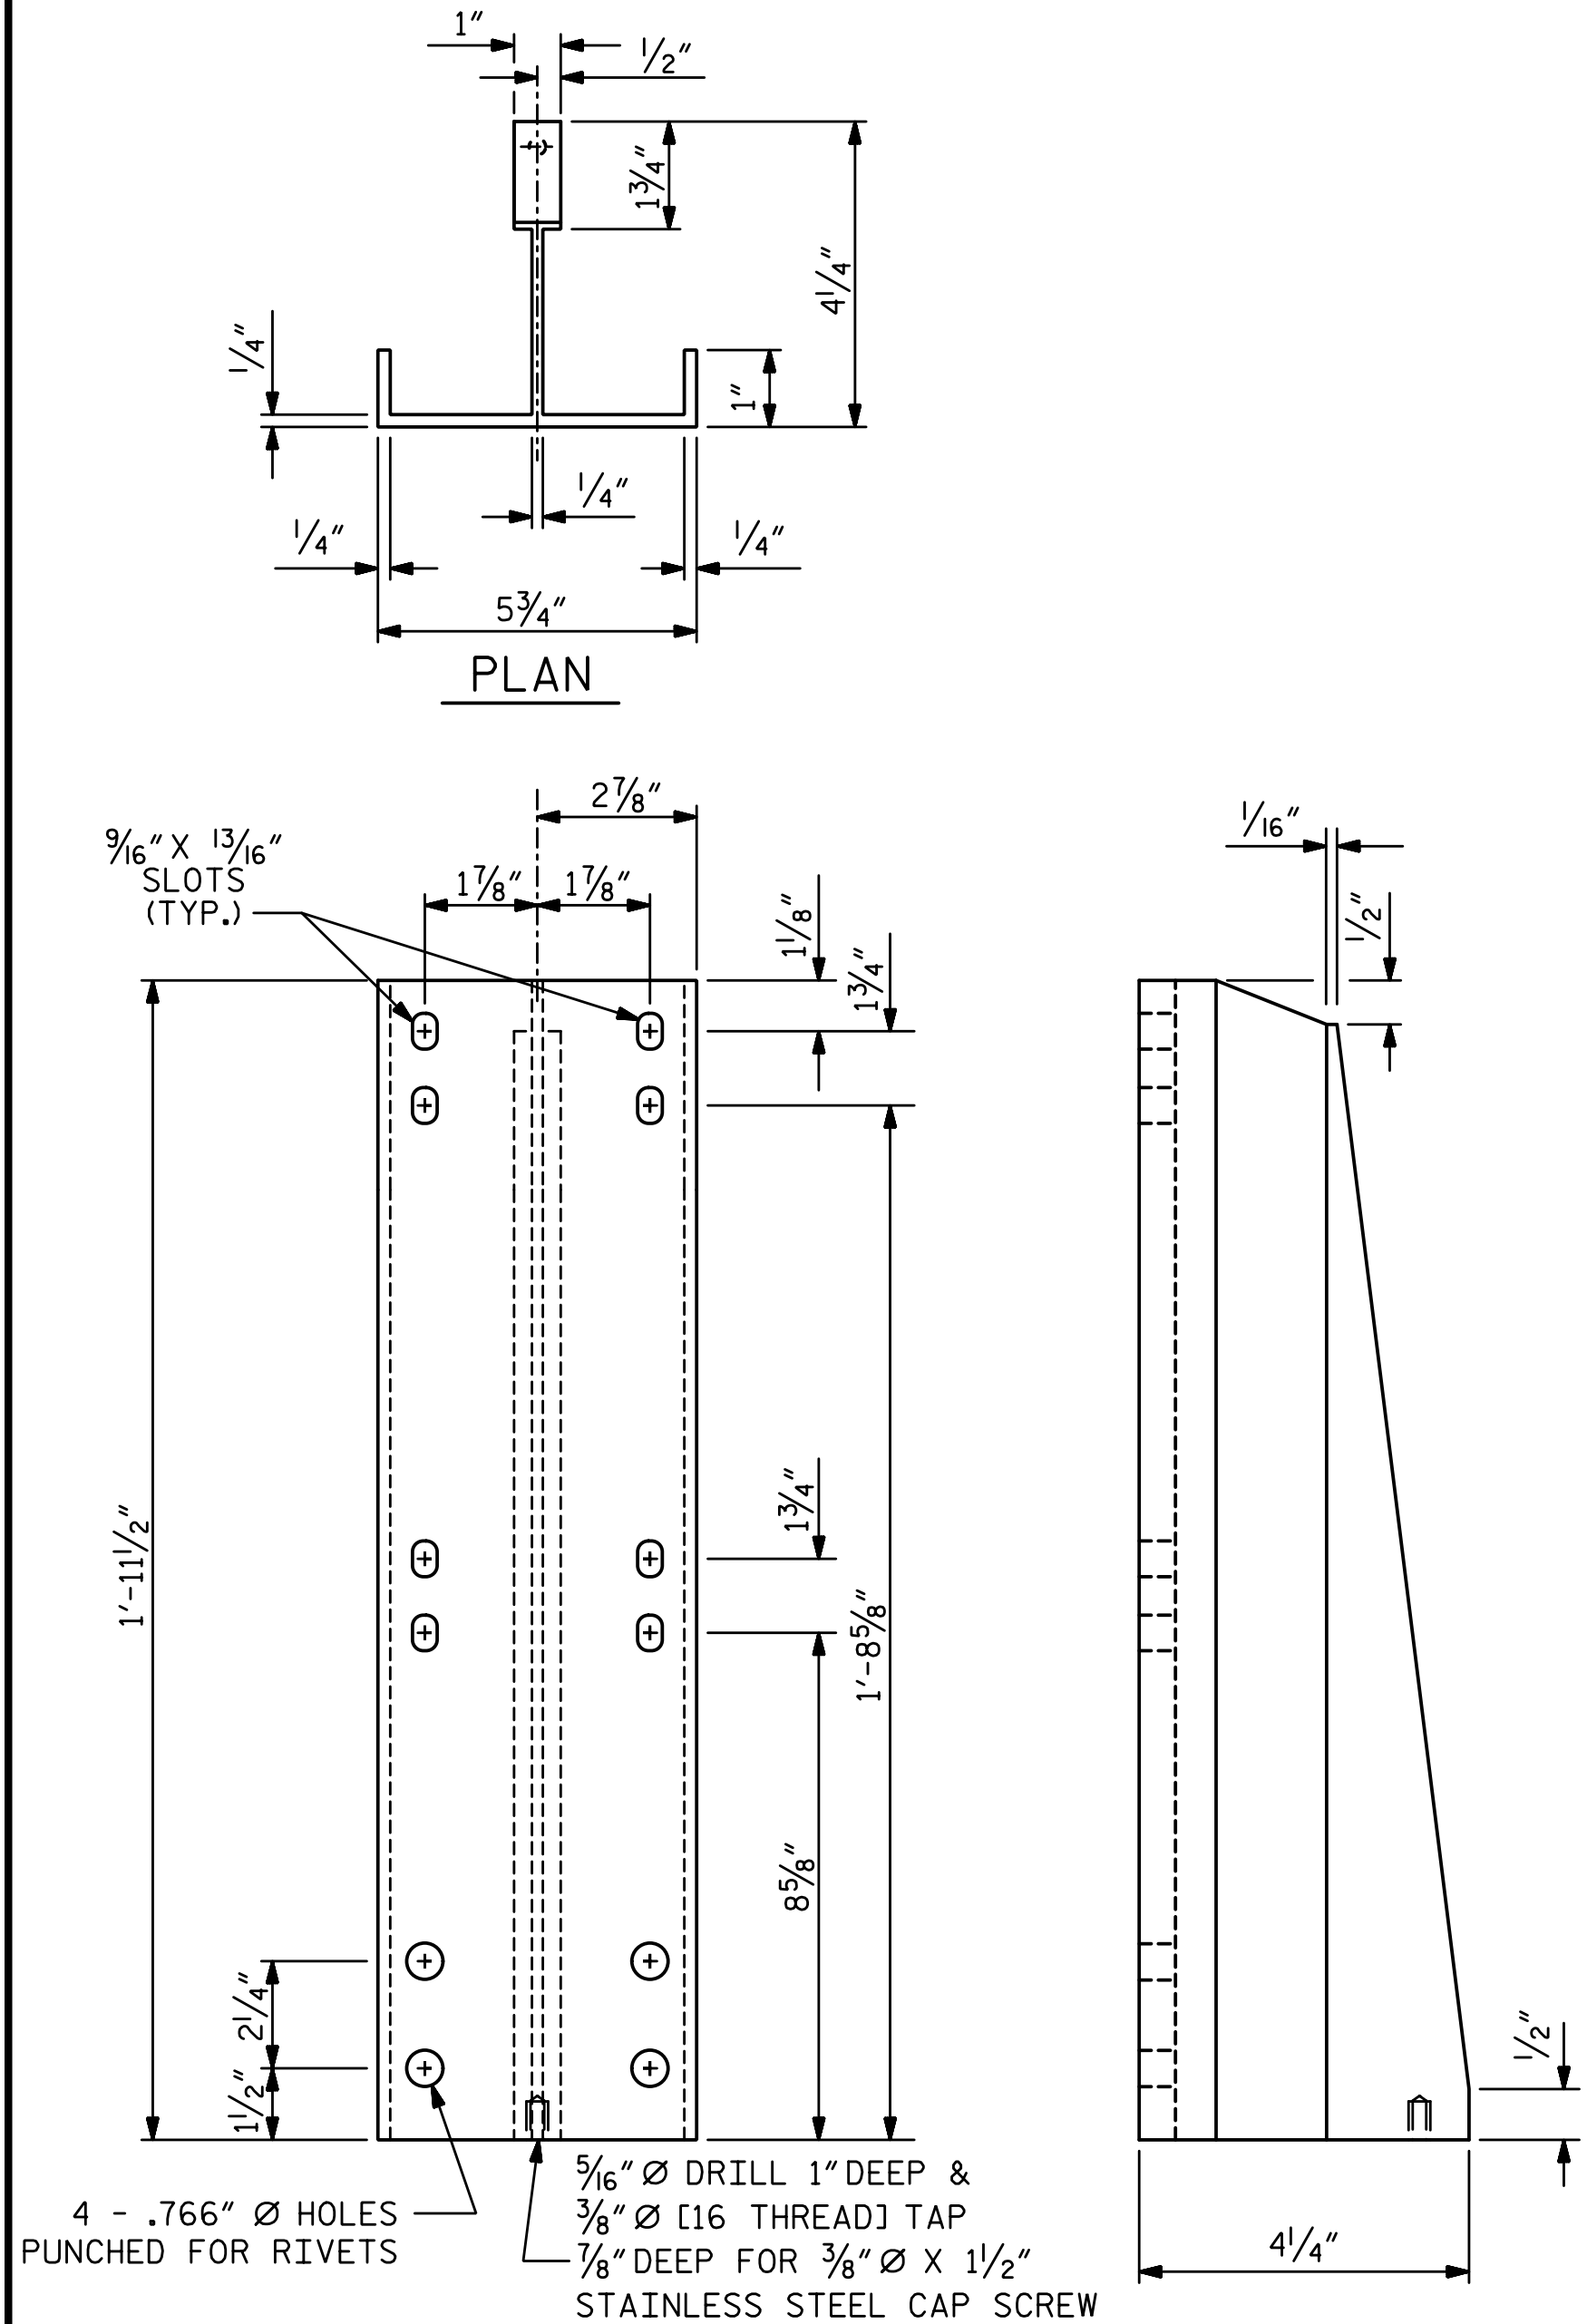


DETAILS OF POST

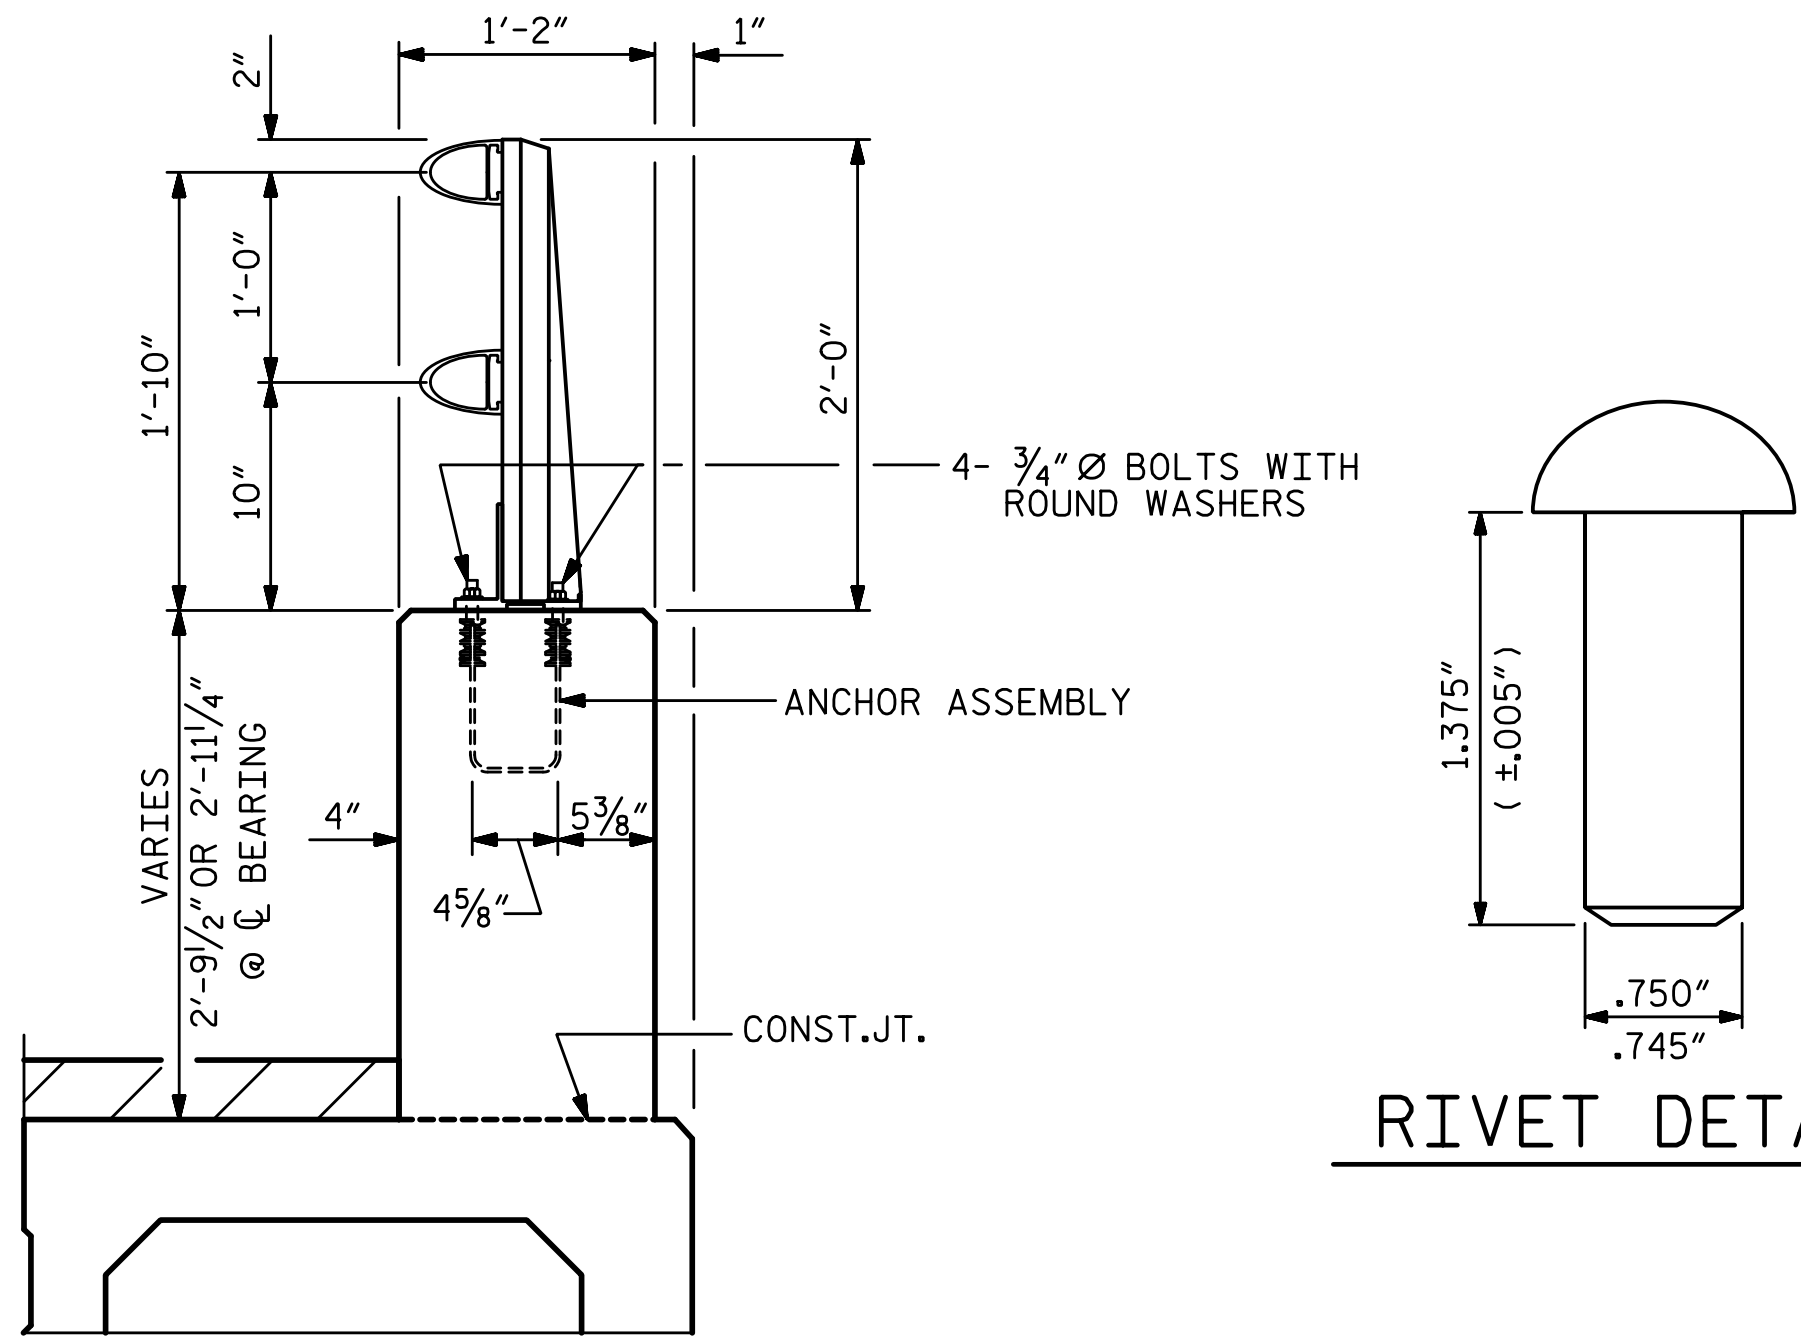


SECTION THRU PARAPET AND RAIL

RIVET DETAIL

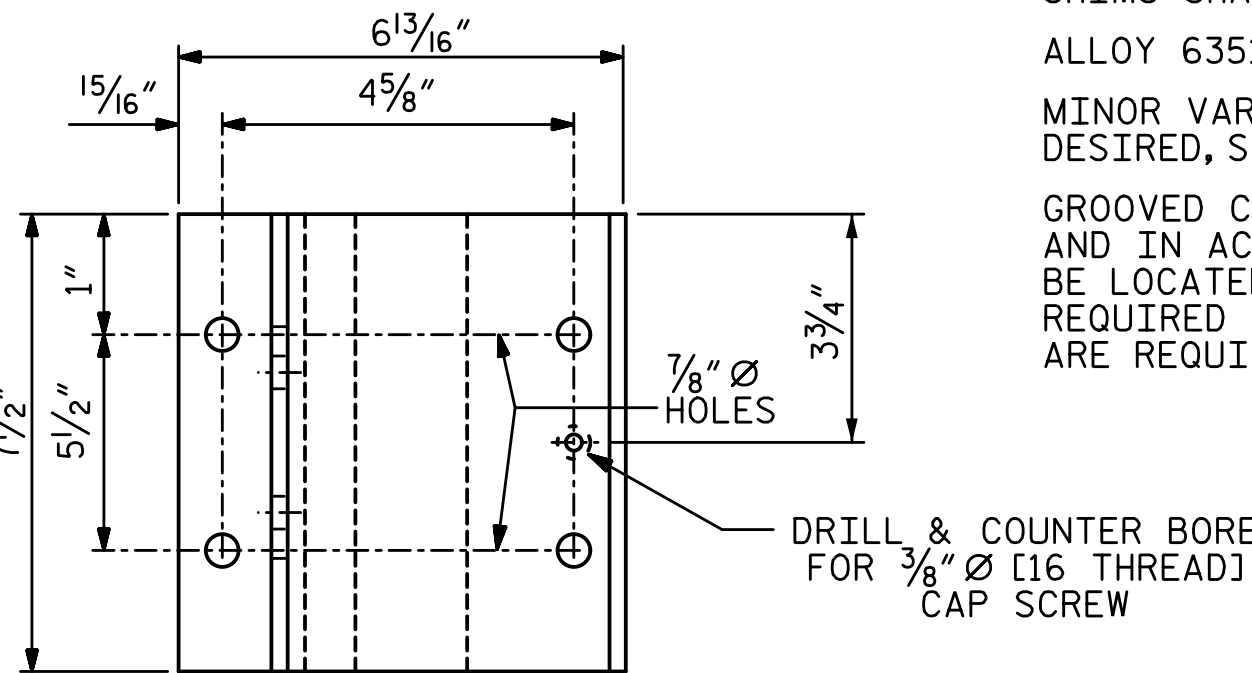

PLAN

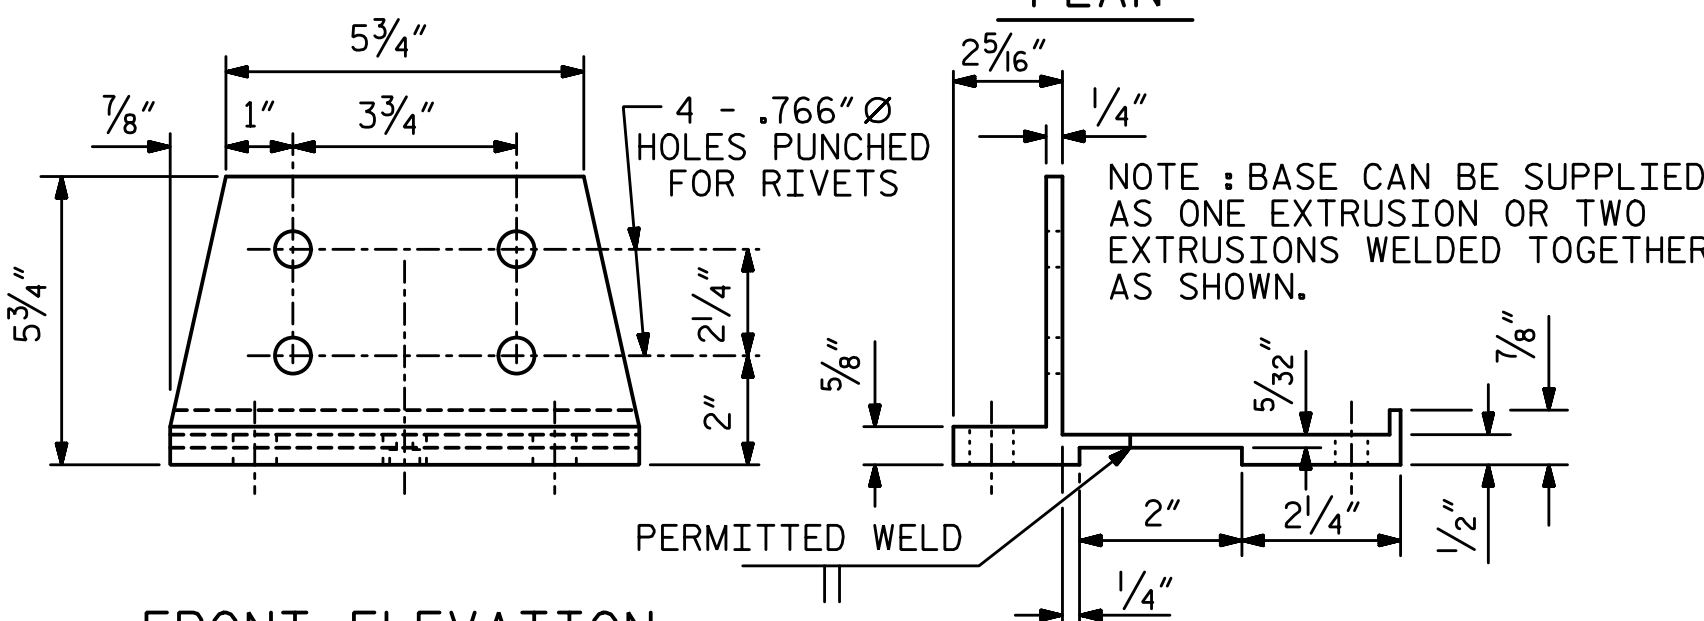

POST BASE DETAILS

NOTES:

AT THE CONTRACTOR'S OPTION, METAL RAIL MAY BE EITHER ALUMINUM OR GALVANIZED STEEL IN ACCORDANCE WITH THE REQUIREMENTS OF THE GENERAL NOTES AND THE FOLLOWING SPECIFICATIONS FOR THE ALTERNATE MATERIALS; HOWEVER, THE CONTRACTOR WILL BE REQUIRED TO USE THE SAME RAIL MATERIAL ON ALL STRUCTURES ON THE PROJECT FOR WHICH METAL RAIL IS DESIGNATED.

UNLESS OTHERWISE REQUIRED IN THE CONTRACT DOCUMENTS, THE CONTRACTOR HAS THE OPTION TO USE AN ALTERNATE TO THE 2 BAR METAL RAIL. THE ALTERNATE RAIL SHALL MEET THE REQUIREMENTS OF THE AASHTO LRFD BRIDGE DESIGN SPECIFICATIONS AND MUST BE LISTED ON THE DEPARTMENT'S APPROVED PRODUCTS LIST (APL) UNDER "2 BAR METAL RAIL ALTERNATE". ADJUSTMENTS TO THE CONCRETE PARAPET WILL NOT BE ALLOWED.

ALUMINUM RAILS:

MATERIAL FOR POSTS, BASES AND RAILS, EXPANSION BARS AND CLAMP BARS SHALL BE ASTM B-221 ALLOY 6061-T6. MATERIAL FOR RIVETS SHALL BE ASTM B316 ALLOY 6061-T6. RIVETS SHALL BE STANDARD BUTTON HEAD AND CONE POINT COLD DRIVEN AS PER DRAWING.

THE BASE OF RAIL POSTS, OR ANY OTHER ALUMINUM SURFACE IN CONTACT WITH CONCRETE SHALL BE THOROUGHLY COATED WITH AN ALUMINUM IMPREGNATED CAULKING COMPOUND OF APPROVED QUALITY.

MATERIAL FOR SHIMS TO BE ASTM B209 ALLOY 6061-T6.

GALVANIZED STEEL RAILS:

MATERIAL AND GALVANIZING ARE TO CONFORM TO THE FOLLOWING SPECIFICATIONS:

POST, POST BASES, RAILS, EXPANSION BARS AND CLAMP BARS: AASHTO M270 GRADE 36 STRUCTURAL STEEL - GALVANIZED TO AASHTO M111.

RIVETS: RIVETS SHALL MEET THE REQUIREMENTS OF ASTM A502 FOR GRADE 1 RIVETS.

THE CUT ENDS OF GALVANIZED STEEL RAILING, AFTER GRINDING SMOOTH SHALL BE GIVEN TWO COATS OF ZINC RICH PAINT MEETING THE REQUIREMENTS OF FEDERAL SPECIFICATION MIL-P-26915 USAF TYPE 1, OR OF FEDERAL SPECIFICATIONS TT-P-641.

SHIMS: SHIMS SHALL MEET THE REQUIREMENTS OF ASTM A570 FOR GRADE 33 OR A611 FOR GRADE C AND SHALL BE GALVANIZED IN ACCORDANCE WITH AASHTO M111.

RAIL CAPS: RAIL CAPS SHALL MEET THE REQUIREMENTS OF ASTM A570 FOR GRADE 33 OR A611 FOR GRADE C AND SHALL BE GALVANIZED IN ACCORDANCE WITH AASHTO M111.

GENERAL NOTES:

RAILING SHALL BE CONTINUOUS FROM END POST TO END POST OF BRIDGE. EACH JOINT IN RAIL LENGTH SHALL BE SPLICED AS DETAILED. PANEL LENGTHS OF RAIL SHALL BE ATTACHED TO A MINIMUM OF THREE POSTS.

FOR END OF RAIL TO CLEAR FACE OF CONCRETE END POST DIMENSION, SEE "RAIL POST SPACING AND END OF RAIL DETAILS" SHEET.

CAP SCREWS SHALL BE ASTM F593 ALLOY 305 STAINLESS STEEL. WASHERS SHALL MEET THE REQUIREMENTS OF ASTM F844 EXCEPT THEY SHALL BE MADE FROM ALLOY 304 STAINLESS STEEL.

CERTIFIED MILL REPORTS ARE REQUIRED FOR RAILS AND POSTS. SHOP INSPECTION IS NOT REQUIRED.

METAL RAIL POSTS SHALL BE SET NORMAL TO CURB GRADE.

METHOD OF MEASUREMENT FOR METAL RAILS: FOR LENGTH OF METAL RAILS TO BE PAID FOR, SEE THE STANDARD SPECIFICATIONS.

CURVED RAIL USAGE: WHERE RAILS ARE TO BE USED ON BRIDGES ON HORIZONTAL AND/OR VERTICAL CURVATURE THE CONTRACTOR MAY, AT HIS OPTION, HAVE THE REQUIRED CURVATURE IN THE RAIL FORMED IN THE SHOP OR IN THE FIELD. IN EITHER EVENT, THE RAIL SHALL CONFORM WITHOUT BUCKLING OR KINKING TO THE REQUIRED CURVATURE IN A UNIFORM MANNER ACCEPTABLE TO THE ENGINEER.

TO INSURE FUTURE IDENTIFICATION OF THE FABRICATOR, A PERMANENT IDENTIFYING MARK SHALL BE PLACED ON EACH POST. THE METHOD OF MARKING AND LOCATION SHALL BE SUCH THAT IT DOES NOT DETRACT FROM THE APPEARANCE OF THE POST, BUT REMAINS VISIBLE AFTER RAIL PLACEMENT.

SHIMS SHALL BE USED AS NECESSARY FOR POST ALIGNMENT.

ALLOY 6351-T5 MAY BE SUBSTITUTED FOR ALLOY 6061-T6 WHERE APPLICABLE.

MINOR VARIATIONS IN DETAILS OF METAL RAIL WILL BE CONSIDERED. DETAILS OF SUCH VARIATIONS, IF DESIRED, SHALL BE SUBMITTED FOR APPROVAL.

GROOVED CONTRACTION JOINTS, 1/2" IN DEPTH, SHALL BE TOOLED IN ALL EXPOSED FACES OF THE PARAPET AND IN ACCORDANCE WITH ARTICLE 825-10(B) OF THE STANDARD SPECIFICATIONS. A CONTRACTION JOINT SHALL BE LOCATED AT EACH THIRD POINT BETWEEN PARAPET EXPANSION JOINTS. ONLY ONE CONTRACTION JOINT IS REQUIRED AT MIDPOINT OF PARAPET SEGMENTS LESS THAN 20 FEET IN LENGTH AND NO CONTRACTION JOINTS ARE REQUIRED FOR THOSE SEGMENTS LESS THAN 10 FEET IN LENGTH.

PAY LENGTH = 153.66 LF

PROJECT NO. 17BP.7.R.98
ORANGE COUNTY
STATION: 13+83.50 -L-

SHEET 1 OF 2


REVISIONS						SHEET NO.
NO.	BY:	DATE:	NO.	BY:	DATE:	
1			3			S-9
2			4			

STATE OF NORTH CAROLINA
DEPARTMENT OF TRANSPORTATION
RALEIGH
SUPERSTRUCTURE
2 BAR METAL RAIL

TOTAL SHEETS
19


PLANS PREPARED BY:

SIMPSON
ENGINEERS
& ASSOCIATES
5640 Dillard Drive
Suite 200
Cary, NC 27518
(919) 852-0468
(919) 852-0598 (Fax)
www.simpsonengr.com
LICENSURE NO. C-2521

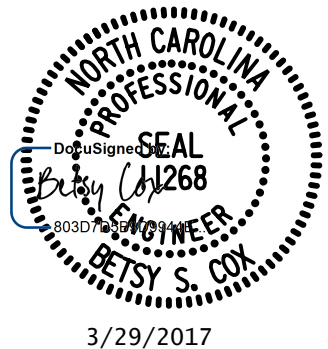

DOCUMENT NOT CONSIDERED FINAL
UNLESS ALL SIGNATURES COMPLETED

3/29/2017 7:54:53 AM G:\Projects\2015\Division 7 (Hatch Mot+T)\17BP7R98 (Orange 189) (60 33BB 2BMR)\Structures\Drawings\Final\401.17BP7R98_SMJ_SUPER.dgn

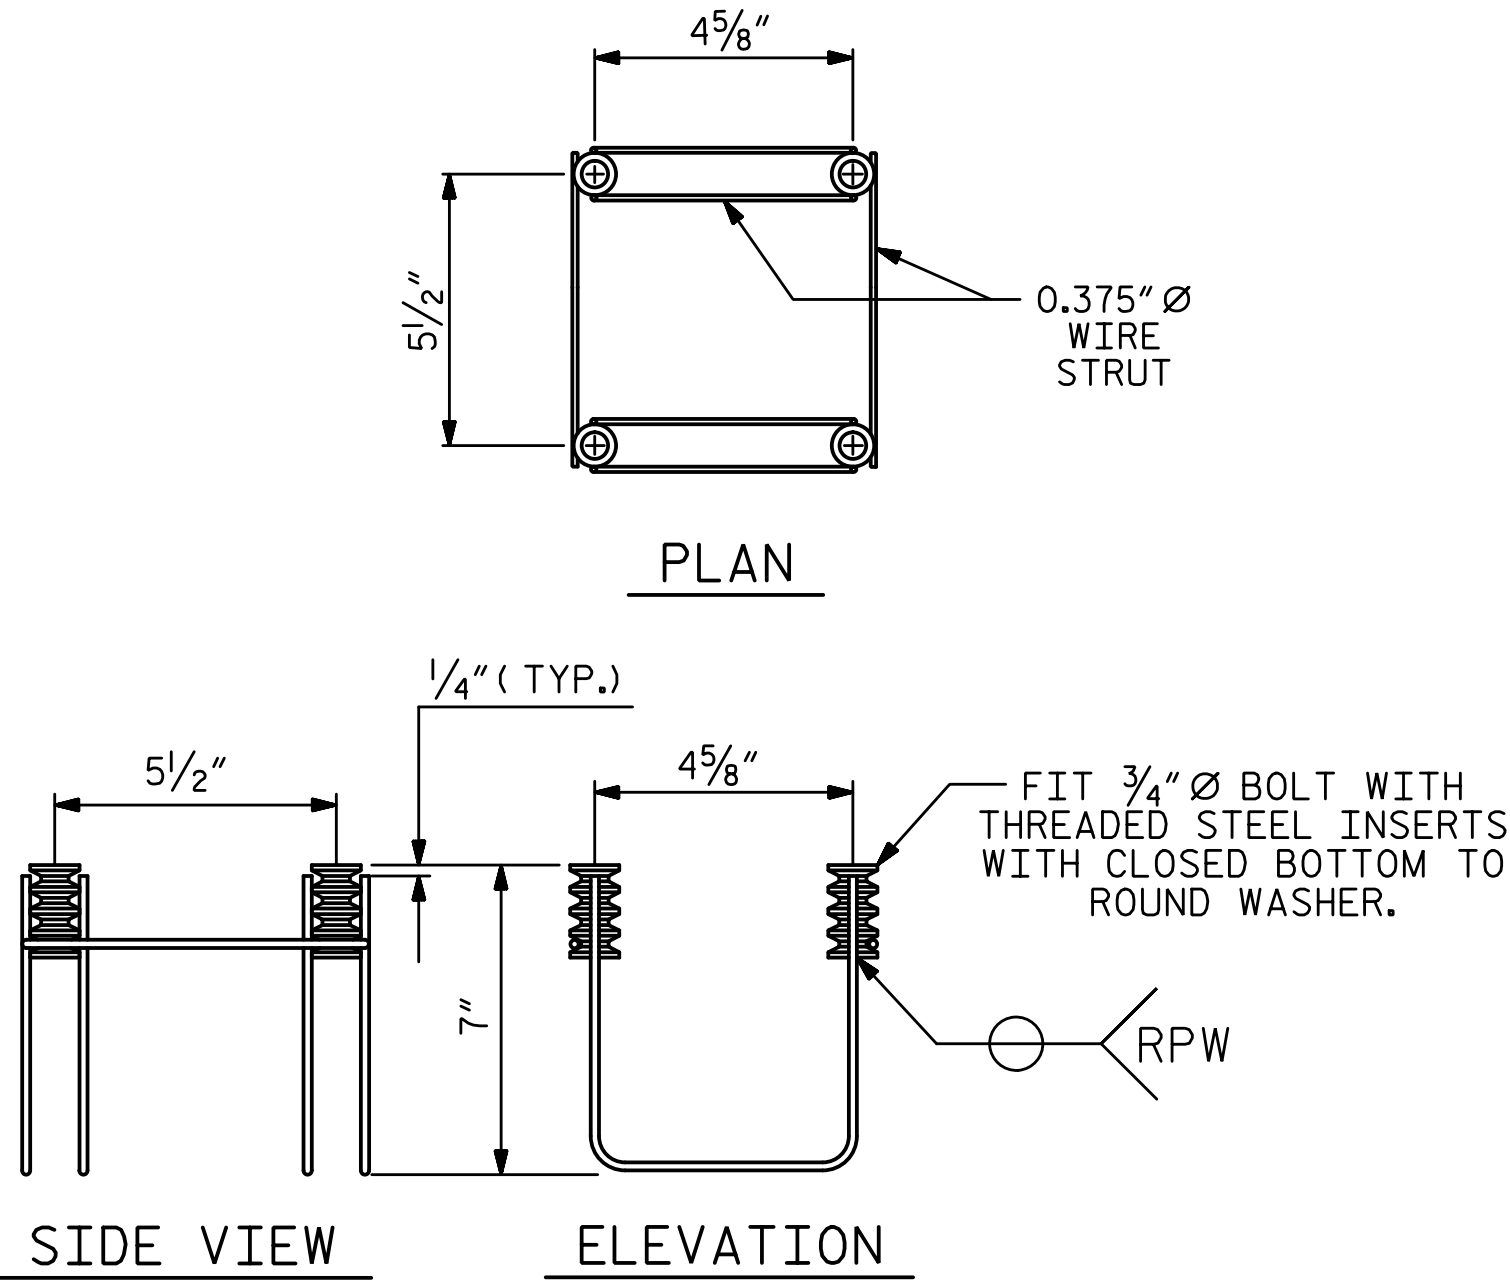

4-BOLT METAL RAIL ANCHOR ASSEMBLY

(34 ASSEMBLIES REQUIRED)


STRUCTURAL CONCRETE ANCHOR ASSEMBLY NOTES:

THE STRUCTURAL CONCRETE ANCHOR ASSEMBLY SHALL CONSIST OF THE FOLLOWING COMPONENTS :


- A. FERRULES SHALL BE MADE FROM STEEL MEETING THE REQUIREMENTS OF AASHTO M169, GRADE 12L14 AND SHALL HAVE A MINIMUM LENGTH OF THREADS OF 2" FOR 3/4" FERRULES.
- B. 4 - 3/4" Ø X 2 1/2" BOLTS WITH WASHERS. BOLTS SHALL CONFORM TO THE REQUIREMENTS OF ASTM A307. BOLTS AND WASHERS SHALL BE GALVANIZED. AT THE CONTRACTOR'S OPTION, STAINLESS STEEL BOLTS AND WASHERS MAY BE USED AS AN ALTERNATE FOR THE 3/4" Ø X 2 1/2" GALVANIZED BOLTS AND WASHERS. THEY SHALL CONFORM TO OR EXCEED THE MECHANICAL REQUIREMENTS OF ASTM A307. THE USE OF THIS ALTERNATE SHALL BE APPROVED BY THE ENGINEER.
- C. WIRE STRUT SHOWN IN THE CONCRETE ANCHOR ASSEMBLY DETAIL IS THE MINIMUM ALLOWABLE SIZE AND SHALL HAVE A MINIMUM TENSILE STRENGTH OF 100,000 PSI. AS AN OPTION, A 1/16" Ø WIRE STRUT WITH A MINIMUM TENSILE STRENGTH OF 90,000 PSI IS ACCEPTABLE.
- D. THE METAL RAIL ANCHOR ASSEMBLIES TO BE HOT DIPPED GALVANIZED TO CONFORM TO REQUIREMENTS OF AASHTO M111.
- E. THE COST OF THE METAL RAIL ANCHOR ASSEMBLY WITH BOLTS AND WASHERS COMPLETE IN PLACE SHALL BE INCLUDED IN THE PRICE BID FOR LINEAR FEET OF METAL RAIL.
- F. BOLTS TO BE TIGHTENED ONE-HALF TURN WITH A WRENCH FROM A FINGER-TIGHT POSITION.

THE CONTRACTOR MAY USE ADHESIVELY ANCHORED ANCHOR BOLTS IN PLACE OF THE METAL RAIL ANCHOR ASSEMBLY. LEVEL ONE FIELD TESTING IS REQUIRED, AND THE YIELD LOAD OF THE 3/4" Ø BOLT IS 10 KIPS. FOR ADHESIVELY ANCHORED ANCHOR BOLTS OR DOWELS, SEE THE STANDARD SPECIFICATIONS.

WHEN ADHESIVELY ANCHORED ANCHOR BOLTS ARE USED, BOLTS SHALL MEET THE REQUIREMENTS OF ASTM F593 ALLOY 304 STAINLESS STEEL WITH MINIMUM 75,000 PSI ULTIMATE STRENGTH. NUTS SHALL MEET THE REQUIREMENTS OF ASTM F594 ALLOY 304 STAINLESS STEEL AND WASHERS SHALL MEET THE REQUIREMENTS OF ASTM F844 EXCEPT THEY SHALL BE MADE FROM ALLOY 304 STAINLESS STEEL.

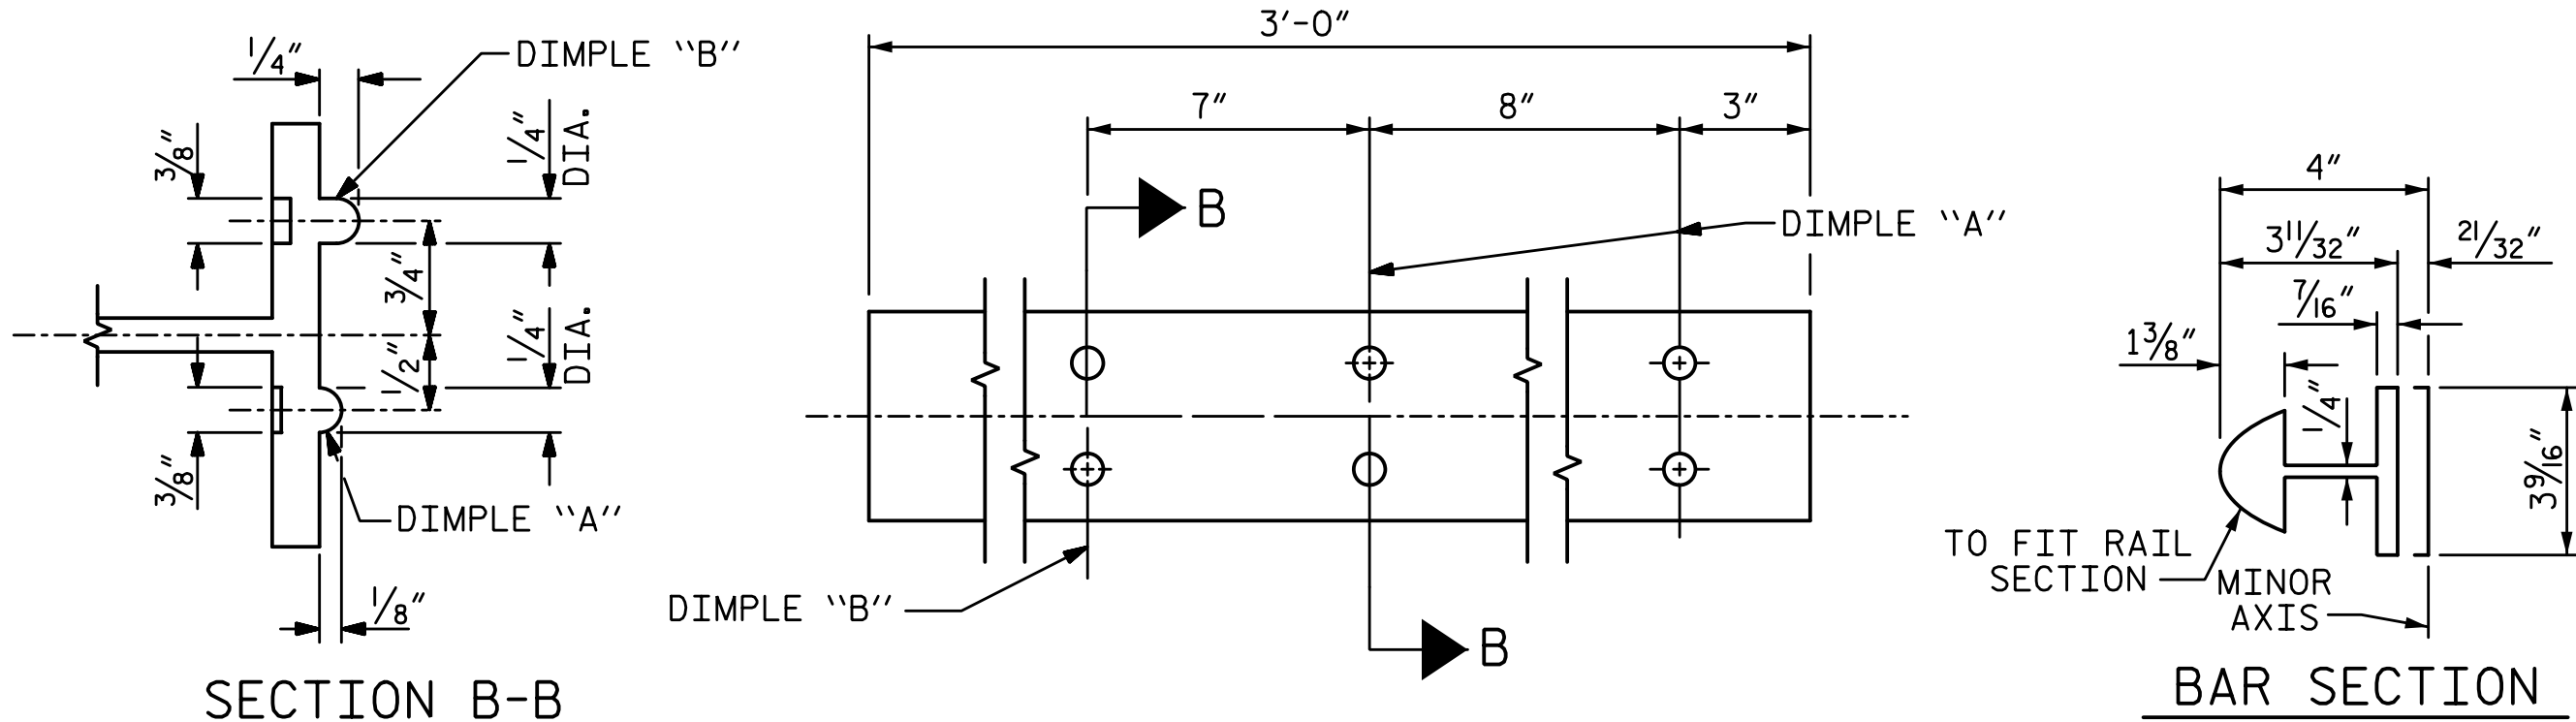


EXPANSION BAR DETAILS

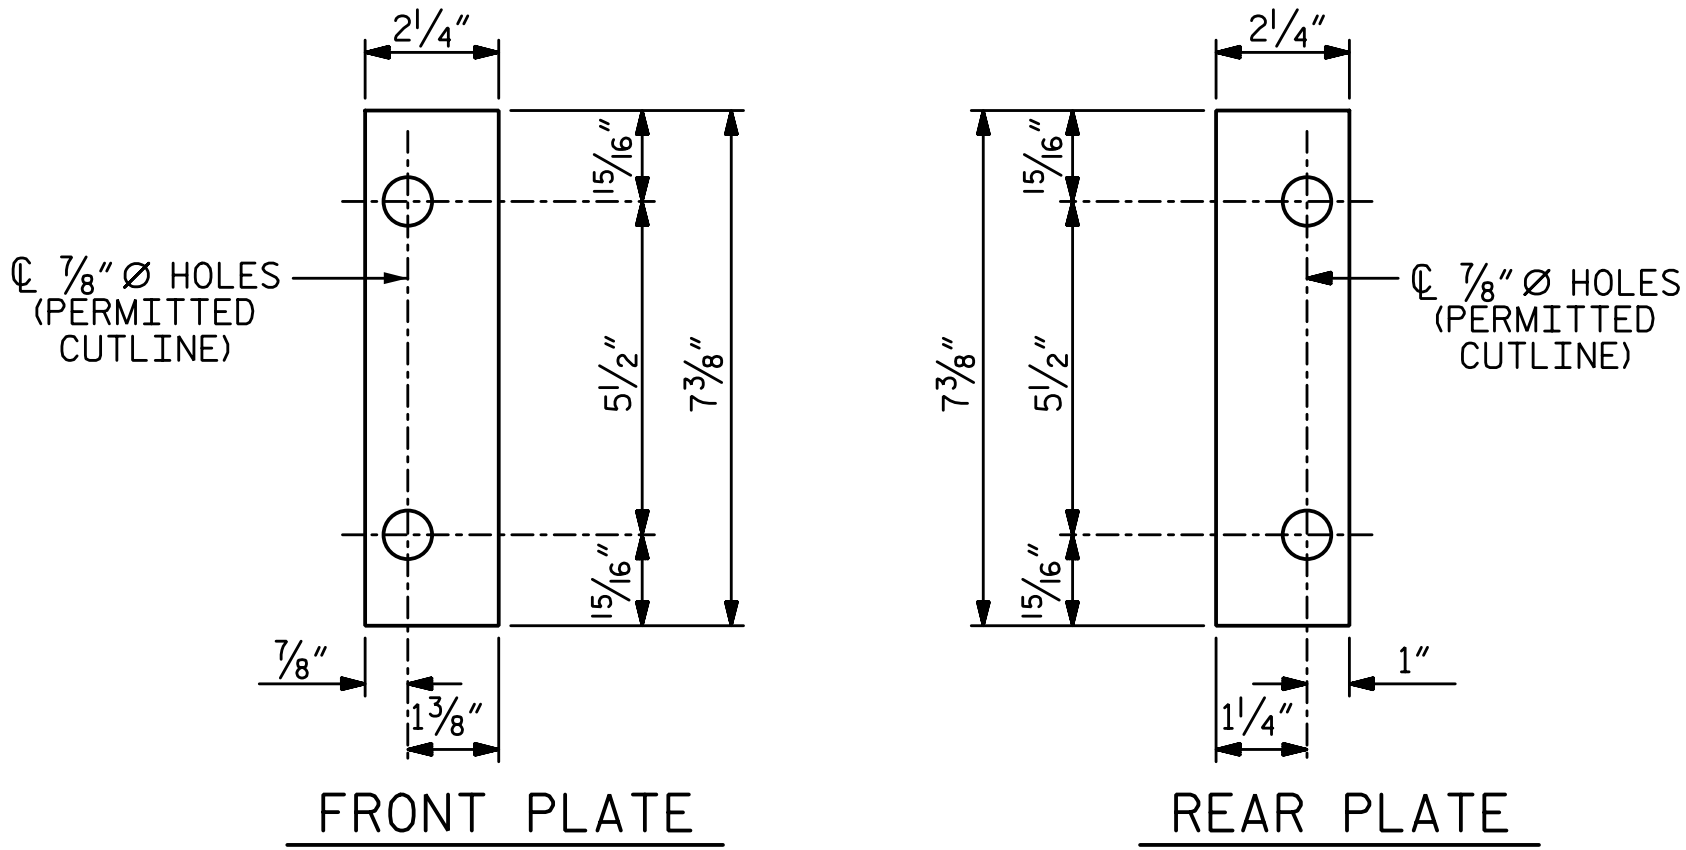


SHIM DETAILS

NOTE : SHIMS MAY BE CUT ALONG PERMITTED CUTLINE OR SLOTTED TO EDGE OF PLATE TO FACILITATE PLACEMENT.

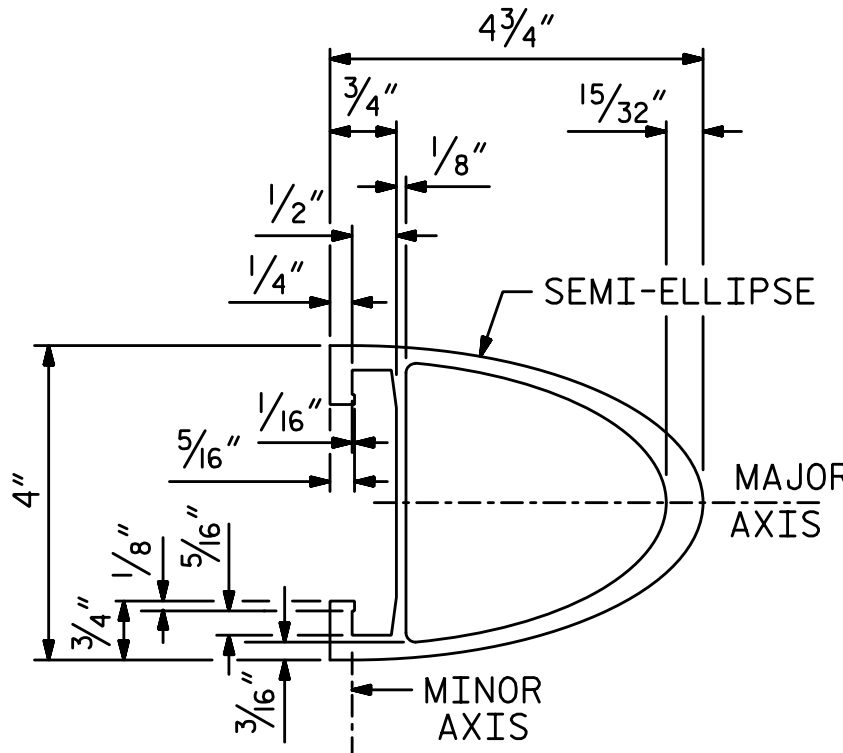


RAIL SECTION

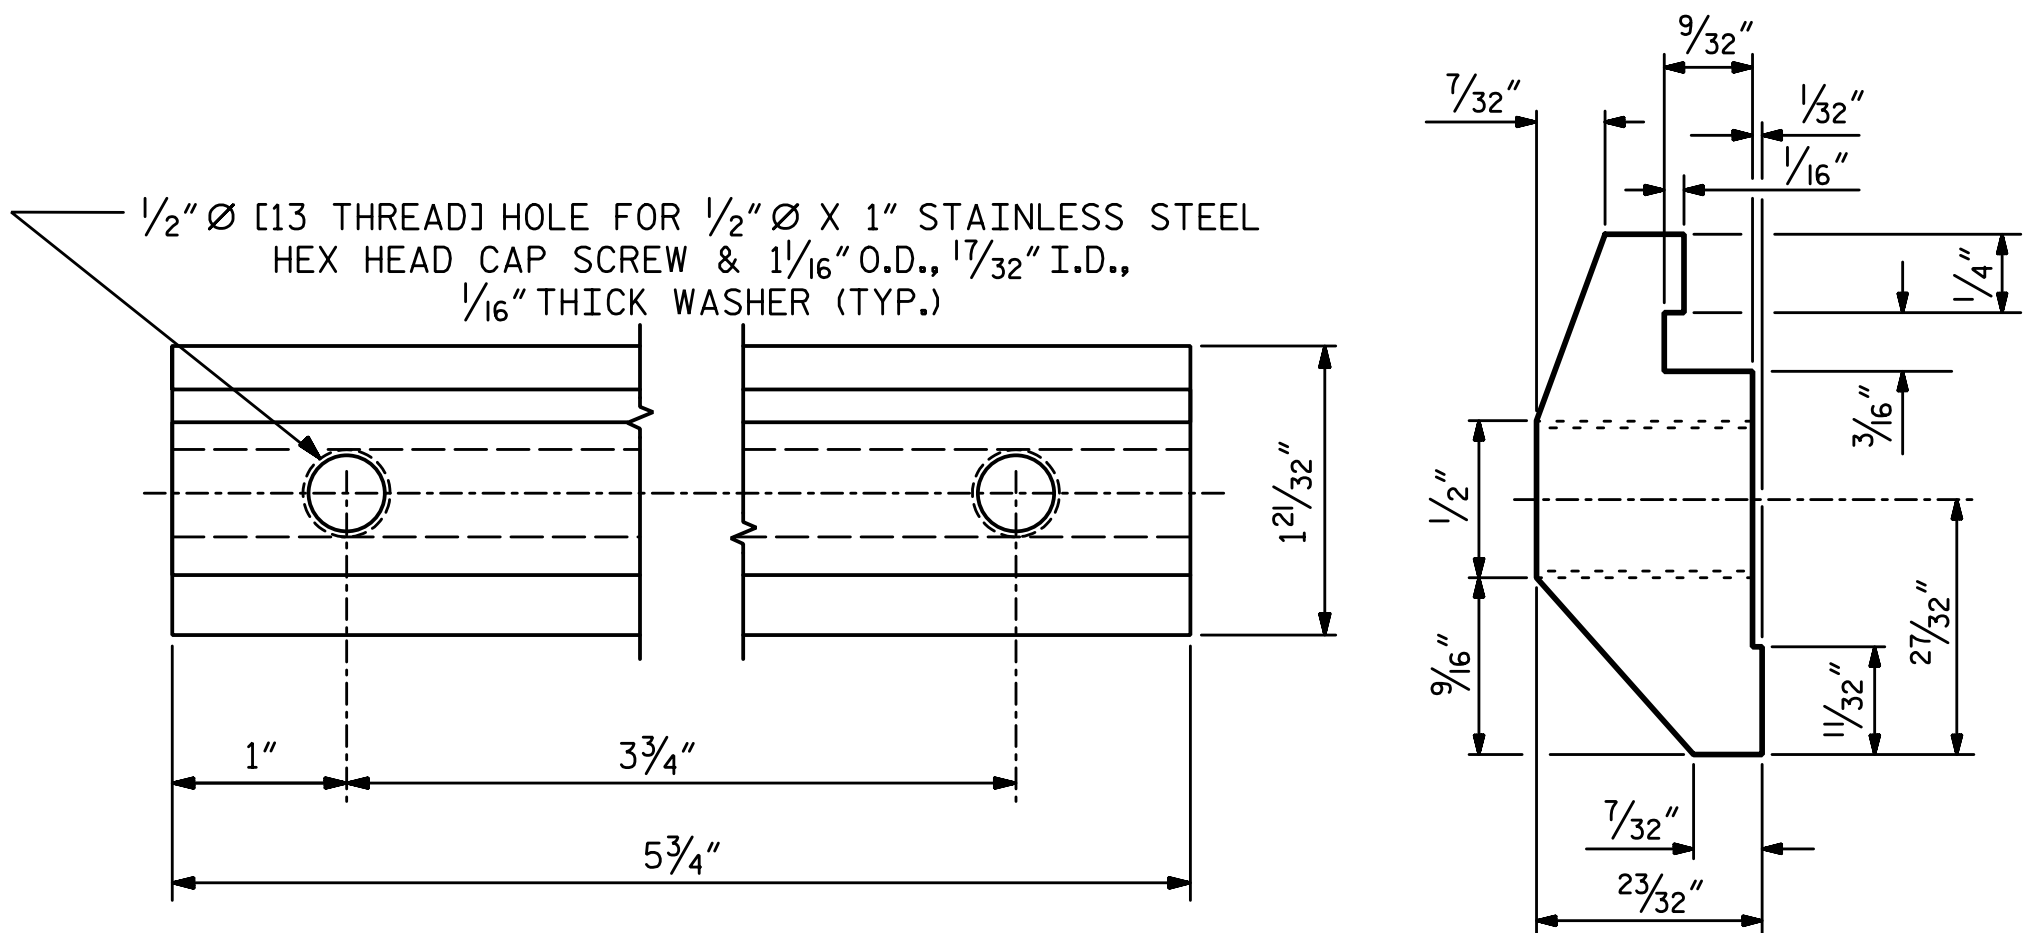


CLAMP BAR DETAIL

(4 REQUIRED PER POST)

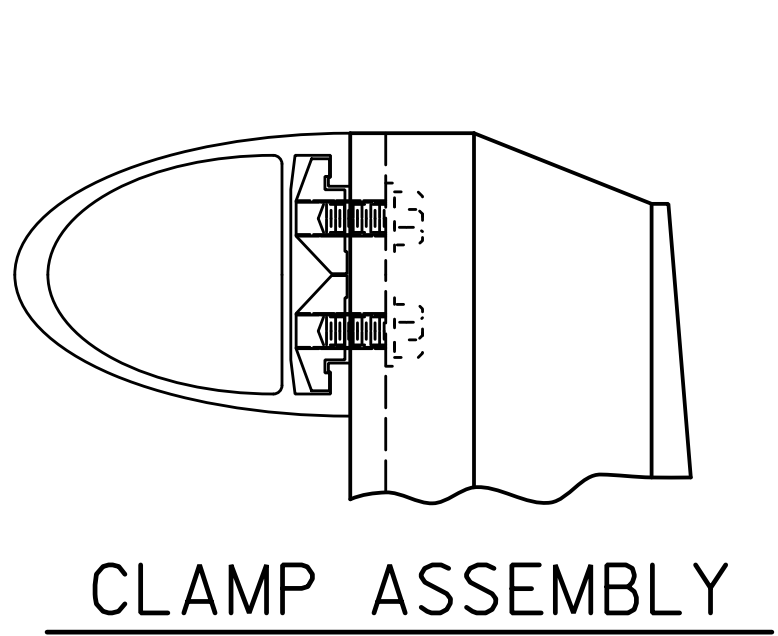

CLAMP ASSEMBLY

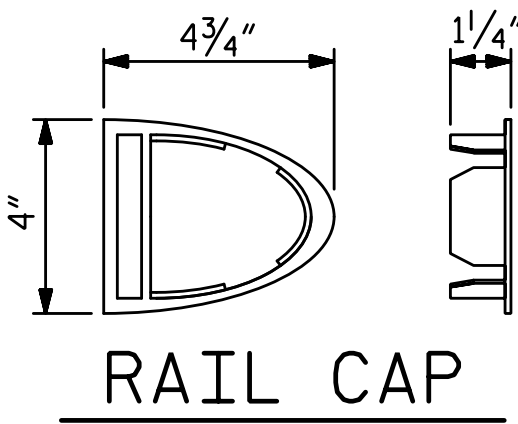

RAIL CAP

PLANS PREPARED BY:

SEMPSON ENGINEERS & ASSOCIATES

5640 Dillard Drive
Suite 200
Cary, NC 27518
(919) 852-0468
(919) 852-0598 (Fax)
www.sempsonengr.com

LICENSURE NO. C-2521



PROJECT NO. 17BP.7.R.98
ORANGE COUNTY
STATION: 13+83.50 -L-

SHEET 2 OF 2

STATE OF NORTH CAROLINA
DEPARTMENT OF TRANSPORTATION
RALEIGH
SUPERSTRUCTURE


2 BAR METAL RAIL

REVISIONS


NO.	BY:	DATE:	NO.	BY:	DATE:	SHEET NO.
1			3			S-10
2			4			TOTAL SHEETS 19

DOCUMENT NOT CONSIDERED FINAL
UNLESS ALL SIGNATURES COMPLETED


3/29/2017 7:54:53 AM G:\Projects\2015\Division 7 (Hatch Mott)\17BP7R98 (Orange 189) (60 33BB 2BMR)\Structures\Drawings\Final\401.17BP7R98_SMJ_SUPER.dgn

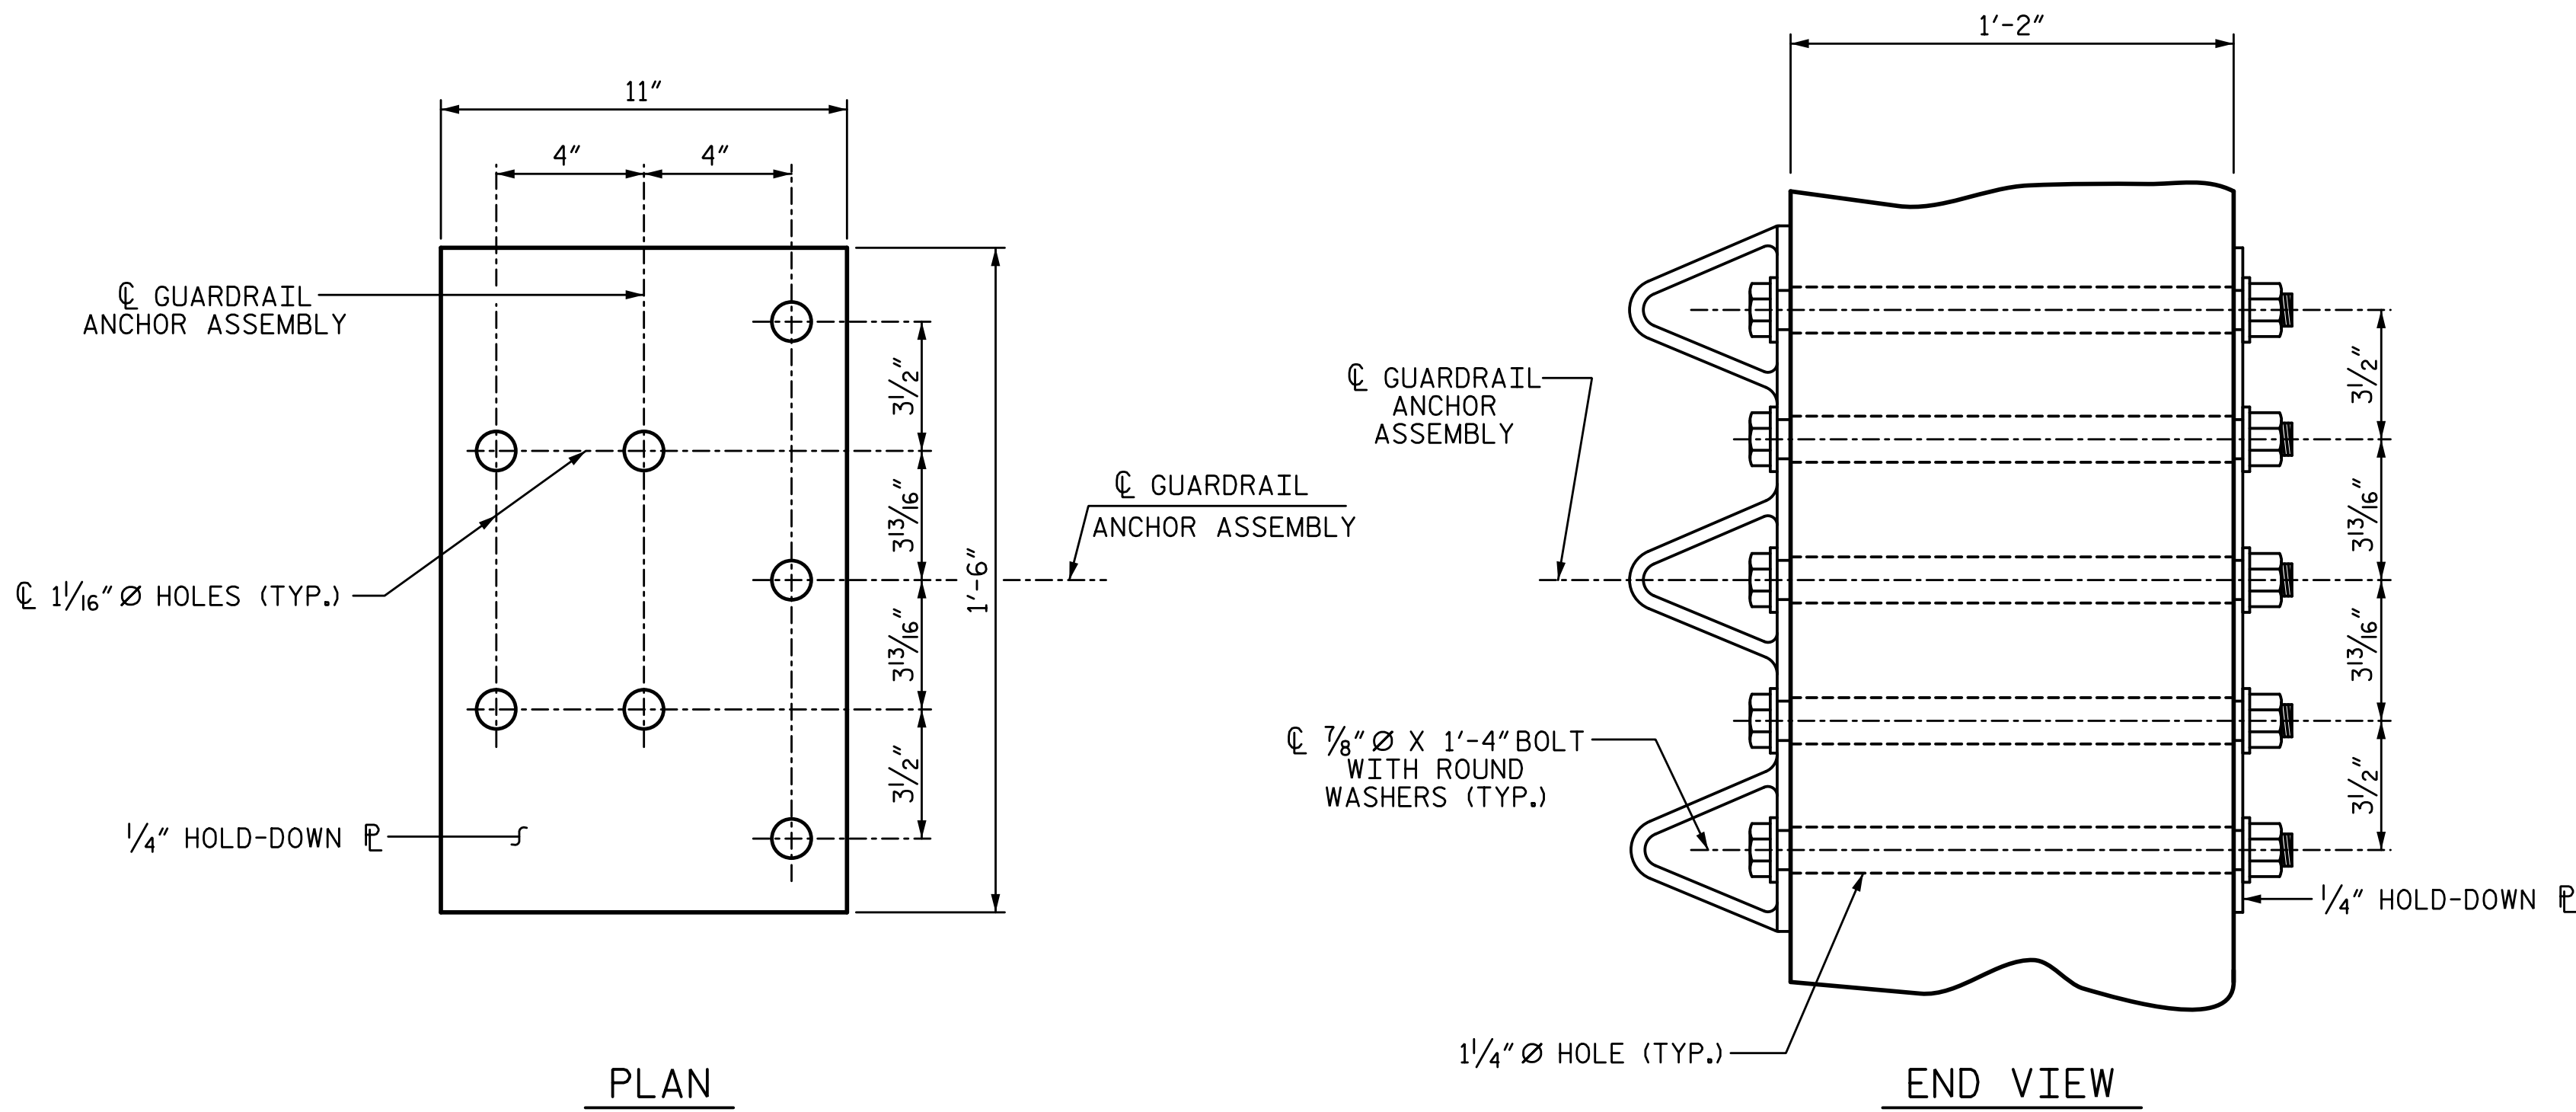

GUARDRAIL ANCHOR ASSEMBLY DETAILS

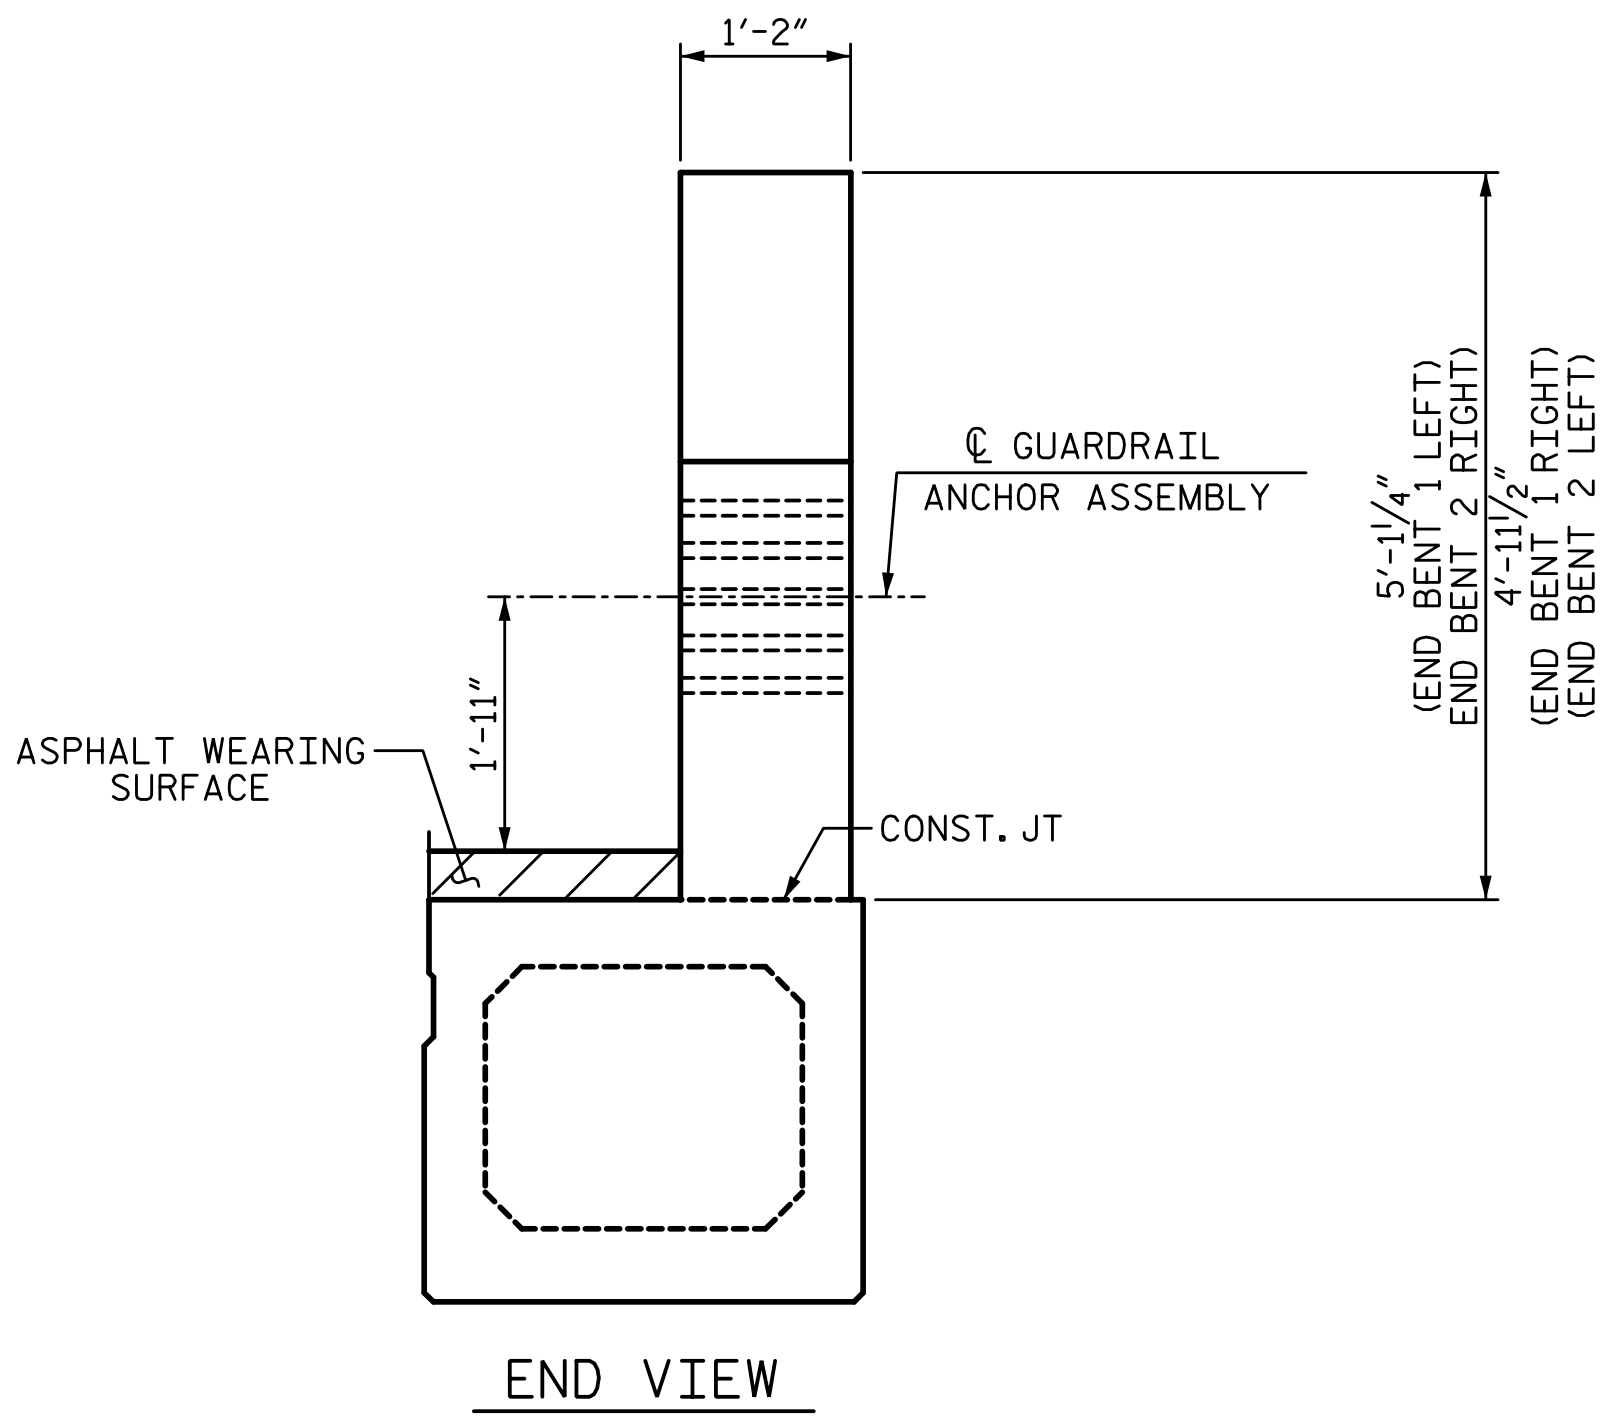

LOCATION OF GUARDRAIL ANCHOR AT END POST

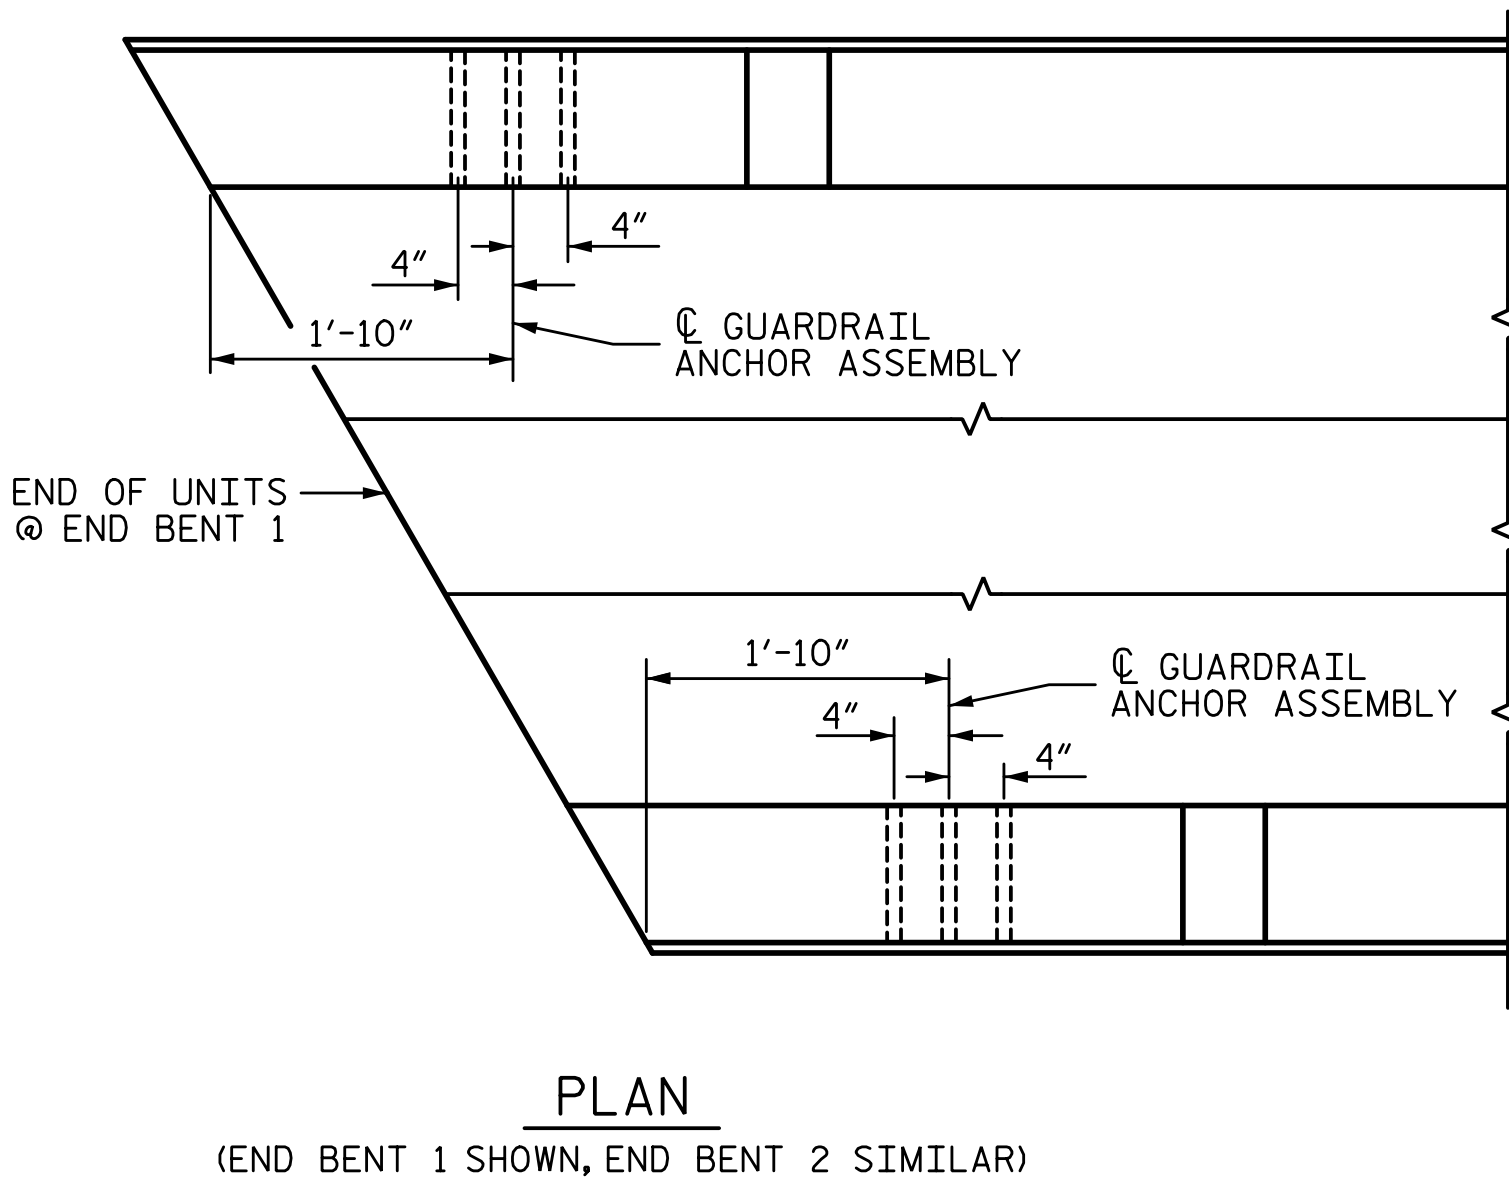

PLAN
(END BENT 1 SHOWN, END BENT 2 SIMILAR)

NOTES:

THE GUARDRAIL ANCHOR ASSEMBLY SHALL CONSIST OF A 1/4" HOLD DOWN PLATE AND 7 - 7/8" Ø BOLTS WITH NUTS AND WASHERS.

THE HOLD-DOWN PLATE SHALL CONFORM TO AASHTO M270 GRADE 36. AFTER FABRICATION, THE HOLD-DOWN PLATE SHALL BE HOT-DIP GALVANIZED IN ACCORDANCE WITH AASHTO M111.

BOLTS SHALL CONFORM TO THE REQUIREMENTS OF ASTM A307 AND NUTS SHALL CONFORM TO THE REQUIREMENTS OF AASHTO M291. BOLTS, NUTS AND WASHERS SHALL BE GALVANIZED. AT THE CONTRACTOR'S OPTION, STAINLESS STEEL BOLTS, NUTS AND WASHERS MAY BE USED AS AN ALTERNATE FOR THE 7/8" Ø GALVANIZED BOLTS, NUTS AND WASHERS. THEY SHALL CONFORM TO OR EXCEED THE MECHANICAL REQUIREMENTS OF ASTM A307. THE USE OF THIS ALTERNATE SHALL BE APPROVED BY THE ENGINEER.

THE GUARDRAIL ANCHOR ASSEMBLY IS REQUIRED AT ALL POINTS WHERE APPROACH GUARDRAIL IS TO BE ATTACHED TO THE END OF THE PARAPET. FOR POINTS OF ATTACHMENT, SEE SKETCH.

AFTER INSTALLATION, THE EXPOSED THREAD OF THE BOLT SHALL BE BURRED WITH A SHARP POINTED TOOL.

THE COST OF THE GUARDRAIL ANCHOR ASSEMBLIES WITH BOLTS, NUTS AND WASHERS COMPLETE IN PLACE, SHALL BE INCLUDED IN THE VARIOUS PAY ITEMS.

THE VERTICAL REINFORCING BARS MAY BE SHIFTED SLIGHTLY IN THE END POST TO CLEAR ASSEMBLY BOLTS.

THE 1 1/4" Ø HOLES SHALL BE FORMED OR DRILLED WITH A CORE BIT. IMPACT TOOLS WILL NOT BE PERMITTED. ANY CONCRETE DAMAGED BY THIS WORK SHALL BE REPAIRED TO THE SATISFACTION OF THE ENGINEER.



SKETCH SHOWING POINTS OF ATTACHMENT

* LOCATION OF GUARDRAIL ATTACHMENT

PROJECT NO. 17BP.7.R.98
ORANGE COUNTY
STATION: 13+83.50 -L-


DRAWN BY: T. BANKOVICH DATE: 9-16
CHECKED BY: B.S. COX DATE: 9-16
DESIGN ENGINEER OF RECORD: B.S. COX DATE: 9-16

PLANS PREPARED BY:

SE & A
IMPSON
ENGINEERS
& ASSOCIATES

5640 Dillard Drive
Suite 200
Cary, NC 27518
(919) 852-0468
(919) 852-0598 (Fax)
www.simpsonengr.com

LICENSURE NO. C-2521

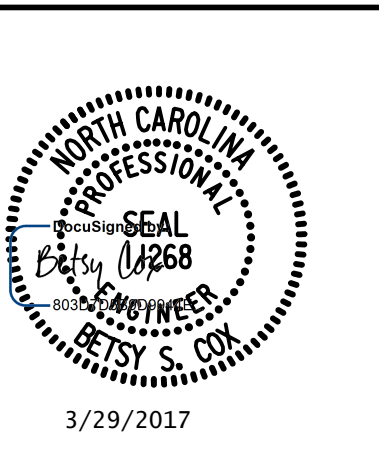

STATE OF NORTH CAROLINA
DEPARTMENT OF TRANSPORTATION
RALEIGH
SUPERSTRUCTURE
GUARDRAIL ANCHORAGE
DETAILS
FOR METAL RAILS


REVISIONS

NO.	BY:	DATE:	NO.	BY:	DATE:
1			3		
2			4		

DOCUMENT NOT CONSIDERED FINAL
UNLESS ALL SIGNATURES COMPLETED

SHEET NO.
S-12
TOTAL
SHEETS
19

3/29/2017 7:54:53 AM G:\Projects\2015\Division 7 (Hatch Mot)\17BP7R98 (Orange 189) (60 33BB 2BMR)\Structures\Drawings\Final\401.17BP7R98_SMJ_EB.dgn

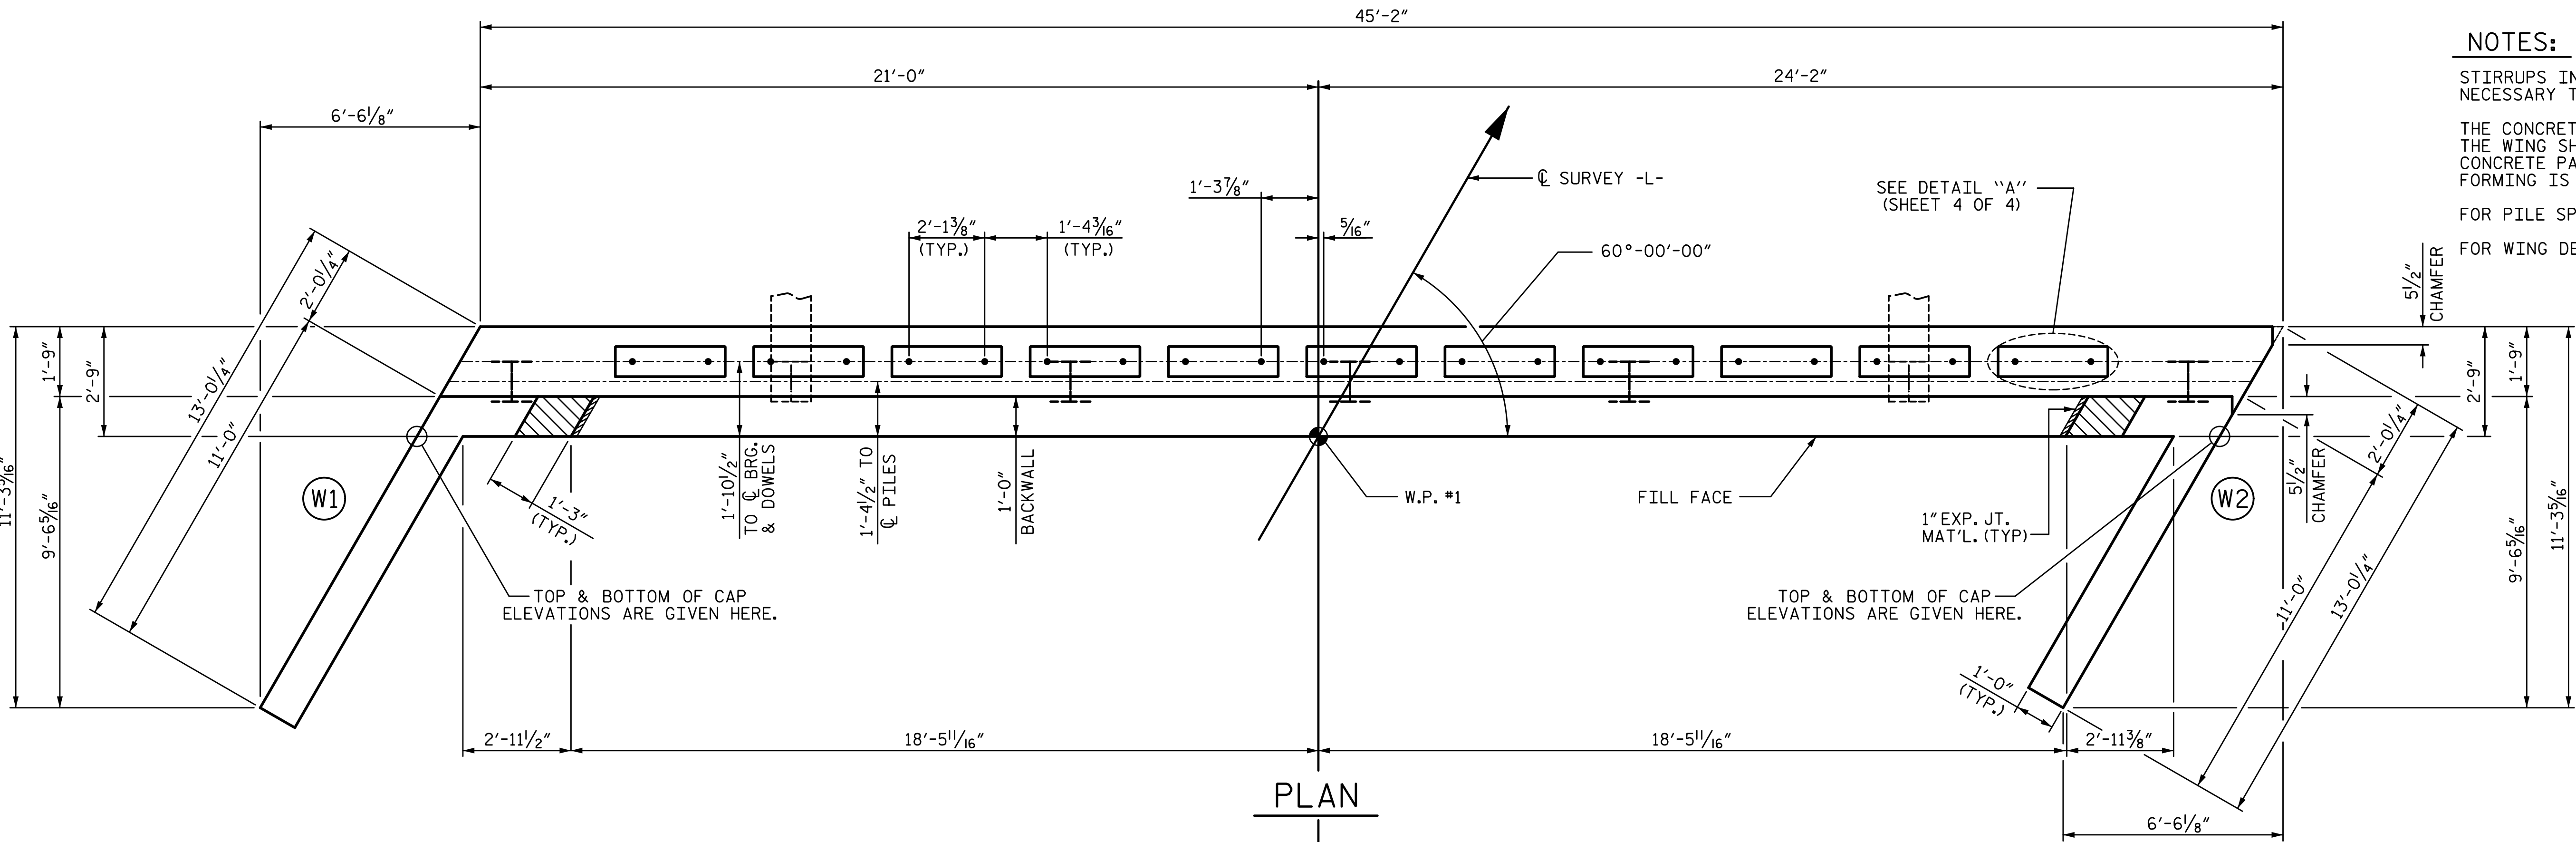

NOTES:


STIRRUPS IN CAP MAY BE SHIFTED AS NECESSARY TO CLEAR DOWELS.

THE CONCRETE IN THE SHADED AREA OF THE WING SHALL BE POURED AFTER THE CONCRETE PARAPET IS CAST IF SLIP FORMING IS USED.

FOR PILE SPICE DETAILS, SEE SHEET 4 OF 4.

FOR WING DETAILS, SEE SHEET 3 OF 4.

PLAN

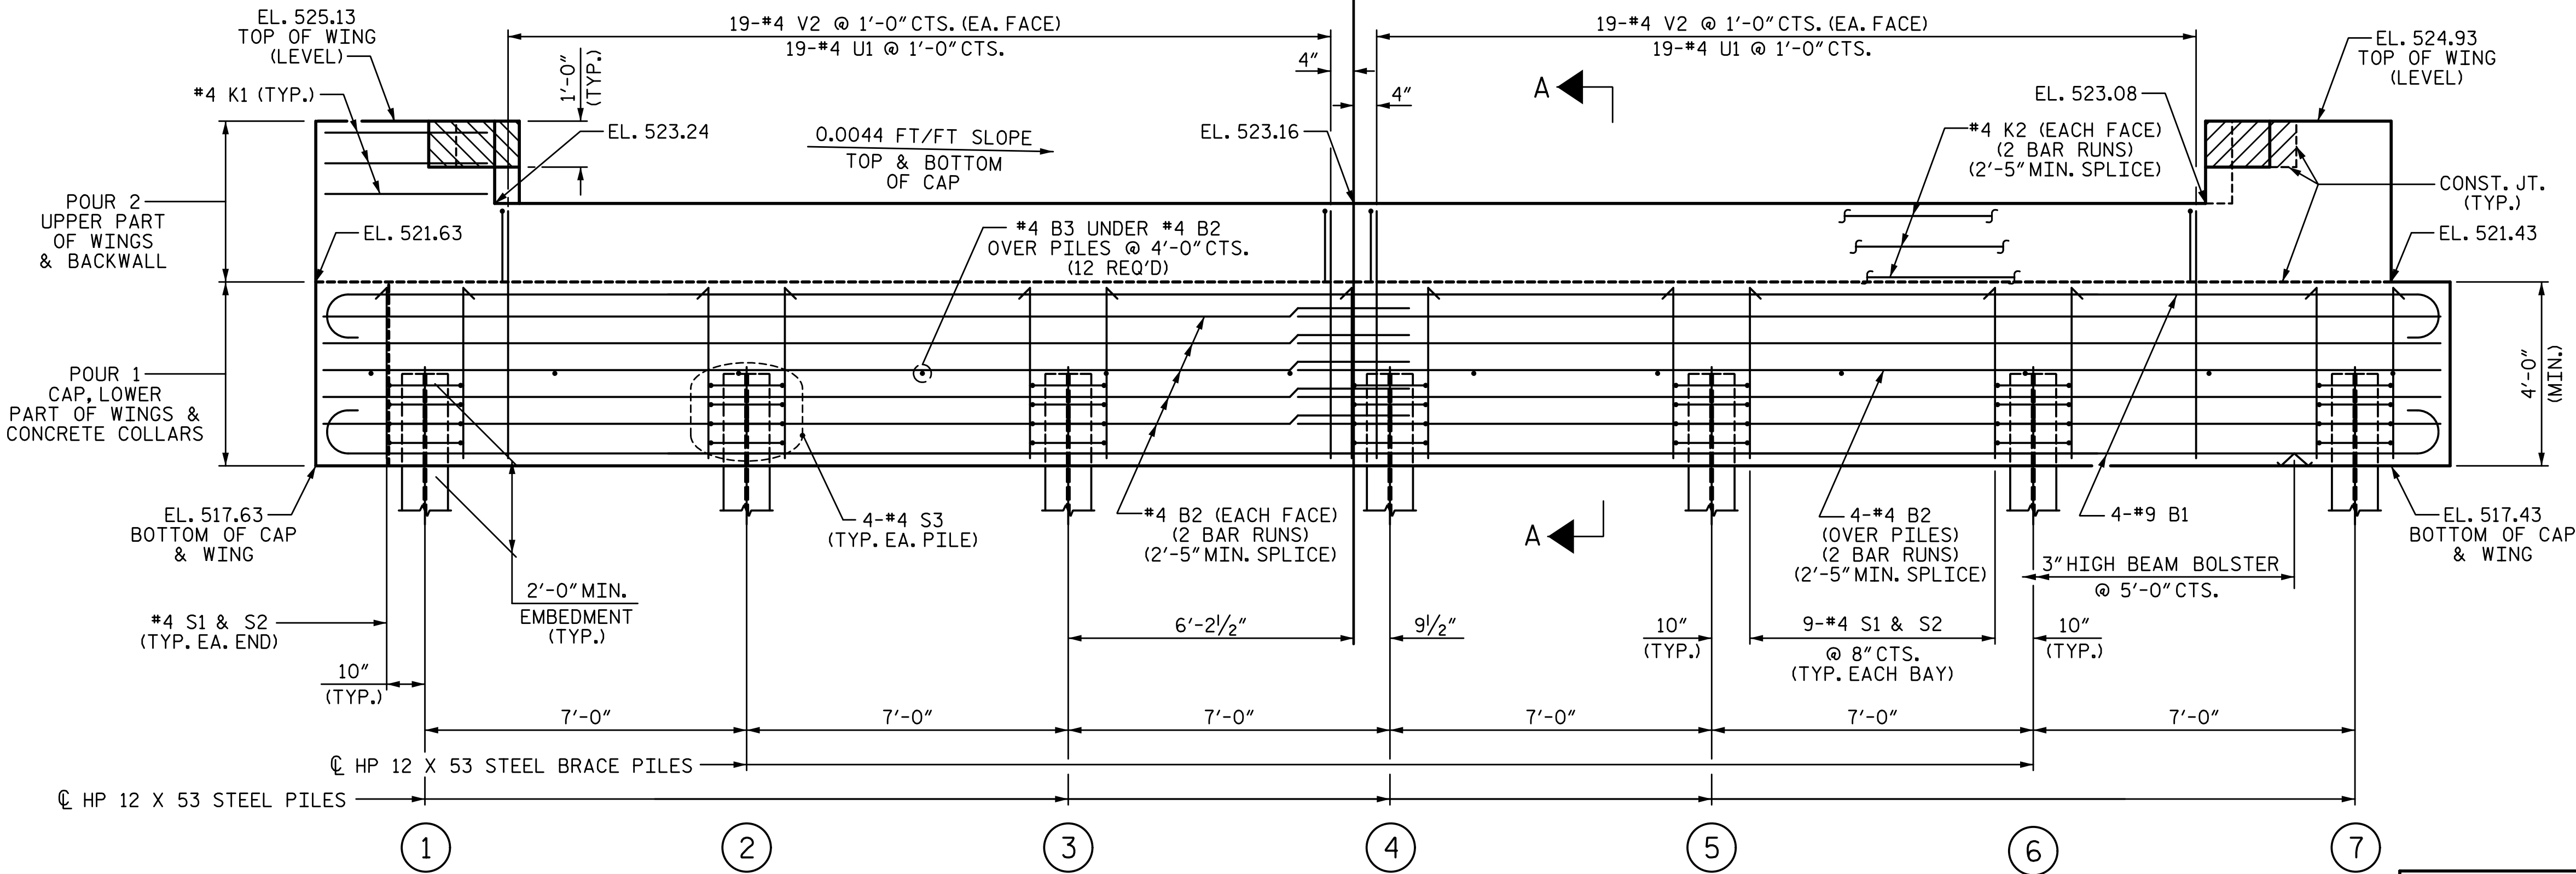

ELEVATION

WINGS NOT SHOWN FOR CLARITY.
FOR SECTION A-A, SEE SHEET 4 OF 4.
CONCRETE COLLARS FOR STEEL PILES NOT SHOWN IN PLAN AND ELEVATION VIEWS FOR CLARITY.
SEE "CORROSION PROTECTION FOR STEEL PILES DETAIL", SHEET 4 OF 4.

TOP OF PILE ELEVATIONS

①	519.59
②	519.56
③	519.53
④	519.50
⑤	519.47
⑥	519.44
⑦	519.41

PROJECT NO. 17BP.7.R.98
ORANGE COUNTY
STATION: 13+83.50 -L-

SHEET 1 OF 4

STATE OF NORTH CAROLINA
DEPARTMENT OF TRANSPORTATION
RALEIGH
SUBSTRUCTURE

END BENT 1

REVISIONS

NO.	BY:	DATE:	NO.	BY:	DATE:
1			3		
2			4		

SHEET NO.

S-13

TOTAL

SHEETS


19

PLANS PREPARED BY:

SEMPSON
& ASSOCIATES

5640 Dillard Drive
Suite 200
Cary, NC 27518
(919) 852-0468
(919) 852-0598 (Fax)
www.simpsonengr.com

LICENSURE NO. C-2521

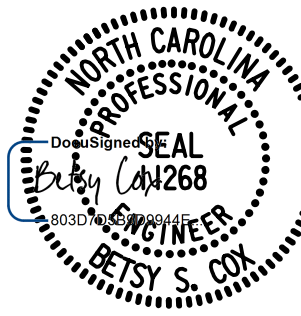


3/29/2017

DOCUMENT NOT CONSIDERED FINAL
UNLESS ALL SIGNATURES COMPLETED




← WORKLINE

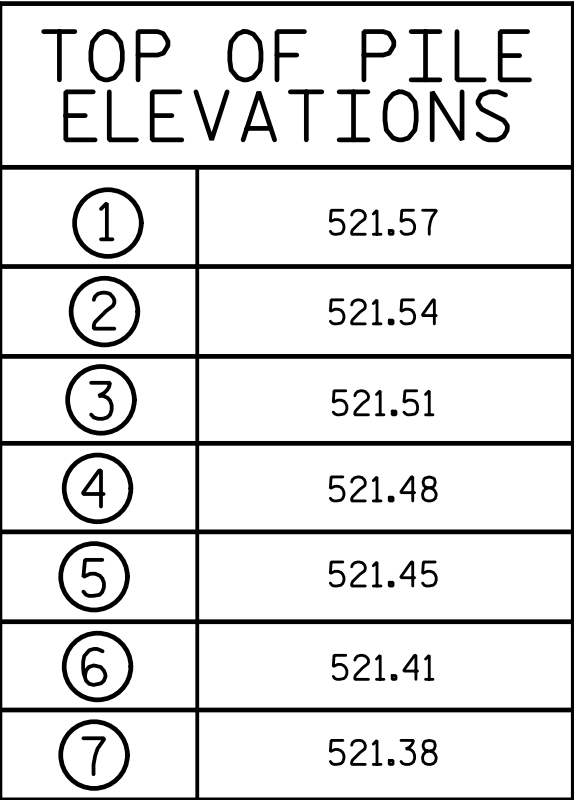

WINGS NOT SHOWN FOR CLARITY.
FOR SECTION A-A, SEE SHEET 4 OF 4.
CONCRETE COLLARS FOR STEEL PILES NOT SHOWN IN PLAN AND ELEVATION VIEWS FOR CLARITY.
SEE "CORROSION PROTECTION FOR STEEL PILES DETAIL", SHEET 4 OF 4.

**SIMPSON
& SE ENGINEERS
& ASSOCIATES**
5640 Dillard Drive
Suite 200
Cary, NC 27518
(919) 852-0468
(919) 852-0598 (Fax)
www.simpsonengr.com
LICENSURE NO. C-252

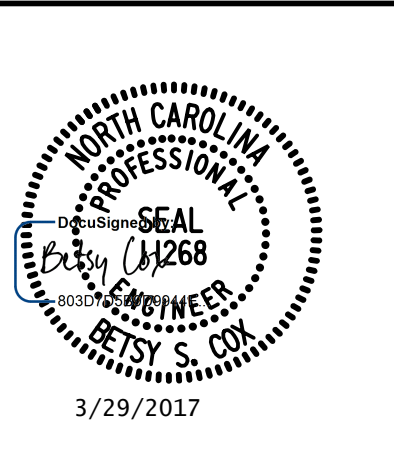

SHEET 2 OF 4

END BENT 2

REVISIONS						SHEET NO. S-14
NO.	BY:	DATE:	NO.	BY:	DATE:	
1			3			TOTAL SHEETS 19
2			4			

DRAWN BY: T. BANKOVICH DATE: 9-16
 CHECKED BY: B.S. COX DATE: 9-16
 DESIGN ENGINEER OF RECORD: B.S. COX DATE: 9-16


**DOCUMENT NOT CONSIDERED FINAL
UNLESS ALL SIGNATURES COMPLETED**



SHEET 3 OF 4

PLANS PREPARED BY:

LICENSURE NO. C-2521

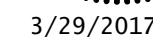


END BENT
WING DETAILS

REVISIONS						SHEET NO. S-15
NO.	BY:	DATE:	NO.	BY:	DATE:	
1			3			TOTAL SHEETS 19
2			4			

**DOCUMENT NOT CONSIDERED FINAL
UNLESS ALL SIGNATURES COMPLETED**

3/29/2017 7:54:54 AM G:\Projects\2015\Division 7 (Hatch Mot-t)\17BP7R98 (Orange 189) (60 33BB 2BMR)\Structures\Drawings\Final\401.17BP7R98_SMU_EB.dgn

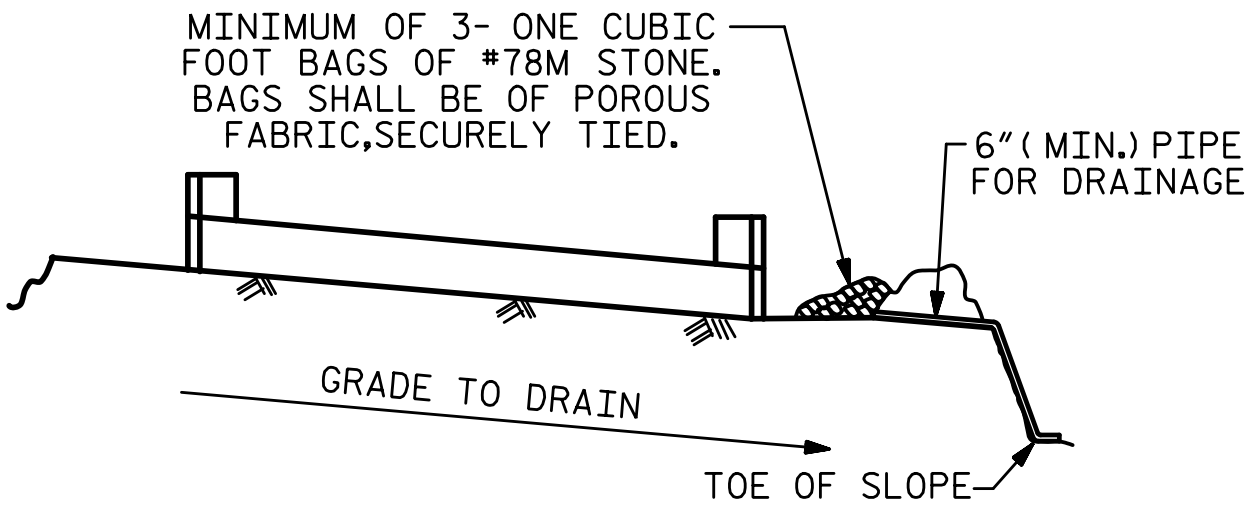


BAGGED STONE AND PIPE SHALL BE PLACED IMMEDIATELY AFTER COMPLETION OF END BENT EXCAVATION. PIPE MAY BE EITHER CONCRETE, CORRUGATED STEEL, CORRUGATED ALUMINUM ALLOY, OR CORRUGATED PLASTIC. PERFORATED PIPE WILL NOT BE ALLOWED.

BAGGED STONE SHALL REMAIN IN PLACE UNTIL THE ENGINEER DIRECTS THAT IT BE REMOVED. THE CONTRACTOR SHALL REMOVE AND DISPOSE OF SILT ACCUMULATIONS AT BAGGED STONE WHEN SO DIRECTED BY THE ENGINEER. BAGS SHALL BE REMOVED AND REPLACED WHENEVER THE ENGINEER DETERMINES THAT THEY HAVE DETERIORATED AND LOST THEIR EFFECTIVENESS.


NO SEPARATE PAYMENT WILL BE MADE FOR THIS WORK AND THE ENTIRE COST OF THIS WORK SHALL BE INCLUDED IN THE UNIT CONTRACT PRICE BID FOR THE SEVERAL PAY ITEMS.

TEMPORARY DRAINAGE AT END BENT

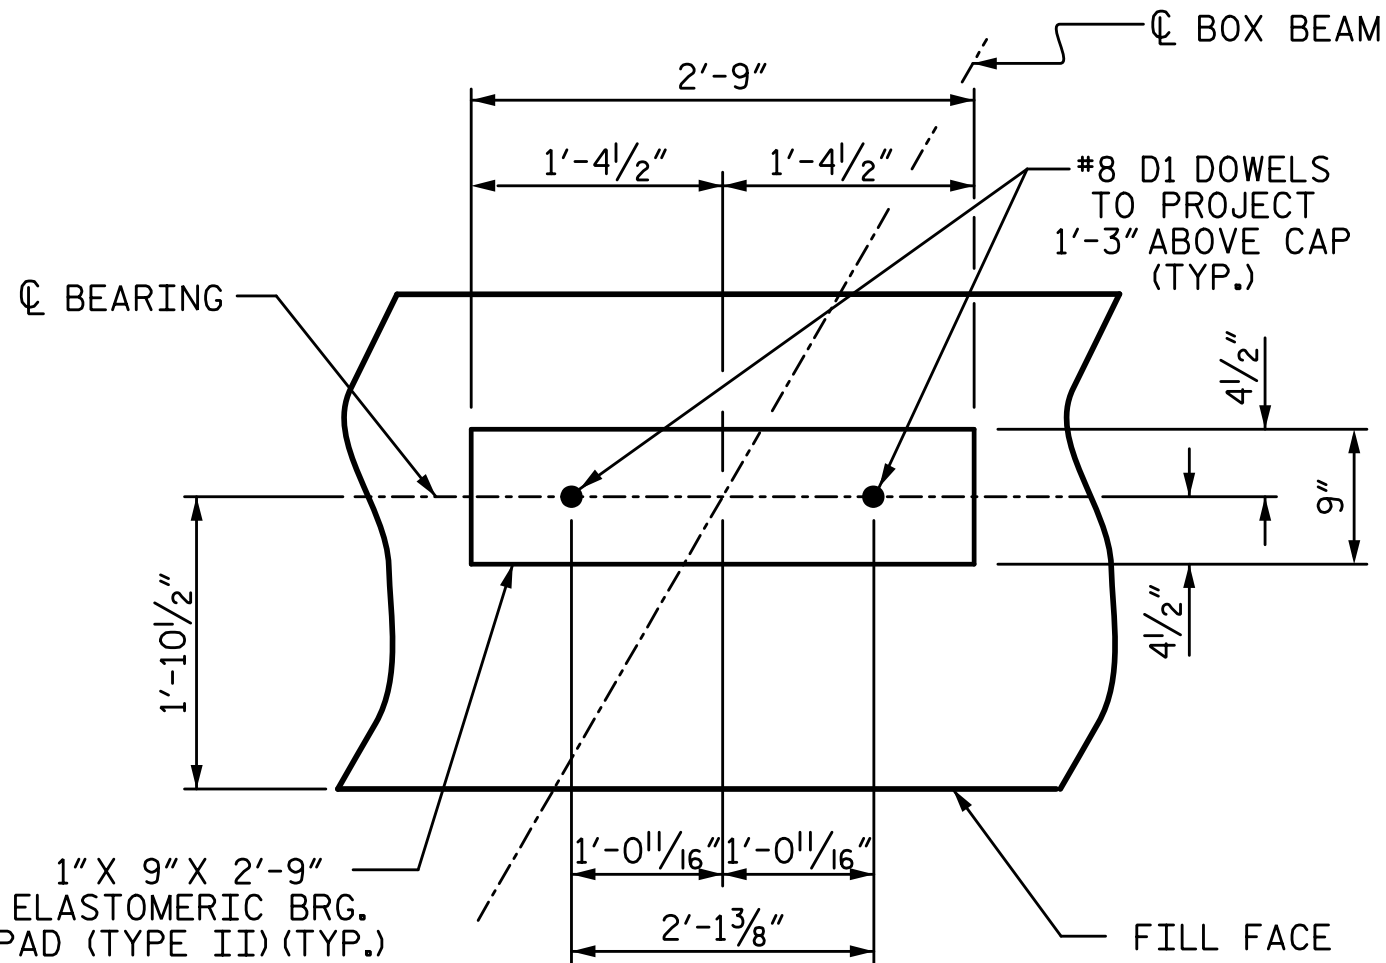

DETAIL "A"


(END BENT 1 SHOWN, END BENT 2 SIMILAR BY ROTATION)

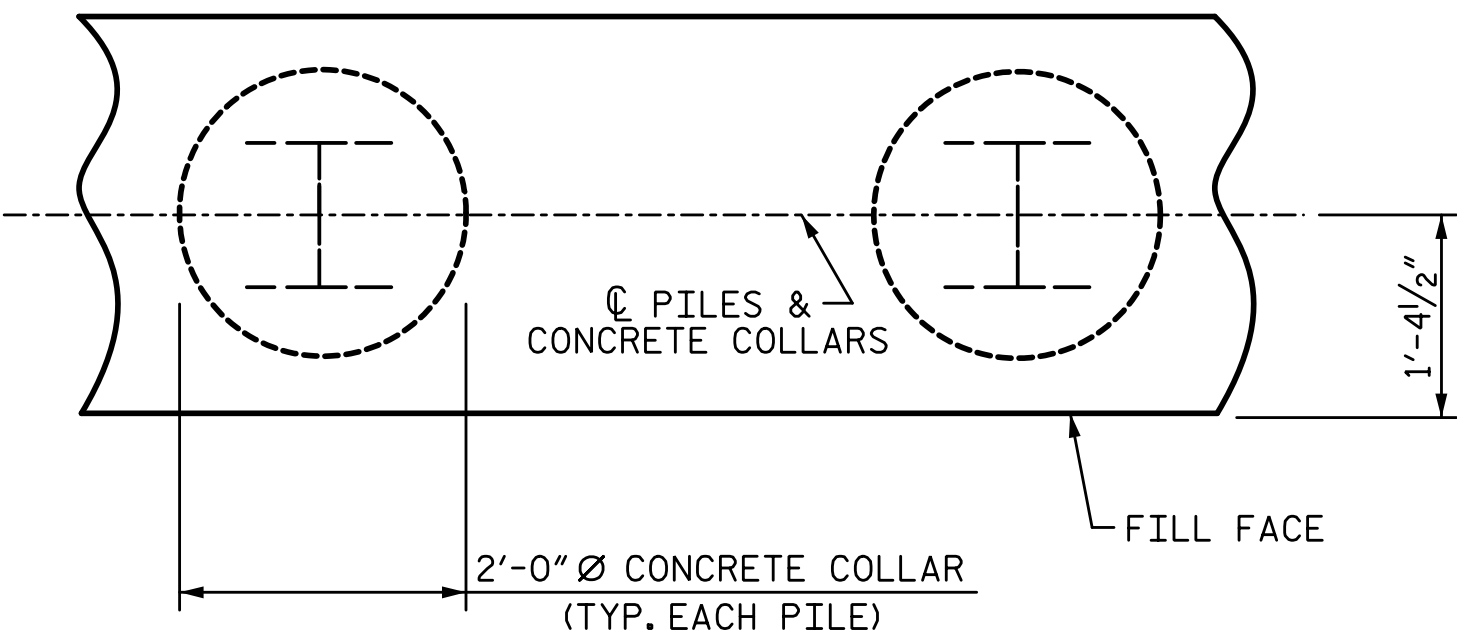


PLAN

CORROSION PROTECTION FOR STEEL PILES DETAIL


(END BENT 1 SHOWN, END BENT 2 SIMILAR BY ROTATION)

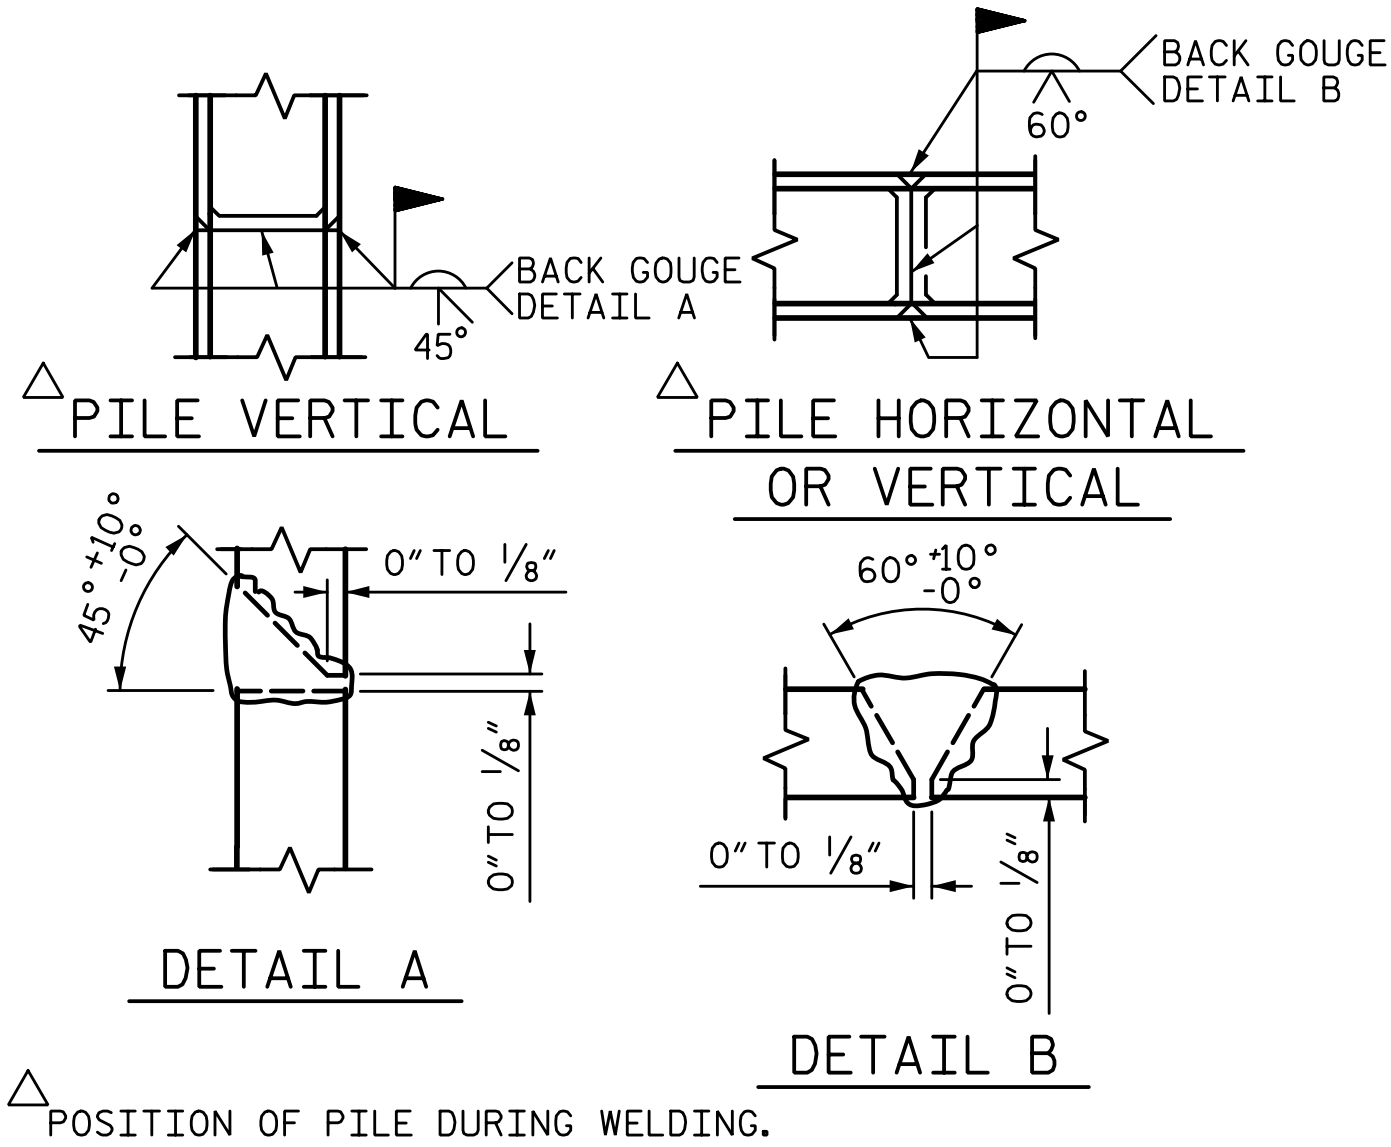

PILE SPLICE DETAILS

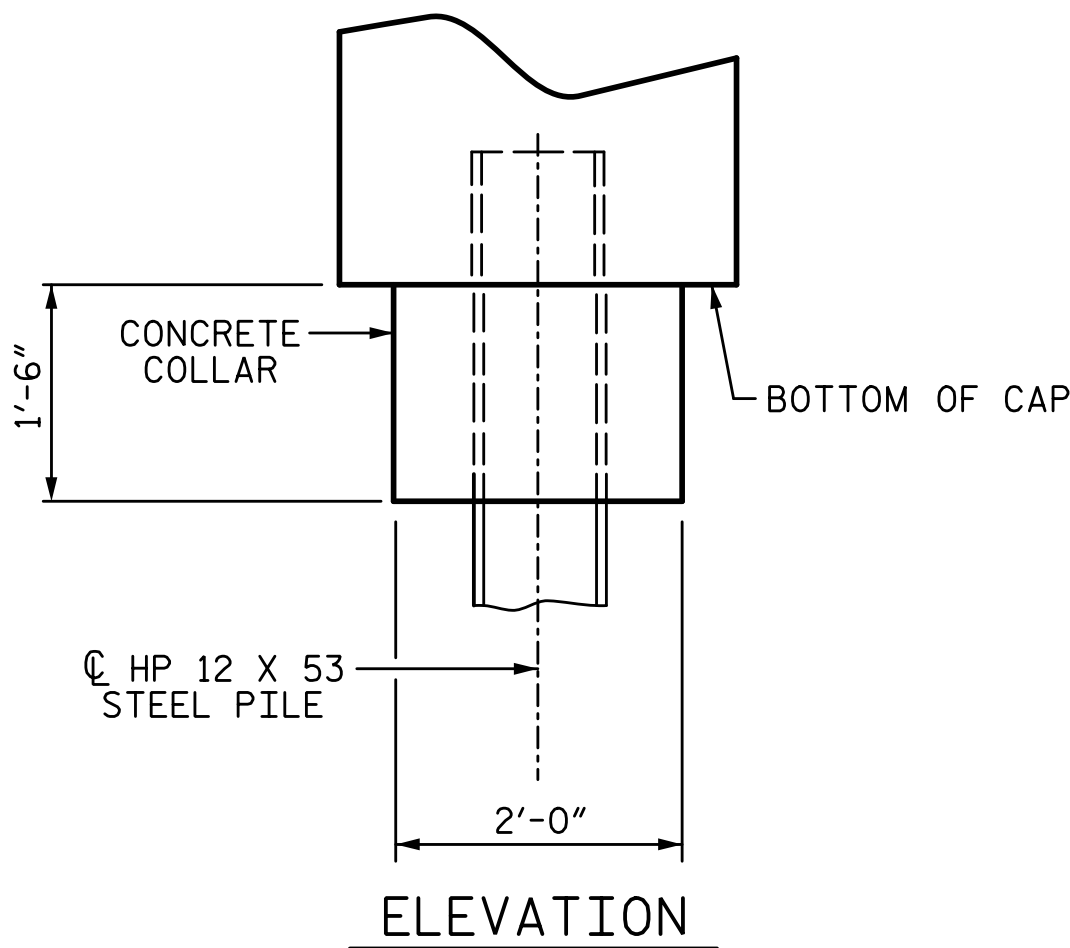

ELEVATION

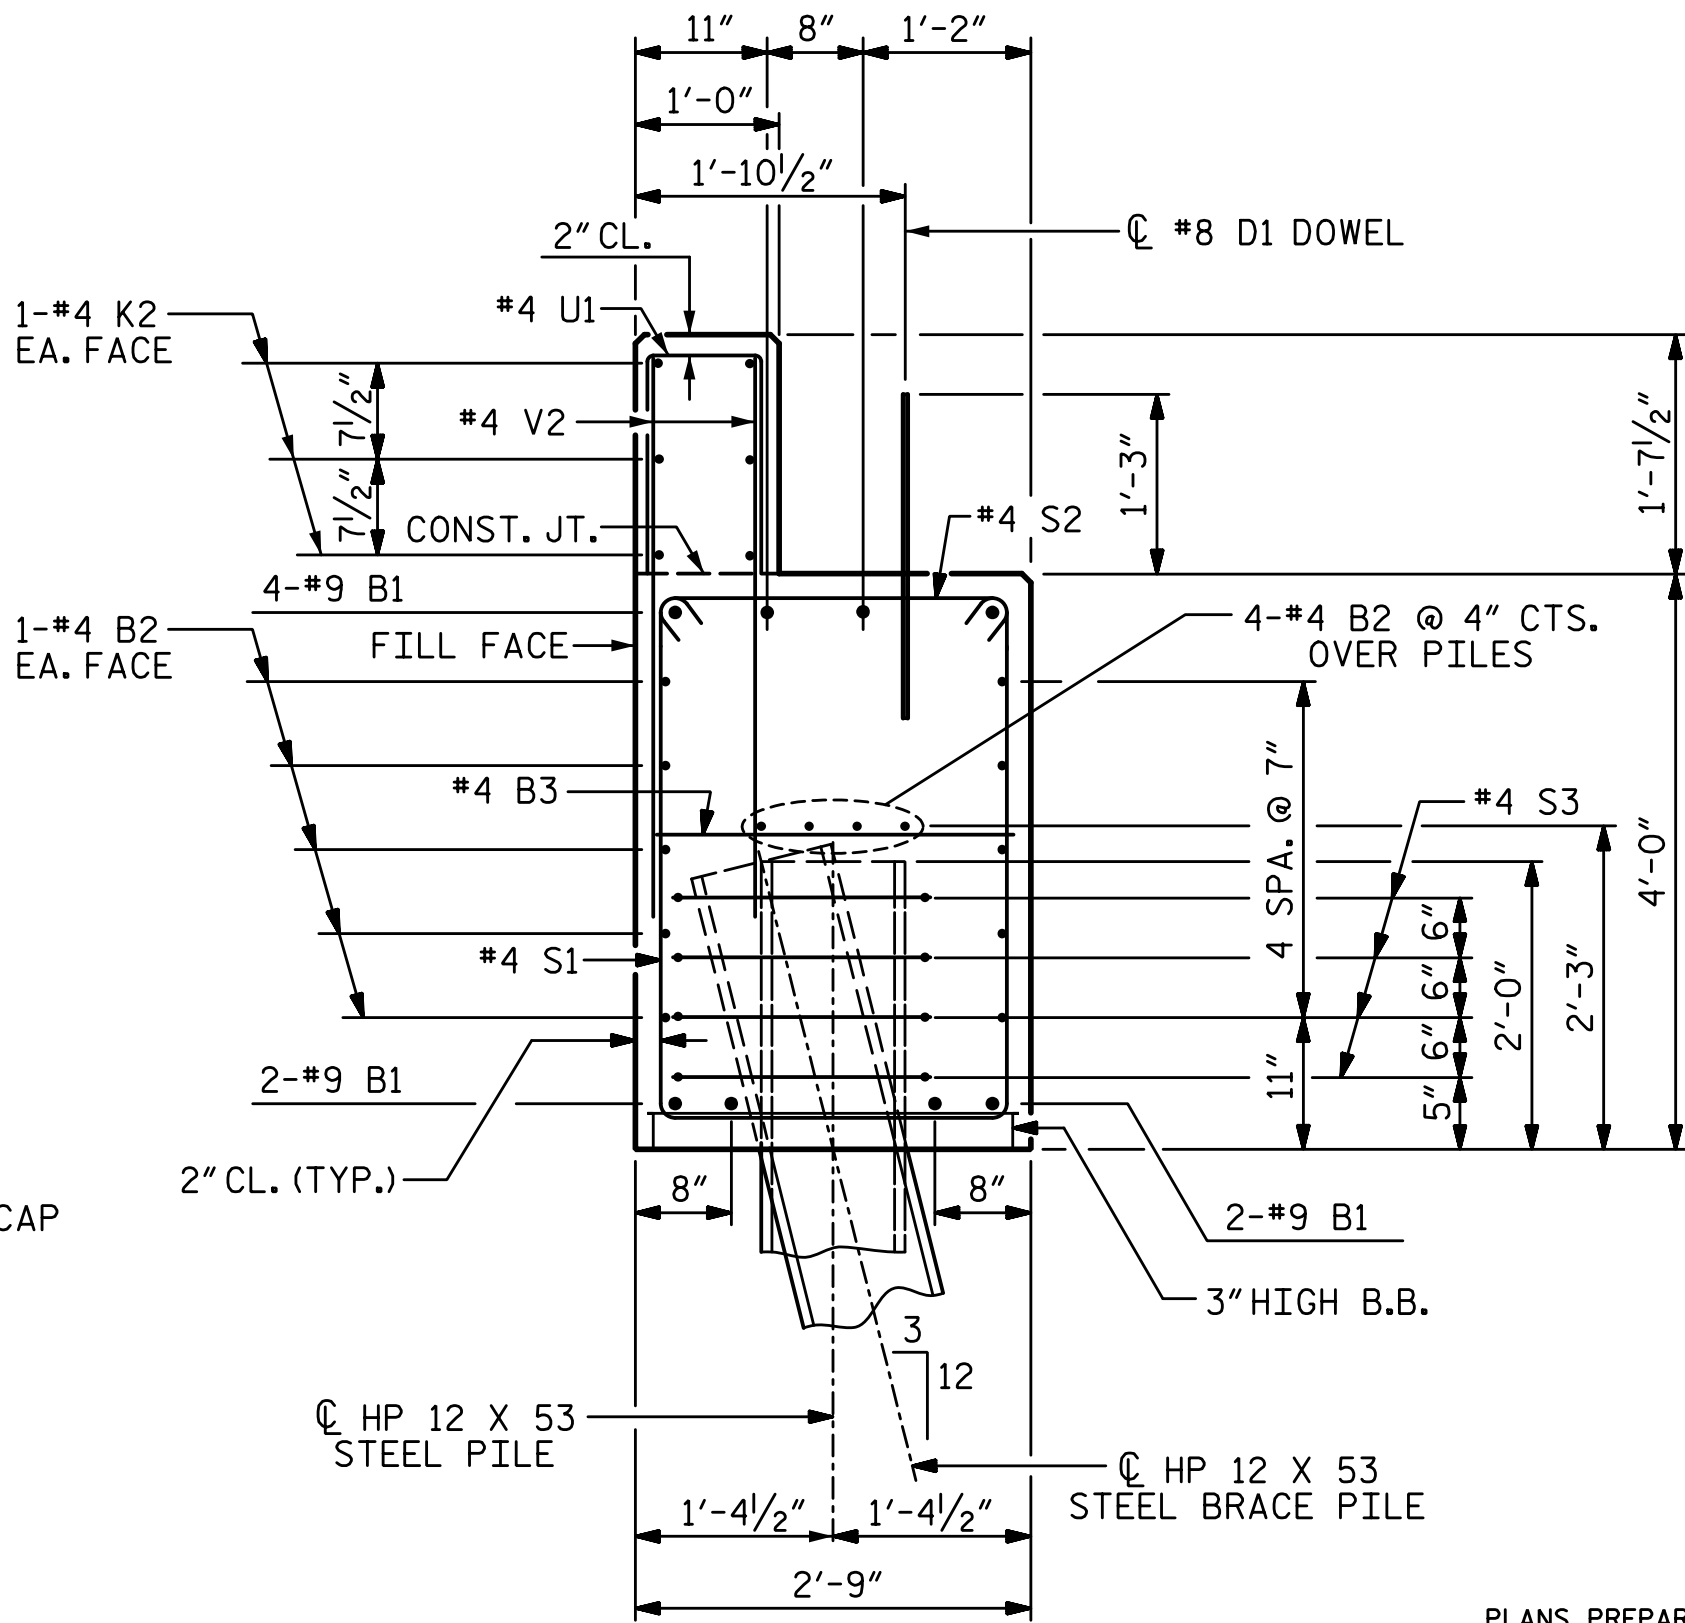

SECTION A-A

(CONCRETE COLLAR NOT SHOWN FOR CLARITY. SEE "CORROSION PROTECTION FOR STEEL PILES DETAIL.")

BAR TYPES	
ALL BAR DIMENSIONS ARE OUT TO OUT.	
END BENT 1 HP 12 X 53 STEEL PILES NO: 7 LF = 125 STEEL PILE POINTS NO: 7	END BENT 2 HP 12 X 53 STEEL PILES NO: 7 LF = 125 STEEL PILE POINTS NO: 7

BILL OF MATERIAL FOR ONE END BENT					
BAR	NO.	SIZE	TYPE	LENGTH	WEIGHT
B1	8	#9	1	47'-2"	1283
B2	28	#4	STR	23'-8"	443
B3	12	#4	STR	2'-5"	19
D1	22	#8	STR	2'-3"	132
H1	12	#5	2	11'-9"	147
H2	12	#5	2	11'-4"	142
H3	24	#5	3	10'-10"	271
K1	12	#4	STR	3'-5"	27
K2	12	#4	STR	23'-8"	190
S1	56	#4	4	10'-5"	390
S2	56	#4	5	3'-2"	118
S3	28	#4	6	6'-6"	122
U1	38	#4	7	3'-7"	91
V1	61	#4	STR	7'-2"	292
V2	76	#4	STR	5'-3"	267
REINFORCING STEEL (FOR ONE END BENT)					3934 LBS.
CLASS A CONCRETE BREAKDOWN (FOR ONE END BENT)					
POUR 1	CAP, LOWER PART OF WINGS & COLLARS				22.6 C.Y.
POUR 2	BACKWALL & UPPER PART OF WINGS				5.9 C.Y.
TOTAL CLASS A CONCRETE					28.5 C.Y.

PROJECT NO. 17BP.7.R.98
ORANGE COUNTY
STATION: 13+83.50 -L-

SHEET 4 OF 4


STATE OF NORTH CAROLINA
DEPARTMENT OF TRANSPORTATION
RALEIGH
SUBSTRUCTURE

END BENT 1 & 2
DETAILS

REVISIONS						SHEET NO. S-16
NO.	BY:	DATE:	NO.	BY:	DATE:	
1			3			TOTAL SHEETS 19
2			4			


PLANS PREPARED BY:

SIMPSON ENGINEERS & ASSOCIATES
5640 Dillard Drive
Suite 200
Cary, NC 27518
(919) 852-0468
(919) 852-0598 (Fax)
www.simpsonengr.com
LICENSURE NO. C-2521

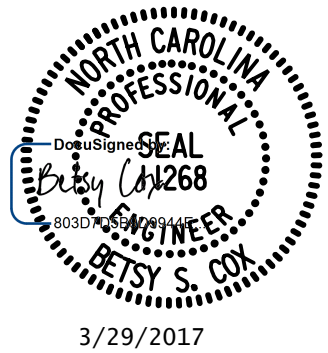

DOCUMENT NOT CONSIDERED FINAL
UNLESS ALL SIGNATURES COMPLETED


3/29/2017 7:54:54 AM G:\Projects\2015\Division 7 (Hatch Mot)\17BP7R98 (Orange 189) (60 33BB 2BMR)\Structures\Drawings\Final\401.17BP7R98_SMJ_RR.dgn

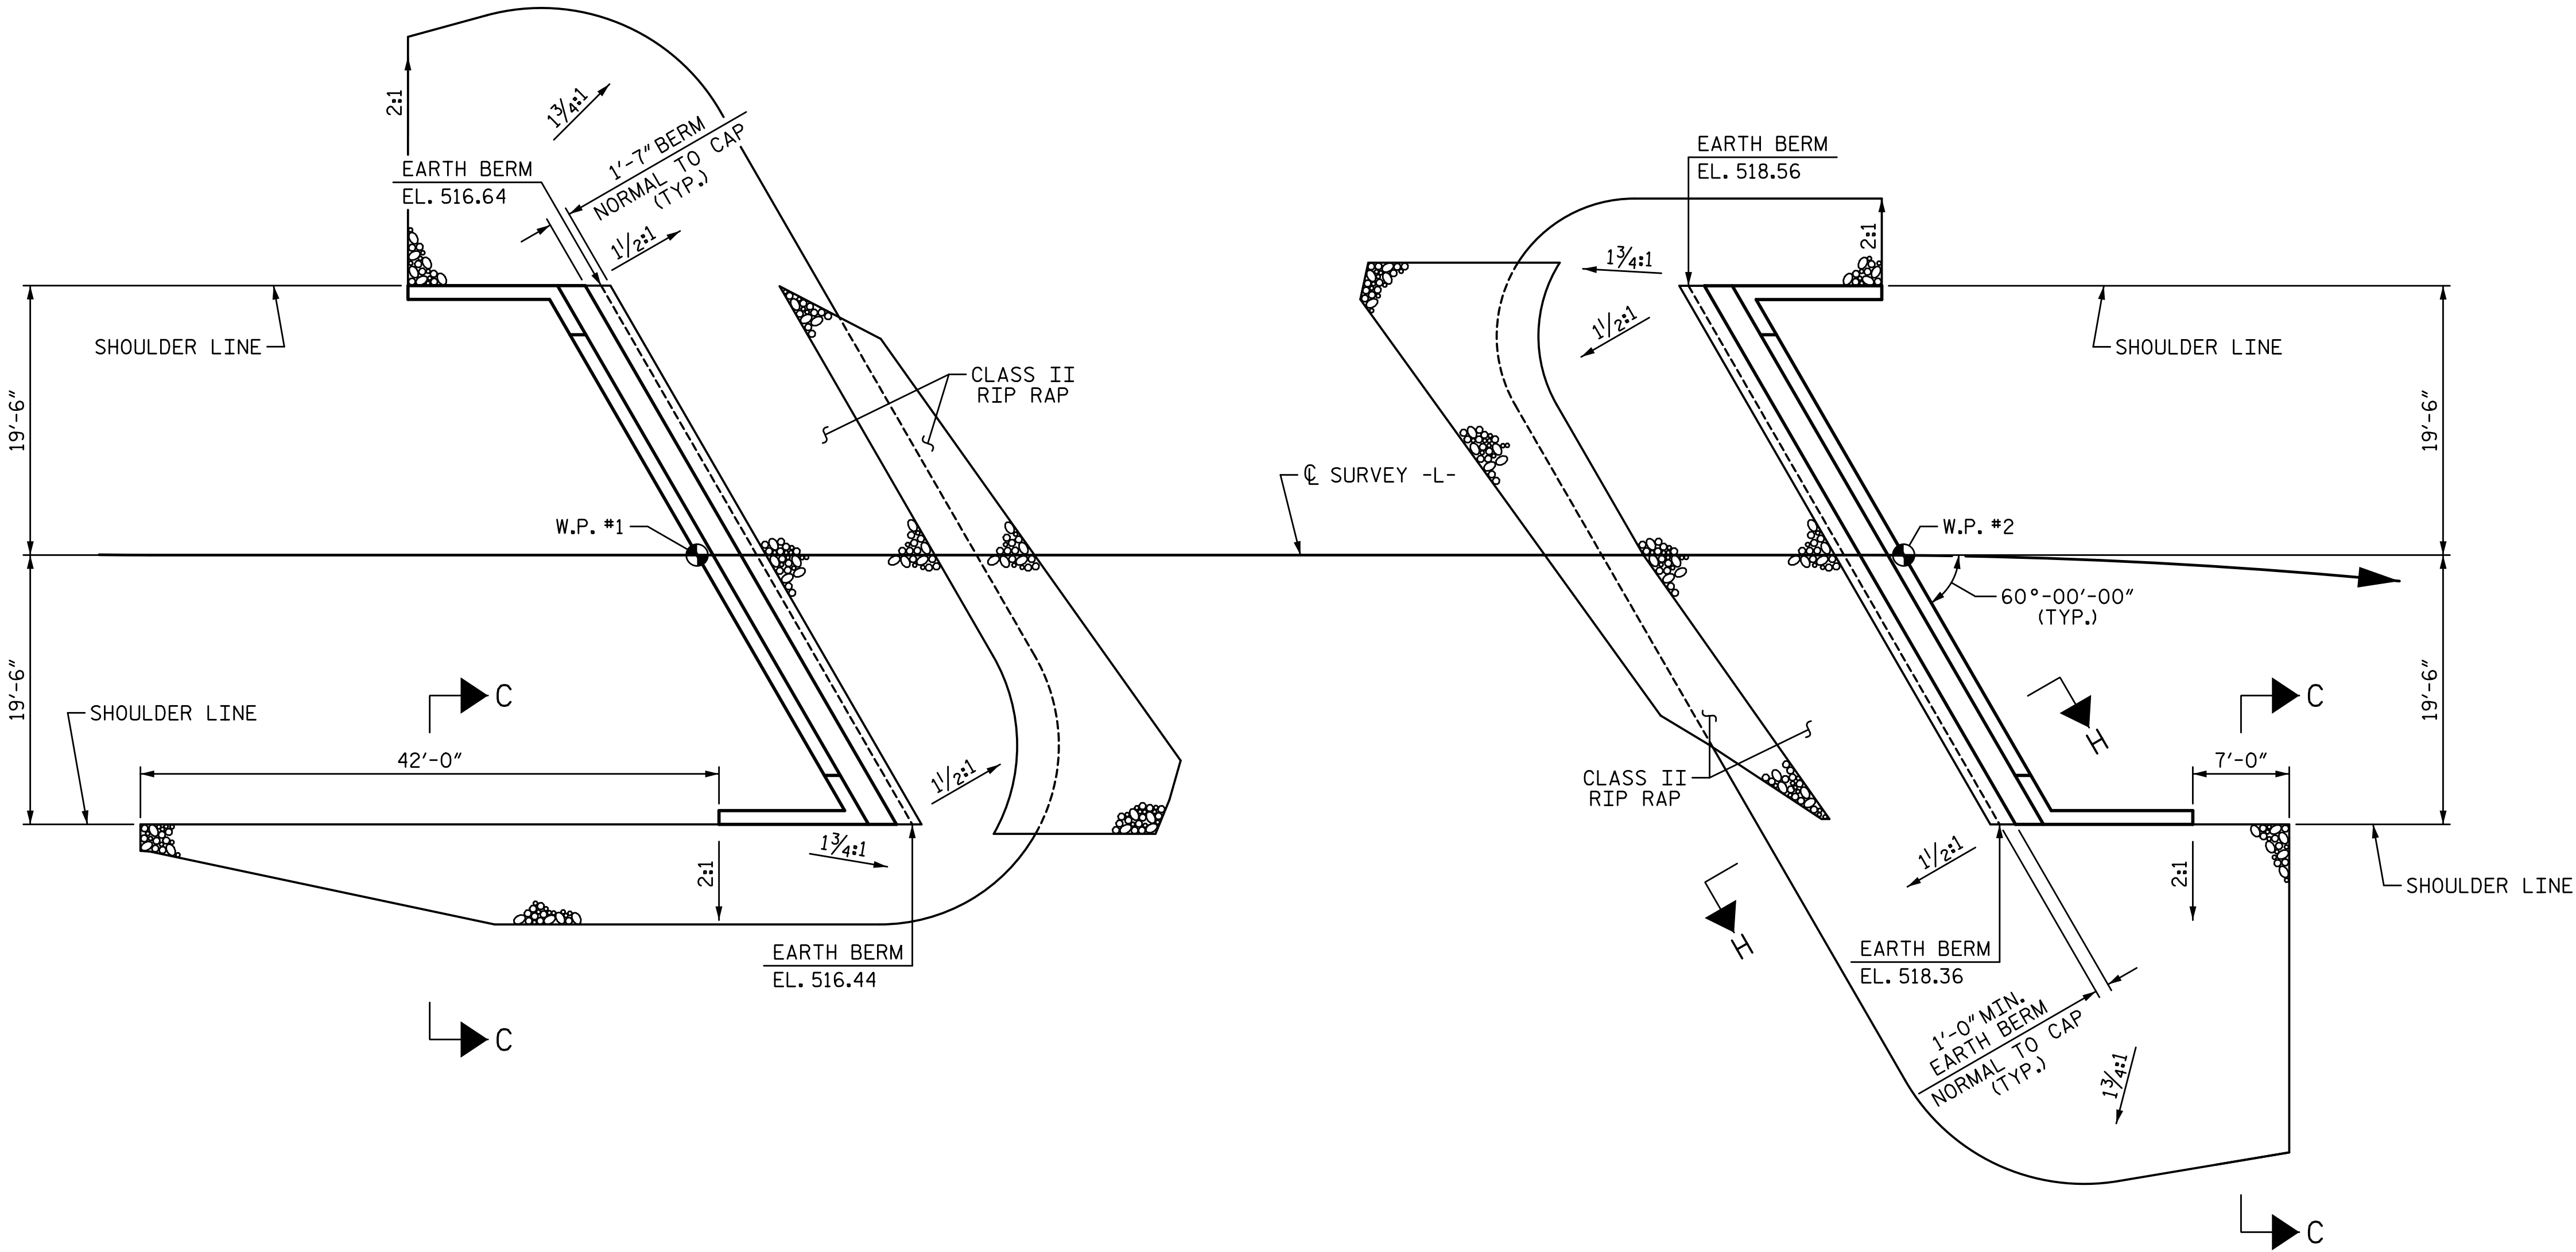


@ END BENT 1

@ END BENT 2


PLAN OF RIP RAP

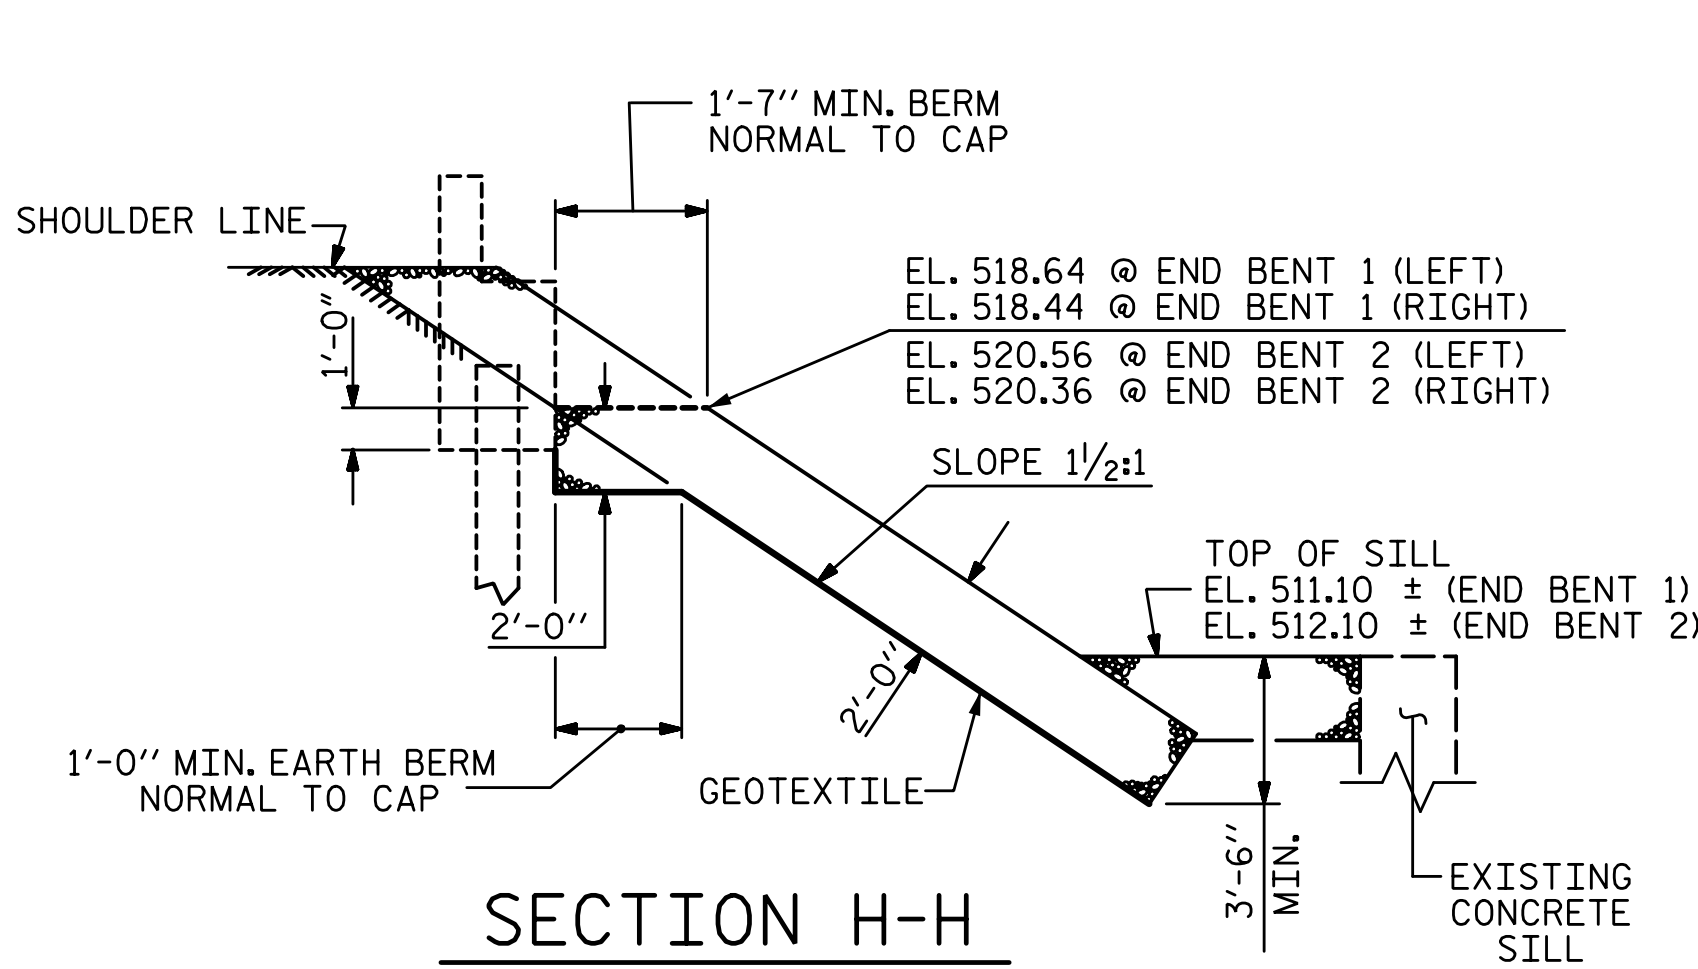

SECTION H-H

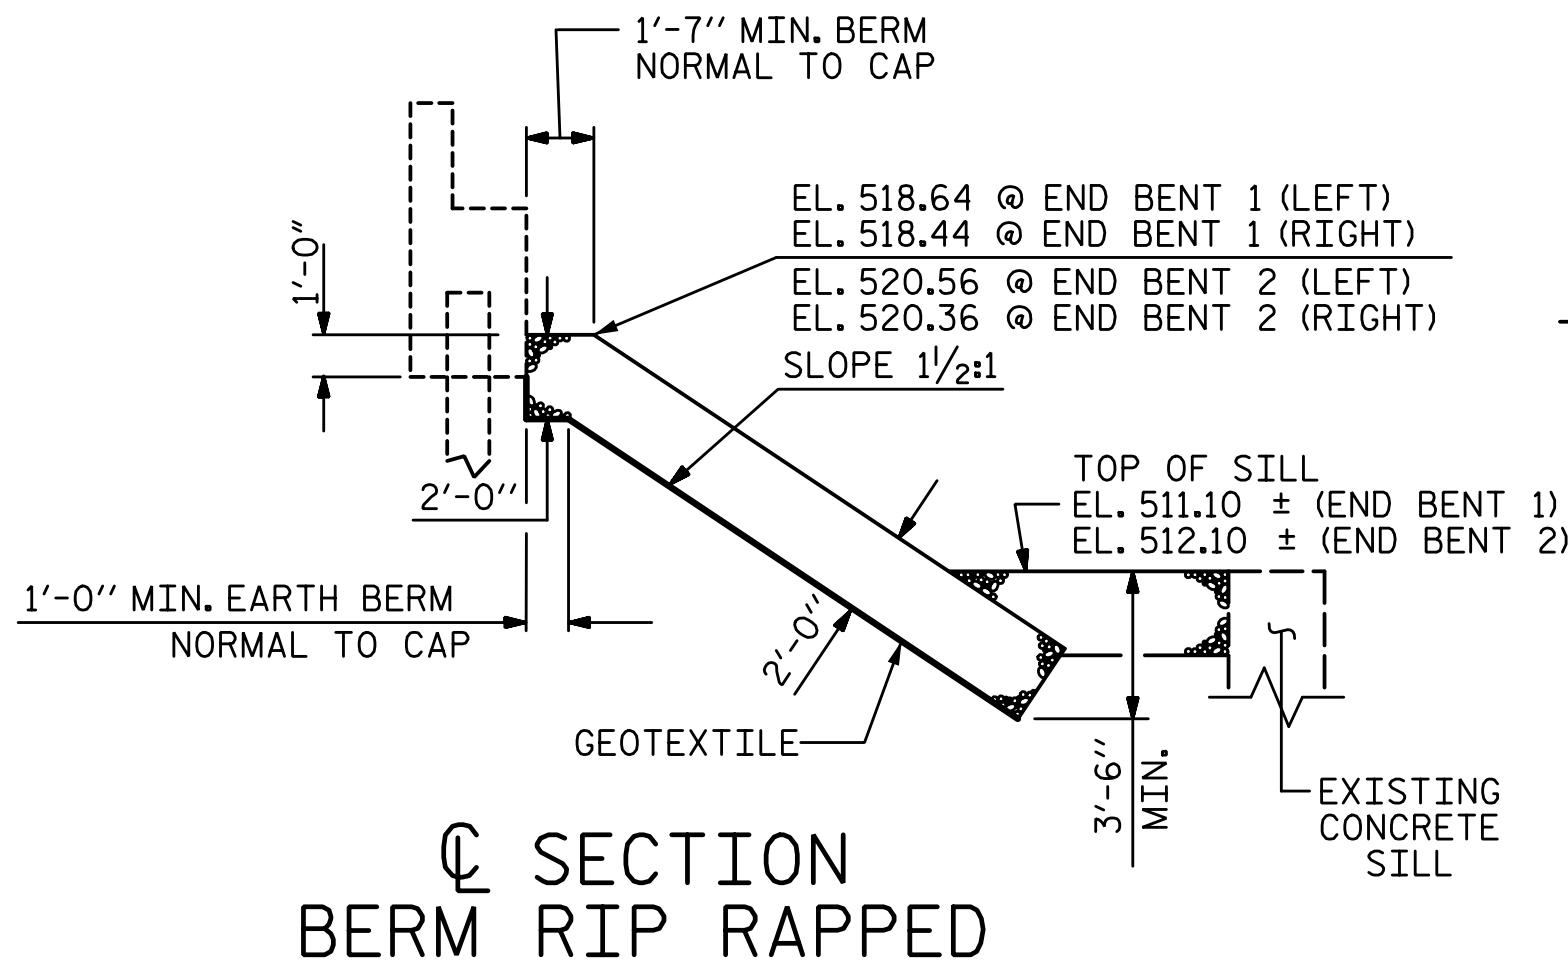


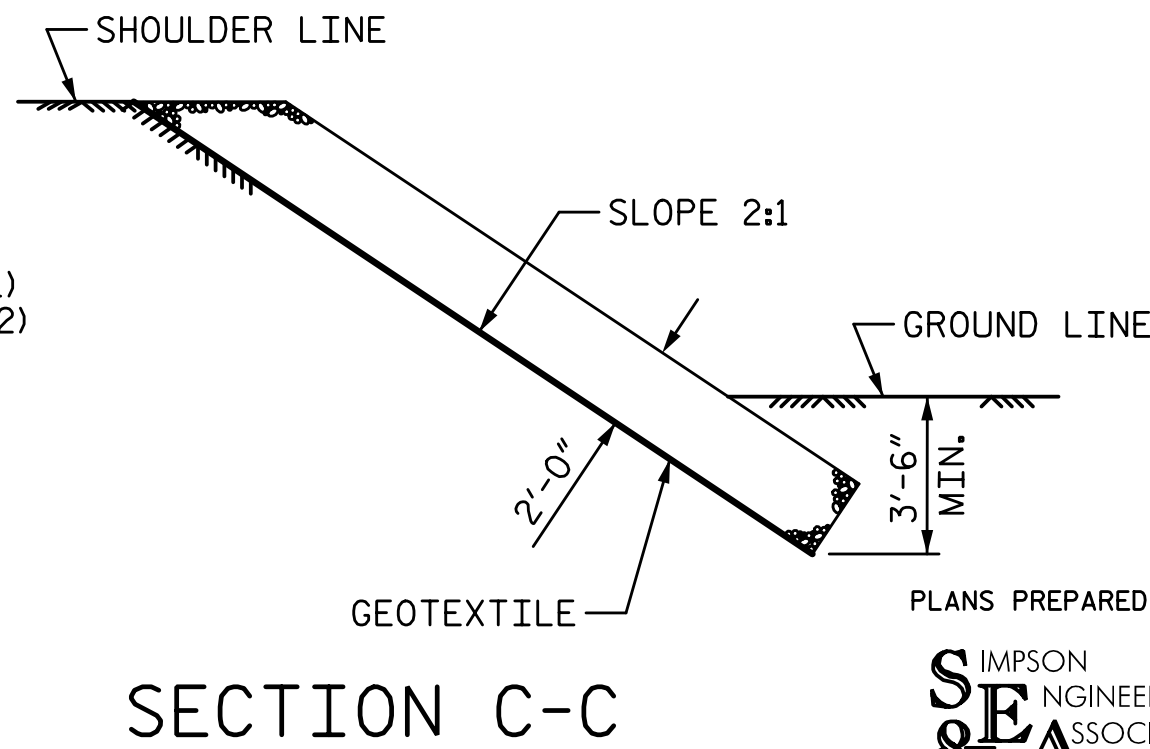

SECTION C-C


ESTIMATED QUANTITIES		
BRIDGE @ STA. 13+83.50 -L-	RIP RAP CLASS II (2'-0" THICK)	GEOTEXTILE FOR DRAINAGE
	TONS	SQUARE YARDS
END BENT 1	315	350
END BENT 2	310	345

PROJECT NO. 17BP.7.R.98
ORANGE COUNTY
STATION: 13+83.50 -L-

REVISIONS						SHEET NO. S-17
NO.	BY:	DATE:	NO.	BY:	DATE:	
1			3			TOTAL SHEETS
2			4			19


DRAWN BY: T. BANKOVICH DATE: 9-16
CHECKED BY: B.S. COX DATE: 9-16
DESIGN ENGINEER OF RECORD: B.S. COX DATE: 9-16

PLANS PREPARED BY:
SEA ENGINEERS & ASSOCIATES
5640 Dillard Drive
Suite 200
Cary, NC 27518
(919) 852-0468
(919) 852-0598 (Fax)
www.simpsonengr.com
LICENSURE NO. C-2521

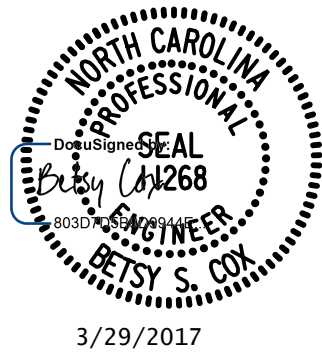


DOCUMENT NOT CONSIDERED FINAL
UNLESS ALL SIGNATURES COMPLETED

3/29/2017 7:54:55 AM G:\Projects\2015\Division 7 (Hatch Mot+)\17BP7R98 (Orange 189) (60 33BB 2BMR)\Structures\Drawings\Final\401.17BP7R98_SMJ_AS.dgn

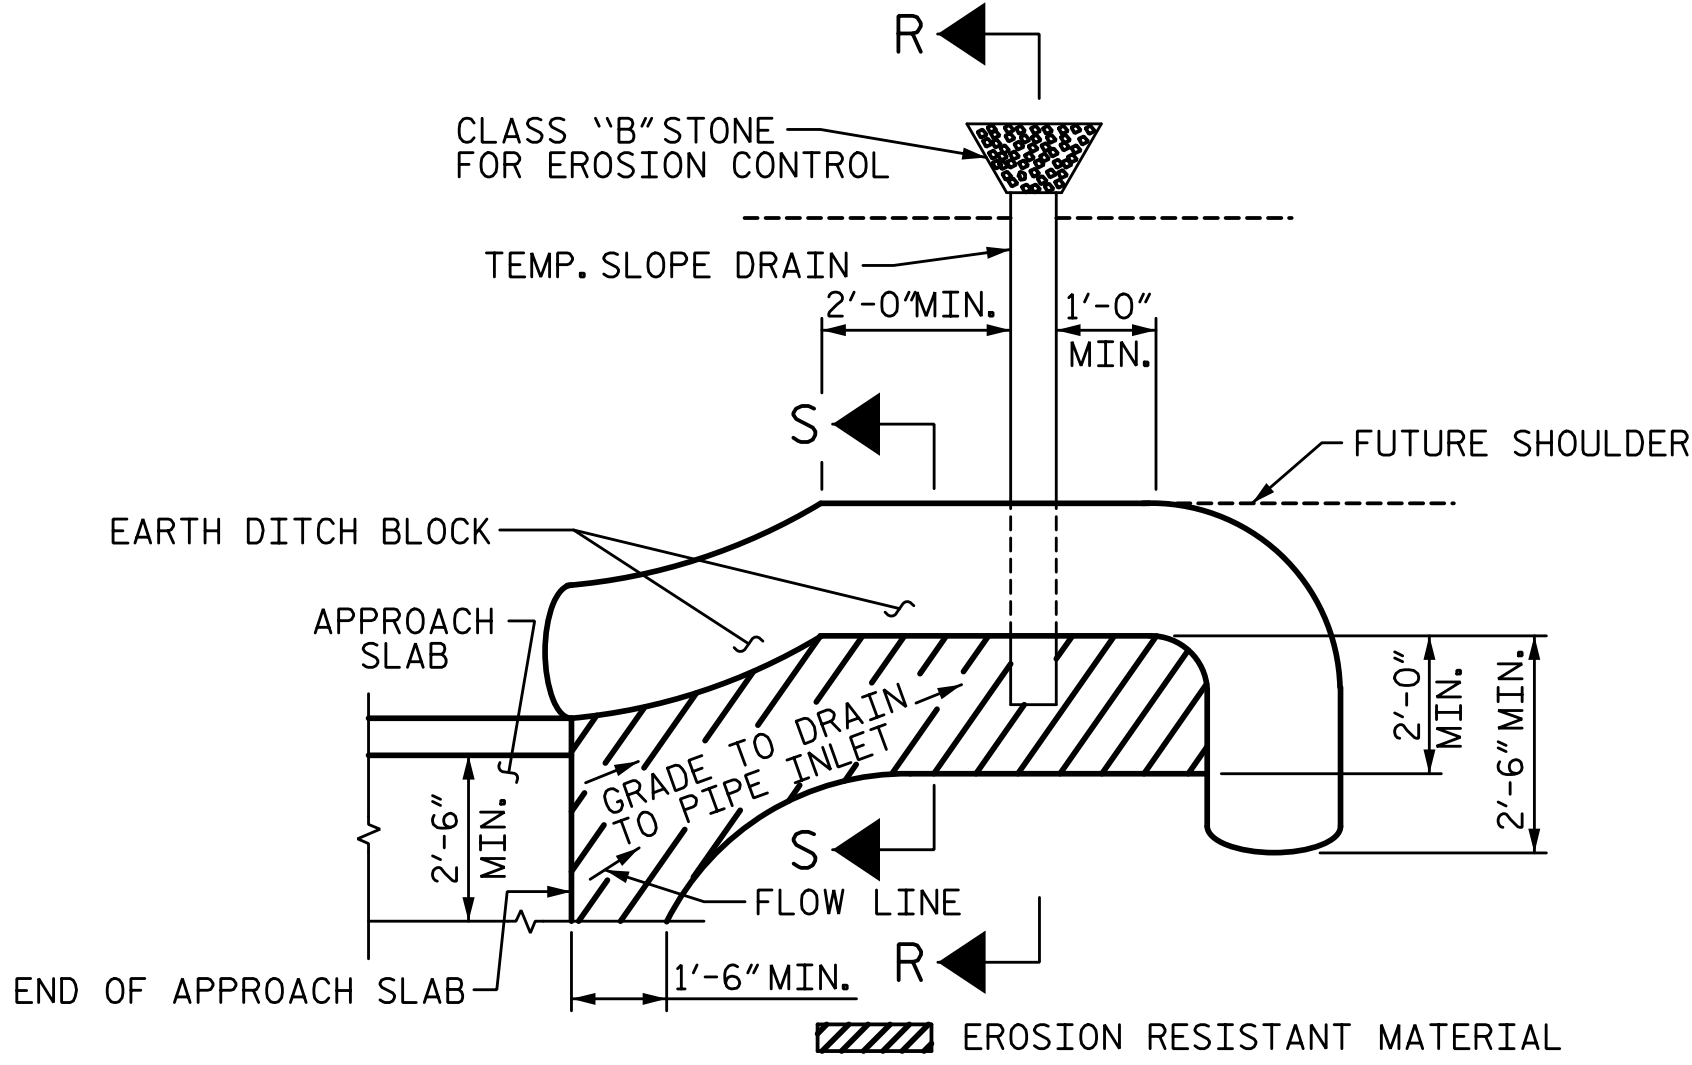

NOTE: IMMEDIATELY AFTER THE CONSTRUCTION OF THE APPROACH SLAB, THE CONTRACTOR SHALL PROVIDE TEMPORARY BERM AND SLOPE DRAIN. CONTRACTOR SHALL GRADE TO PIPE INLET AND PROVIDE EROSION RESISTANT MATERIAL AS SHOWN. THE EROSION RESISTANT MATERIAL SHALL BE EITHER 1) ASPHALT PLANT MIX, TYPE 1 OR TYPE 2, MIN. 2" DEPTH, 2) EROSION CONTROL MAT, OR 3) CONCRETE, AS DIRECTED BY THE ENGINEER. THE SLOPE DRAIN SHALL CONSIST OF A NON-PERFORATED TEMPORARY DRAINAGE PIPE, 12 INCHES IN DIAMETER.


PLAN VIEW

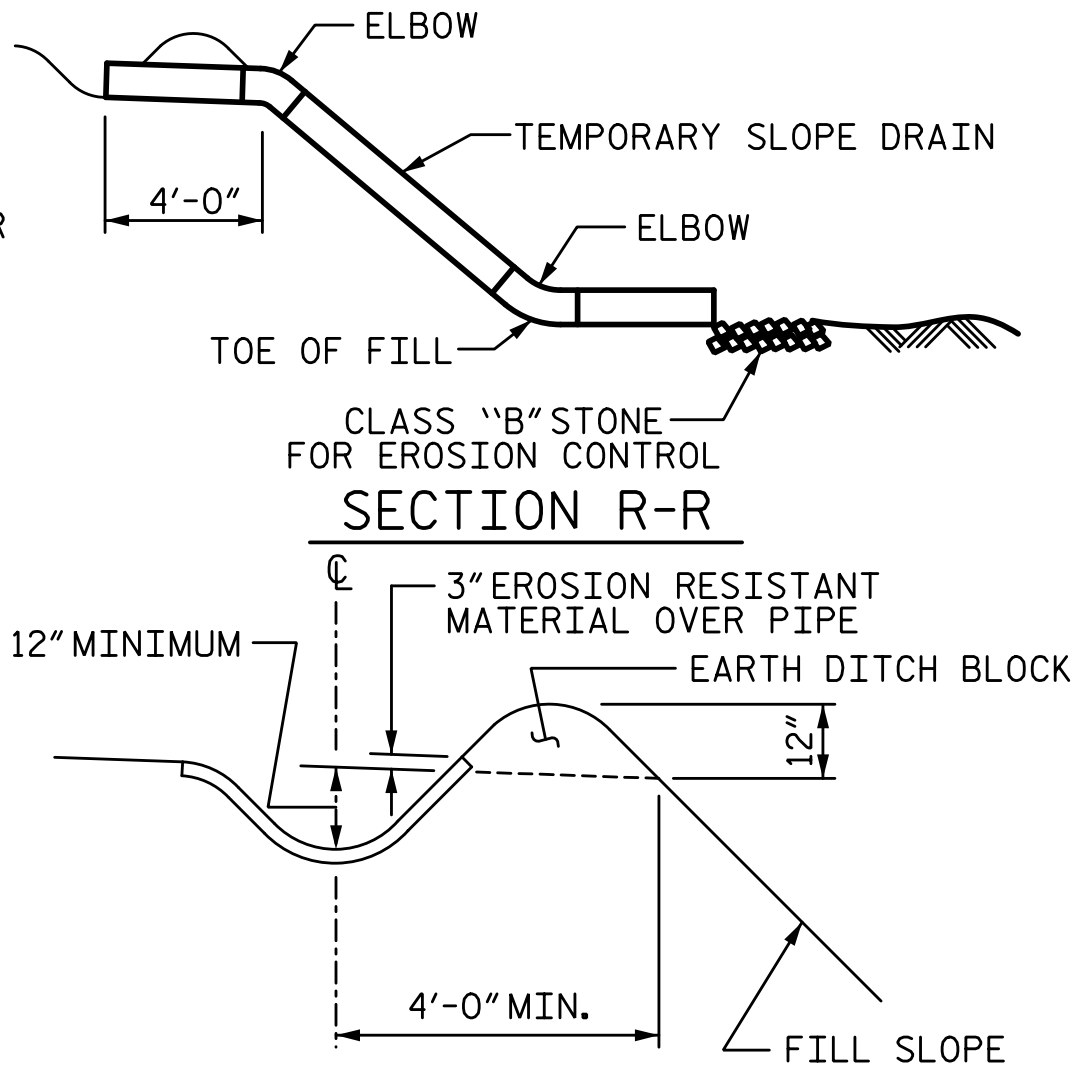

SECTION S-S

TEMPORARY BERM AND SLOPE DRAIN DETAILS

(TO BE USED WHEN SHOULDER BERM GUTTER IS REQUIRED)

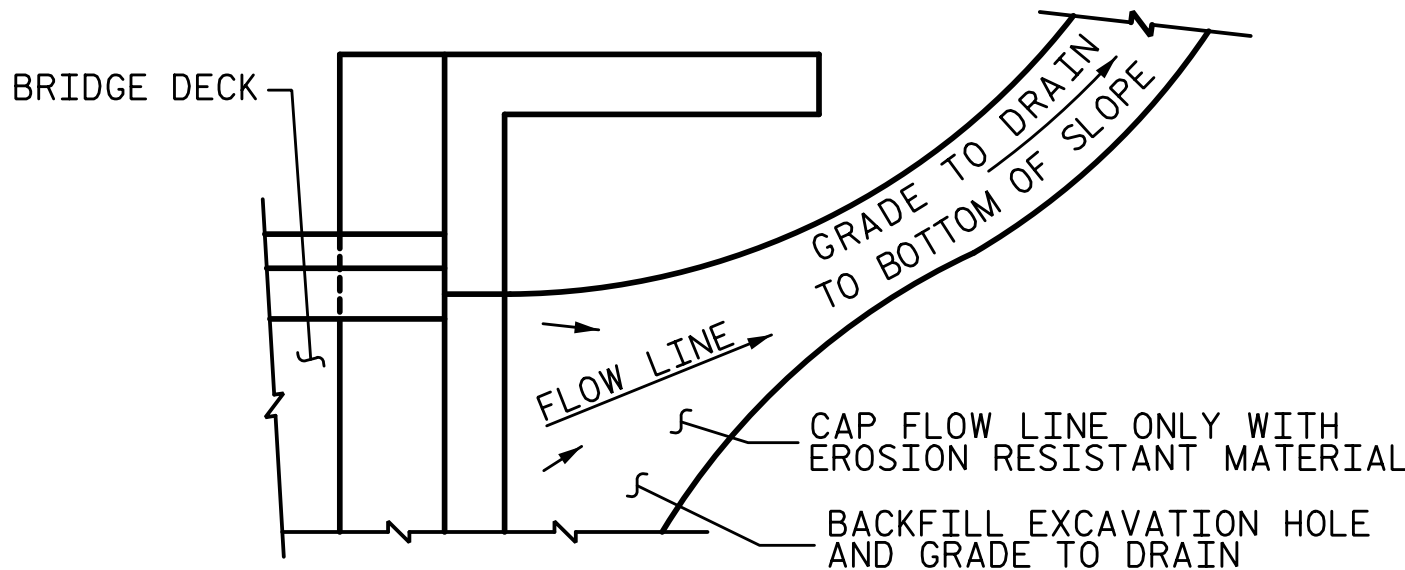

NOTE: IF THE APPROACH SLAB IS NOT CONSTRUCTED IMMEDIATELY AFTER THE BACKFILLING OF THE END BENT EXCAVATION, GRADE TO DRAIN TO THE BOTTOM OF THE SLOPE AND PROVIDE EROSION RESISTANT MATERIAL, SUCH AS FIBERGLASS ROVING OR AS DIRECTED BY THE ENGINEER TO PREVENT SOIL EROSION AND TO PROTECT THE AREA ADJACENT TO THE STRUCTURE. THE CONTRACTOR WILL BE REQUIRED TO REMOVE THESE MATERIALS PRIOR TO CONSTRUCTION OF THE APPROACH SLAB.

TEMPORARY DRAINAGE DETAIL

PROJECT NO. 17BP.7.R.98

ORANGE COUNTY

STATION: 13+83.50 -L-

SHEET 2 OF 2

STATE OF NORTH CAROLINA
DEPARTMENT OF TRANSPORTATION
RALEIGH

BRIDGE APPROACH SLAB DETAILS

STATE OF NORTH CAROLINA

DEPARTMENT OF TRANSPORTATION
RALEIGH

RALEIGH

REVISIONS

NO.	BY:	DATE:	NO.	BY:	DATE:
1			3		
2			4		

SHEET NO.

S-19

TOTAL

SHEETS

19

PLANS PREPARED BY:

SIMPSON
ENGINEERS
& ASSOCIATES
5640 Dillard Drive
Suite 200
Cary, NC 27518
(919) 852-0468
(919) 852-0598 (Fax)
www.simpsonengr.com

LICENSURE NO. C-2521



3/29/2017

DOCUMENT NOT CONSIDERED FINAL
UNLESS ALL SIGNATURES COMPLETED

3/29/2017 7:54:55 AM G:\Projects\2015\Division 7 (Hatch Mot-t)\17BP7R98 (Orange 189) (60 33BB 2BMR)\Structures\Drawings\Final\401.17BP7R98_SMJ_SJ.DGN

DESIGN DATA:

SPECIFICATIONS	- - - - -	A.A.S.H.T.O. (CURRENT)
LIVE LOAD	- - - - -	SEE PLANS
IMPACT ALLOWANCE	- - - - -	SEE A.A.S.H.T.O.
STRESS IN EXTREME FIBER OF		
STRUCTURAL STEEL - AASHTO M270 GRADE 36	-	20,000 LBS. PER SQ. IN.
- AASHTO M270 GRADE 50W	-	27,000 LBS. PER SQ. IN.
- AASHTO M270 GRADE 50	-	27,000 LBS. PER SQ. IN.
REINFORCING STEEL IN TENSION		
GRADE 60	- -	24,000 LBS. PER SQ. IN.
CONCRETE IN COMPRESSION	- - - - -	1,200 LBS. PER SQ. IN.
CONCRETE IN SHEAR	- - - - -	SEE A.A.S.H.T.O.
STRUCTURAL TIMBER - TREATED OR		
UNTREATED - EXTREME FIBER STRESS	- - - - -	1,800 LBS. PER SQ. IN.
COMPRESSION PERPENDICULAR TO GRAIN OF TIMBER	- - - -	375 LBS. PER SQ. IN.
EQUIVALENT FLUID PRESSURE OF EARTH	- - - - -	30 LBS. PER CU. FT.
		(MINIMUM)

MATERIAL AND WORKMANSHIP:

EXCEPT AS MAY OTHERWISE BE SPECIFIED ON PLANS OR IN THE SPECIAL PROVISIONS, ALL MATERIAL AND WORKMANSHIP SHALL BE IN ACCORDANCE WITH THE 2012 "STANDARD SPECIFICATIONS FOR ROADS AND STRUCTURES" OF THE N. C. DEPARTMENT OF TRANSPORTATION.

STEEL SHEET PILING FOR PERMANENT OR TEMPORARY APPLICATIONS SHALL BE HOT ROLLED.

CONCRETE:

UNLESS OTHERWISE REQUIRED ON PLANS, CLASS A CONCRETE SHALL BE USED FOR ALL PORTIONS OF ALL STRUCTURES WITH THE EXCEPTION THAT: CLASS AA CONCRETE SHALL BE USED IN BRIDGE SUPERSTRUCTURES, ABUTMENT BACKWALLS, AND APPROACH SLABS; AND CLASS B CONCRETE SHALL BE USED FOR SLOPE PROTECTION AND RIP RAP.

CONCRETE CHAMFERS:

UNLESS OTHERWISE NOTED ON THE PLANS, ALL EXPOSED CORNERS ON STRUCTURES SHALL BE CHAMFERED 3/4" WITH THE FOLLOWING EXCEPTIONS: TOP CORNERS OF CURBS MAY BE ROUNDED TO 1-1/2" RADIUS WHICH IS BUILT INTO CURB FORMS; CORNERS OF TRANSVERSE FLOOR EXPANSION JOINTS SHALL BE ROUNDED WITH A 1/4" FINISHING TOOL UNLESS OTHERWISE REQUIRED ON PLANS; AND CORNERS OF EXPANSION JOINTS IN THE ROADWAY FACES AND TOPS OF CURBS AND SIDEWALKS SHALL BE ROUNDED TO A 1/4" RADIUS WITH A FINISHING STONE OR TOOL UNLESS OTHERWISE REQUIRED ON PLANS.

DOWELS:

DOWELS WHEN INDICATED ON PLANS AS FOR CULVERT EXTENSIONS, SHALL BE EMBEDDED AT LEAST 12" INTO THE OLD CONCRETE AND GROUTED INTO PLACE WITH 1:2 CEMENT MORTAR.

STANDARD NOTES

ALLOWANCE FOR DEAD LOAD DEFLECTION, SETTLEMENT:
ETC. IN CASTING SUPERSTRUCTURES:

BRIDGES SHALL BE BUILT ON THE GRADE OR VERTICAL CURVE SHOWN ON PLANS. SLABS, CURBS AND PARAPETS SHALL CONFORM TO THE GRADE OR CURVE.
ALL DIMENSIONS WHICH ARE GIVEN IN SECTION AND ARE AFFECTED BY DEAD LOAD DEFLECTIONS ARE DIMENSIONS AT CENTER LINE OF BEARING UNLESS OTHERWISE NOTED ON PLANS. IN SETTING FORMS FOR STEEL BEAM BRIDGES AND PRESTRESSED CONCRETE GIRDER BRIDGES, ADJUSTMENTS SHALL BE MADE DUE TO THE DEAD LOAD DEFLECTIONS FOR THE ELEVATIONS SHOWN. WHERE BLOCKS ARE SHOWN OVER BEAMS FOR BUILDING UP TO THE SLAB, THE VERTICAL DIMENSIONS OF THE BLOCKS SHALL BE ADJUSTED BETWEEN BEARINGS TO COMPENSATE FOR DEAD LOAD DEFLECTIONS, VERTICAL CURVE ORDINATE, AND ACTUAL BEAM CAMBER. WHERE BOTTOM OF SLAB IS IN LINE WITH BOTTOM OF TOP FLANGES, DEPTH OF SLAB BETWEEN BEARINGS SHALL BE ADJUSTED TO COMPENSATE FOR DEAD LOAD DEFLECTION, VERTICAL CURVE ORDINATE, AND ACTUAL BEAM CAMBER.
IN SETTING FALSEWORK AND FORMS FOR REINFORCED CONCRETE SPANS, AN ALLOWANCE SHALL BE MADE FOR DEAD LOAD DEFLECTIONS, SETTLEMENT OF FALSEWORK, AND PERMANENT CAMBER WHICH SHALL BE PROVIDED FOR IN ADDITION TO THE ELEVATIONS SHOWN. AFTER REMOVAL OF THE FALSEWORK, THE FINISHED STRUCTURES SHALL CONFORM TO THE PROFILE AND ELEVATIONS SHOWN ON THE PLANS AND CONSTRUCTION ELEVATIONS FURNISHED BY THE ENGINEER.
DETAILED DRAWINGS FOR FALSEWORK OR FORMS FOR BRIDGE SUPERSTRUCTURE AND ANY STRUCTURE OR PARTS OF A STRUCTURE AS NOTED ON THE PLANS SHALL BE SUBMITTED TO THE ENGINEER FOR APPROVAL BEFORE CONSTRUCTION OF THE FALSEWORK OR FORMS IS STARTED.

REINFORCING STEEL:

ALL REINFORCING STEEL SHALL BE DEFORMED. DIMENSIONS RELATIVE TO PLACEMENT OF REINFORCING ARE TO CENTERS OF BARS UNLESS OTHERWISE INDICATED IN THE PLANS. DIMENSIONS ON BAR DETAILS ARE TO CENTERS OF BARS OR ARE OUT TO OUT AS INDICATED ON PLANS.
WIRE BAR SUPPORTS SHALL BE PROVIDED FOR REINFORCING STEEL WHERE INDICATED ON THE PLANS. WHEN BAR SUPPORT PIECES ARE PLACED IN CONTINUOUS LINES, THEY SHALL BE SO PLACED THAT THE ENDS OF THE SUPPORTING WIRES SHALL BE LAPPED TO LOCK LEGS ON ADJOINING PIECES.

STRUCTURAL STEEL:

AT THE CONTRACTOR'S OPTION, HE MAY SUBSTITUTE 7/8" Ø SHEAR STUDS FOR THE 3/4" Ø STUDS SPECIFIED ON THE PLANS. THIS SUBSTITUTION SHALL BE MADE AT THE RATE OF 3 - 7/8" Ø STUDS FOR 4 - 3/4" Ø STUDS, AND STUD SPACING CHANGES SHALL BE MADE AS NECESSARY TO PROVIDE THE SAME EQUIVALENT NUMBER OF 7/8" Ø STUDS ALONG THE BEAM AS SHOWN FOR 3/4" Ø STUDS BASED ON THE RATIO OF 3 - 7/8" Ø STUDS FOR 4 - 3/4" Ø STUDS. STUDS OF THE LENGTH SPECIFIED ON THE PLANS MUST BE PROVIDED. THE MAXIMUM SPACING SHALL BE 2'-0".
EXCEPT AT THE INTERIOR SUPPORTS OF CONTINUOUS BEAMS WHERE THE COVER PLATE IS IN CONTACT WITH BEARING PLATE, THE CONTRACTOR MAY, AT HIS OPTION, SUBSTITUTE FOR THE COVER PLATES DESIGNATED ON THE PLANS COVER PLATES OF THE EQUIVALENT AREA PROVIDED THESE PLATES ARE AT LEAST 5/16" IN THICKNESS AND DO NOT EXCEED A WIDTH EQUAL TO THE FLANGE WIDTH LESS 2" OR A THICKNESS EQUAL TO 2 TIMES THE FLANGE THICKNESS. THE SIZE OF FILLET WELDS SHALL CONFORM TO THE REQUIREMENTS OF THE CURRENT ANSI/AASHTO/AWS "BRIDGE WELDING CODE". ELECTROSLAG WELDING WILL NOT BE PERMITTED.
WITH THE SOLE EXCEPTION OF EDGES AT SURFACES WHICH BEAR ON OTHER SURFACES, ALL SHARP EDGES AND ENDS OF SHAPES AND PLATES SHALL BE SLIGHTLY ROUNDED BY SUITABLE MEANS TO A RADIUS OF APPROXIMATELY 1/16 INCH OR EQUIVALENT FLAT SURFACE AT A SUITABLE ANGLE PRIOR TO PAINTING, GALVANIZING, OR METALLIZING.

HANDRAILS AND POSTS:

METAL STANDARDS AND FACES OF THE CONCRETE END POSTS FOR THE METAL RAIL SHALL BE SET NORMAL TO THE GRADE OF THE CURB, UNLESS OTHERWISE SHOWN ON PLANS. THE METAL RAIL AND TOPS OF CONCRETE POSTS USED WITH THE ALUMINUM RAIL SHALL BE BUILT PARALLEL TO THE GRADE OF THE CURB.
METAL HANDRAILS SHALL BE IN ACCORDANCE WITH THE PLANS. RAILS SHALL BE AS MANUFACTURED FOR BRIDGE RAILING. CASTINGS SHALL BE OF A UNIFORM APPEARANCE. FINIS AND OTHER DEFORMATIONS RESULTING FROM CASTING OR OTHERWISE SHALL BE REMOVED IN A MANNER SO THAT A UNIFORM COLORING OF THE COMPLETED CASTING SHALL BE OBTAINED. CASTINGS WITH DISCOLORATIONS OR OF NON-UNIFORM COLORING WILL NOT BE ACCEPTED. CERTIFIED MILL REPORTS ARE REQUIRED FOR METAL RAILS AND POSTS.

SPECIAL NOTES:

GENERALLY, IN CASE OF DISCREPANCY, THIS STANDARD SHEET OF NOTES SHALL GOVERN OVER THE SPECIFICATIONS, BUT THE REMAINDER OF THE PLANS SHALL GOVERN OVER NOTES HEREON, AND SPECIAL PROVISIONS SHALL GOVERN OVER ALL. SEE SPECIFICATIONS ARTICLE 105-4.